


T34S R6W South Half Northwest Quarter and North Half Southwest Quarter Section 28

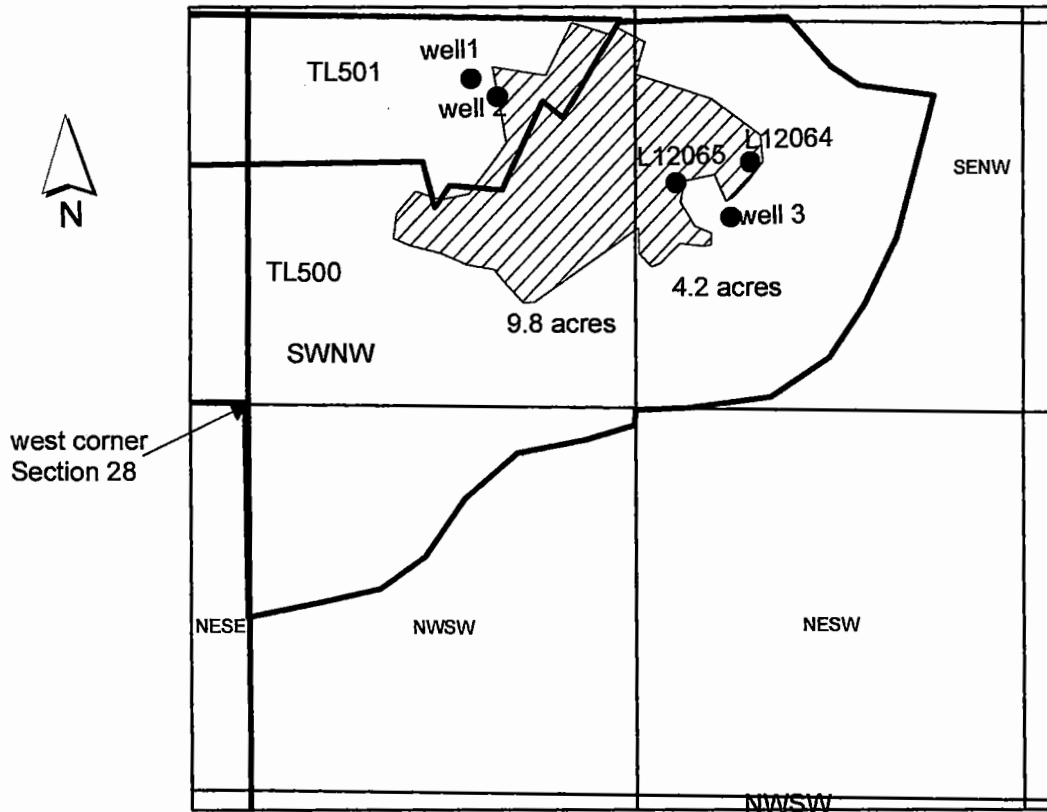

1 inch = 660 feet

Well 1 is located approximately 766 ft west and 1118 ft north of the west corner of Section 28.

Well 2 is located approximately 861 ft west and 1047 ft north of the west corner of Section 28.

Well 3 is located approximately 1665 ft west and 616 ft north of the west corner of Section 28.

Well L12065 is located approximately 1479 ft west and 791 ft north of the west corner of Section 28.

Well L12064 is located approximately 1731 ft west and 816 ft north of the west corner of Section 28.

RECEIVED BY OWRD

JAN 23 2017

SALEM, OR

G-18442