


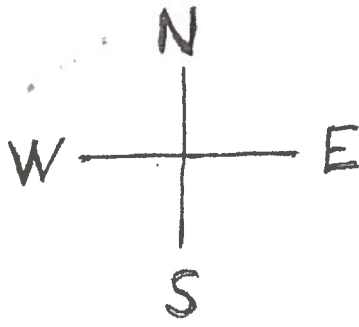

T-5S R-1E Sec 8

Sconce Rd

NENE Corner

POD ★

1" = 200 feet

Tax Map 51E08

1/4-1/4 Sec NENE
17 Ac Total

Tax Lot
00105
15.4 Ac

Tax Lot
00106
1.6 Ac

Needy Rd

NENE
SENE

★
1380 feet South - 500 feet West from
NE Corner of Section 8

Tax Lot
00100

RECEIVED

OCT 25 2017

OWRD