


08 4W 25

1288354

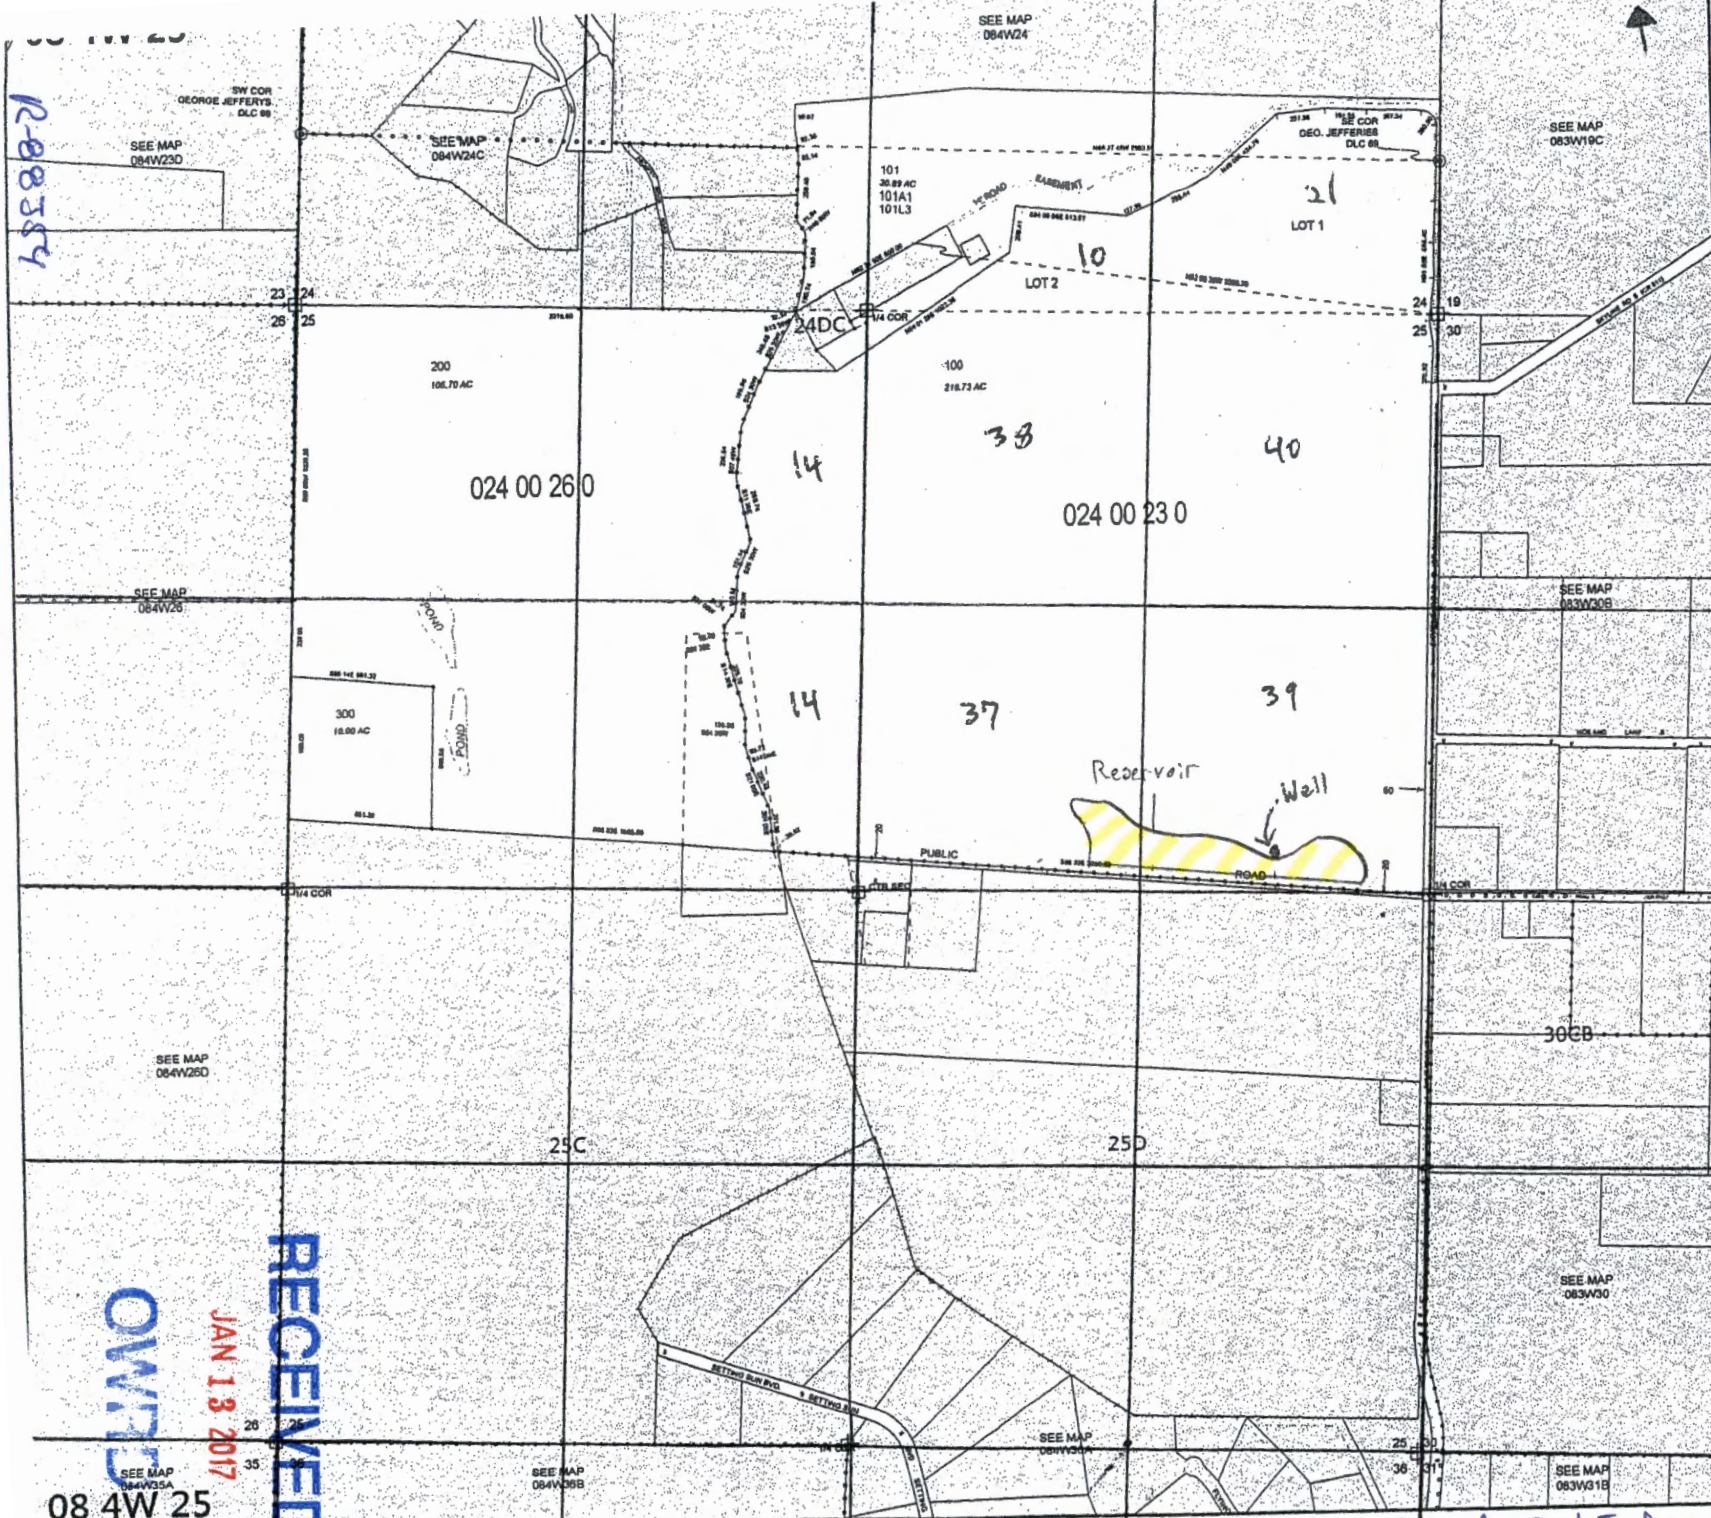

MARION COUNTY, OREGON
 SEC 25 T8S R4W W.M.
 SCALE 1" = 400'

- LEGEND**
- LINE TYPES**
- Taxlot Boundary
 - Road Right-of-Way
 - Railroad Right-of-Way
 - Private Road ROW
 - Subdivision/Plat Bndry
 - Waterline - Taxlot Bndry
 - Historical Boundary
 - Easement
 - Railroad Centerline
 - Taxcode Line
 - Map Boundary
 - Waterline - Non Bndry
- SYMBOL TYPES**
- Survey Monument
 - Road Station
 - DLC Corner
 - 1/16TH Section Cor.
 - 1/4 Section Cor.
 - Section Corner

NUMBERS
 Tax Code Number
 000 00 00 0

NOTES
 Tick Marks: If a tick mark is indicated on the end of a line, then the dimension goes to the tick mark. This is used when dimensions extend into public right-of-ways.

CANCELLED NUMBERS

--	--	--

DISCLAIMER: THIS MAP WAS PREPARED FOR ASSESSMENT PURPOSES ONLY



FOR ADDITIONAL MAPS VISIT OUR WEBSITE AT www.co.marion.or.us

PLOT DATE: 10/8/2015

08 4W 25

JAN 13 2017

RECEIVED

08 4W 25

Well located 130' N and 1500' E of center of section 25
 Reservoir spillway is located 30' N and 1500' E of center of section 25