


Douglas Ryedam Application

Township 1 N Range 40 E

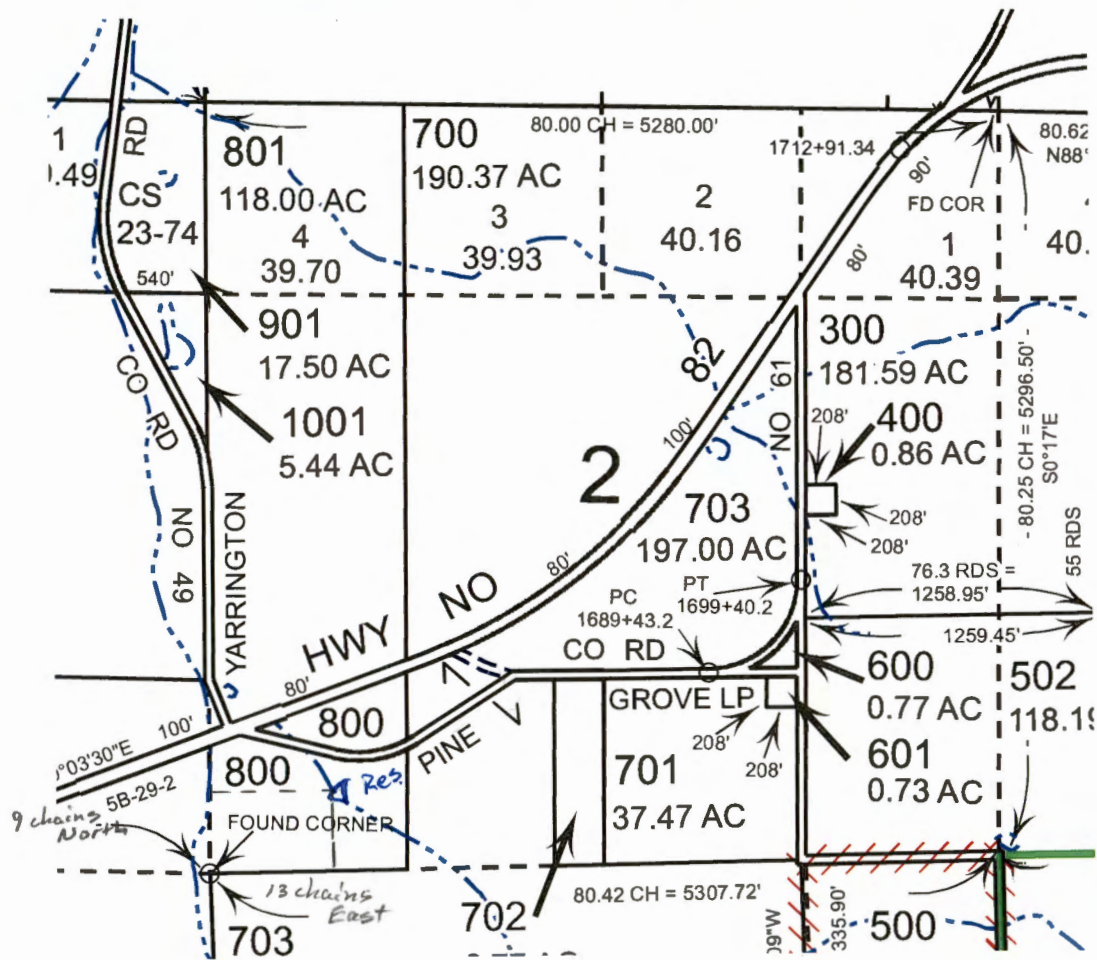


RECEIVED BY OWRD

JAN 27 2017

SALEM, OR

Douglas Rydman Application

Township 1 N Range 40 E

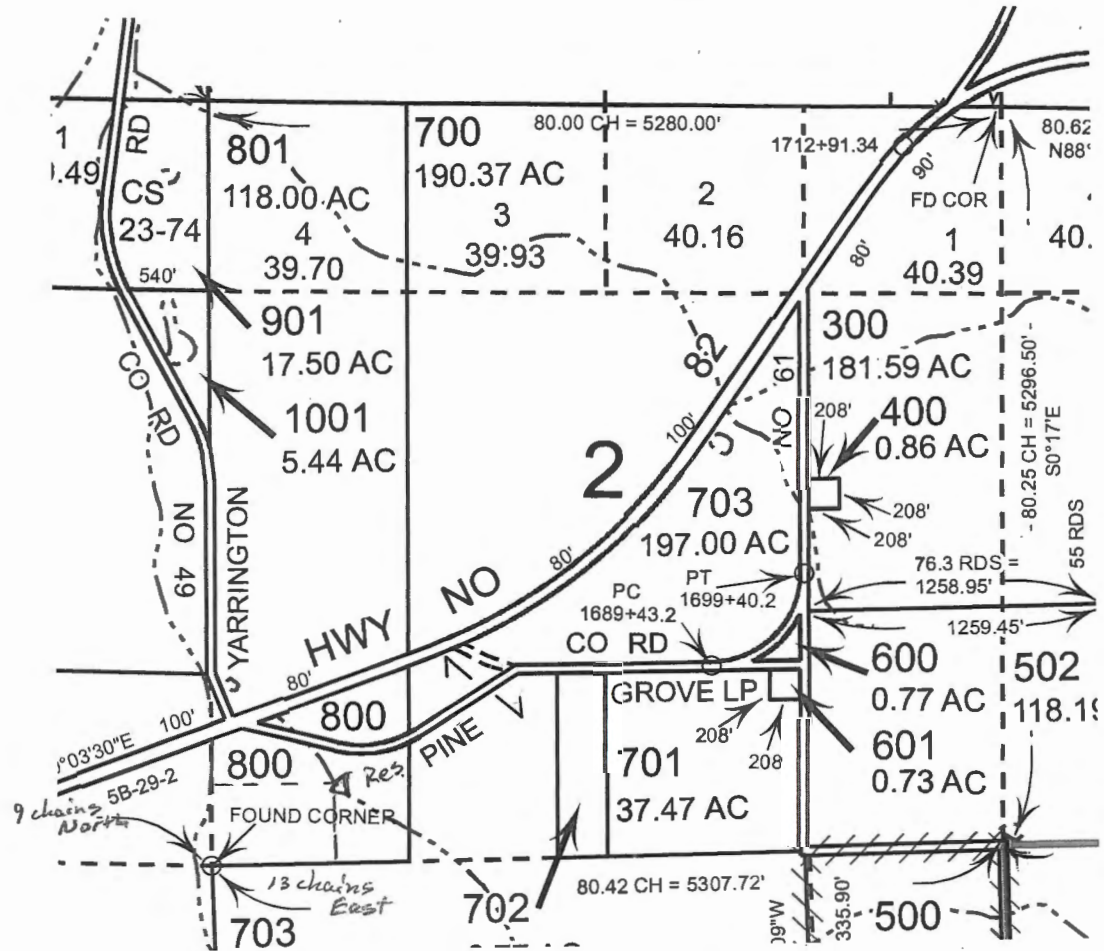

Scale 1" = 1320'

RECEIVED BY OWRD

JAN 27 2017

SALEM, OR

D-00761

Doug Rysdam Property

Proposed Pond
45.589174, -117.785033



Map created and copyrighted by Christopher Moats
Union Soil and Water Conservation District 18 OCT 2016

The Union Soil and Water Conservation District makes
no representation or warranties, implied or expressed,
concerning the accuracy, completeness, reliability, or
suitability for any purpose of the information and data
contained on this document.

Legend

 Parcels

100

Yards


RECEIVED BY OWRD

JAN 27 2017

SALEM, OR

N

Doug Rysdam
-117.784372, 45.590379

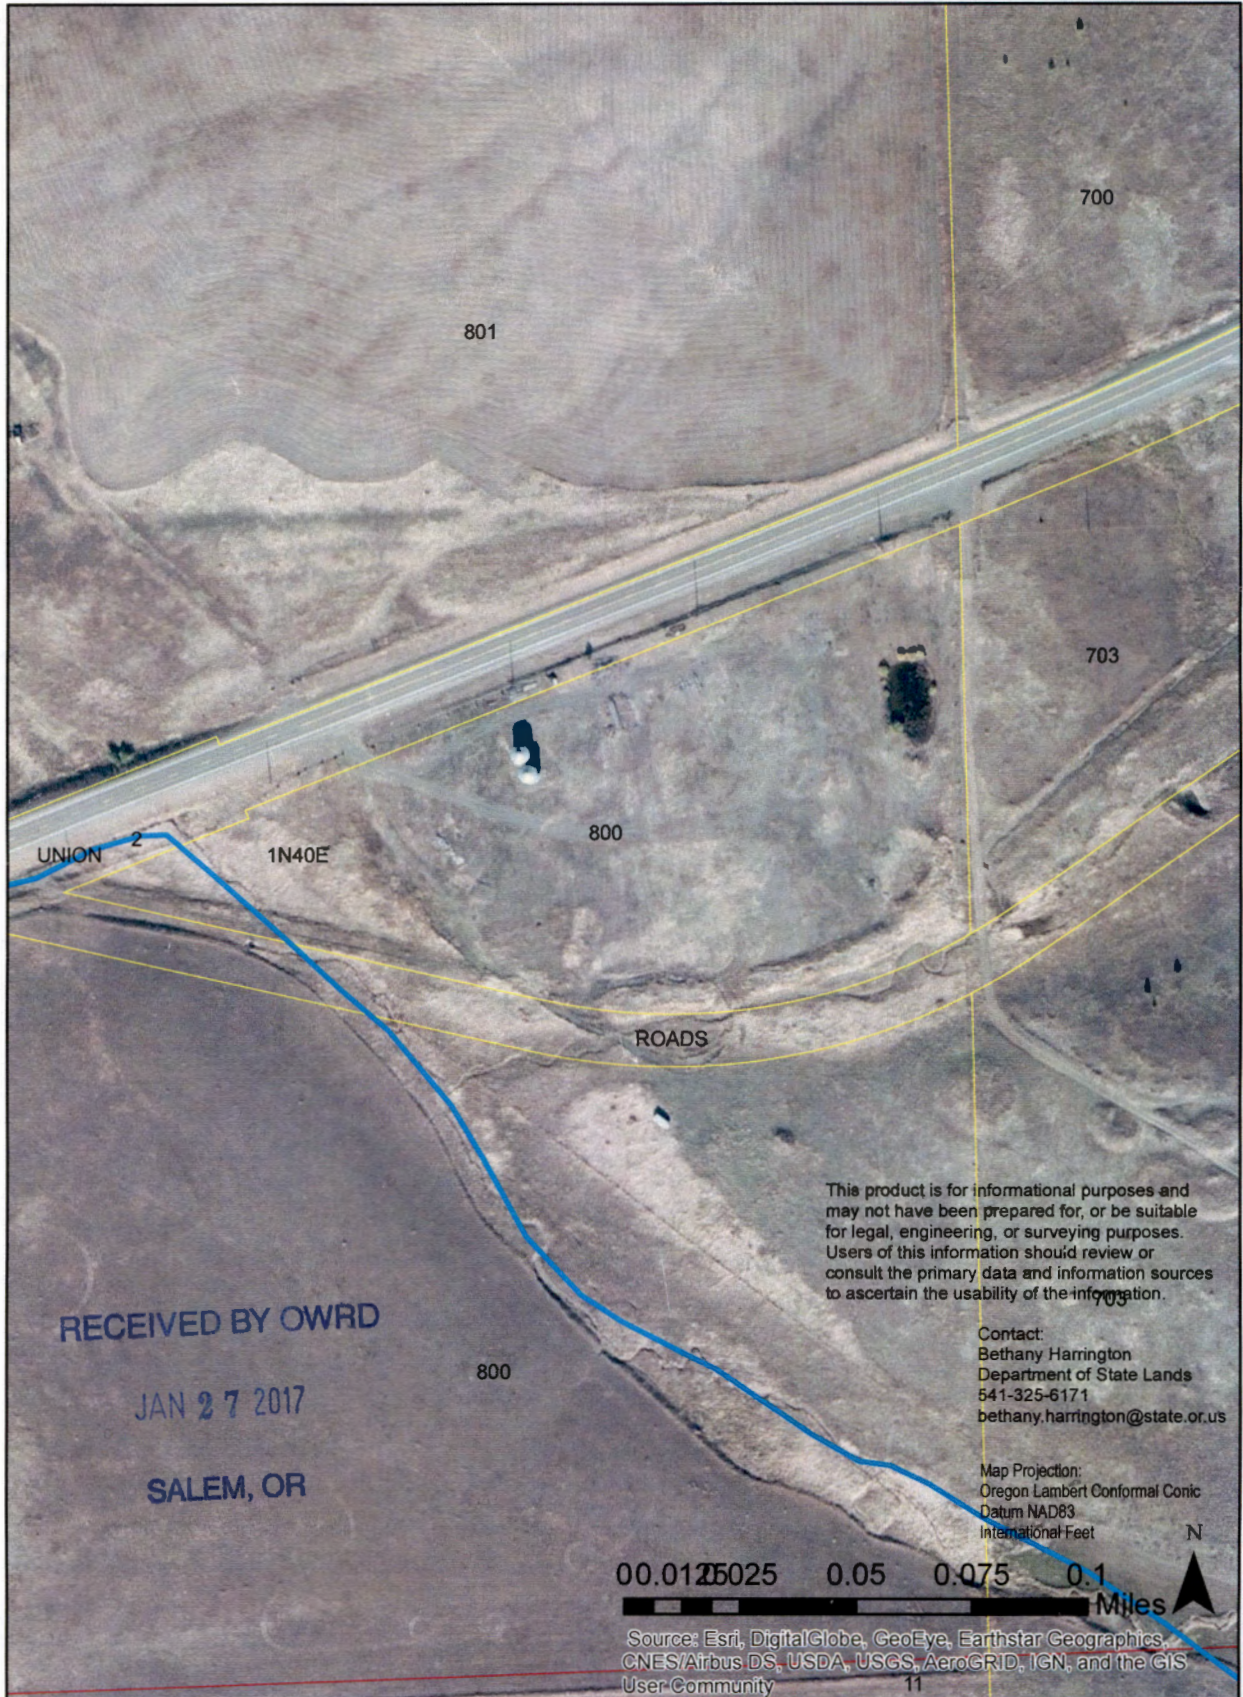

Date: 10/24/2016

R-88361

Doug Rysdam

71749 Yarrington Rd
Elgin

Legend

 45.590379, -117.784372
1 mi. off 82nd St. House

 45.590379, -117.784372

Google Earth

200 ft

