


T39S R8W Southwest Quarter Section 34

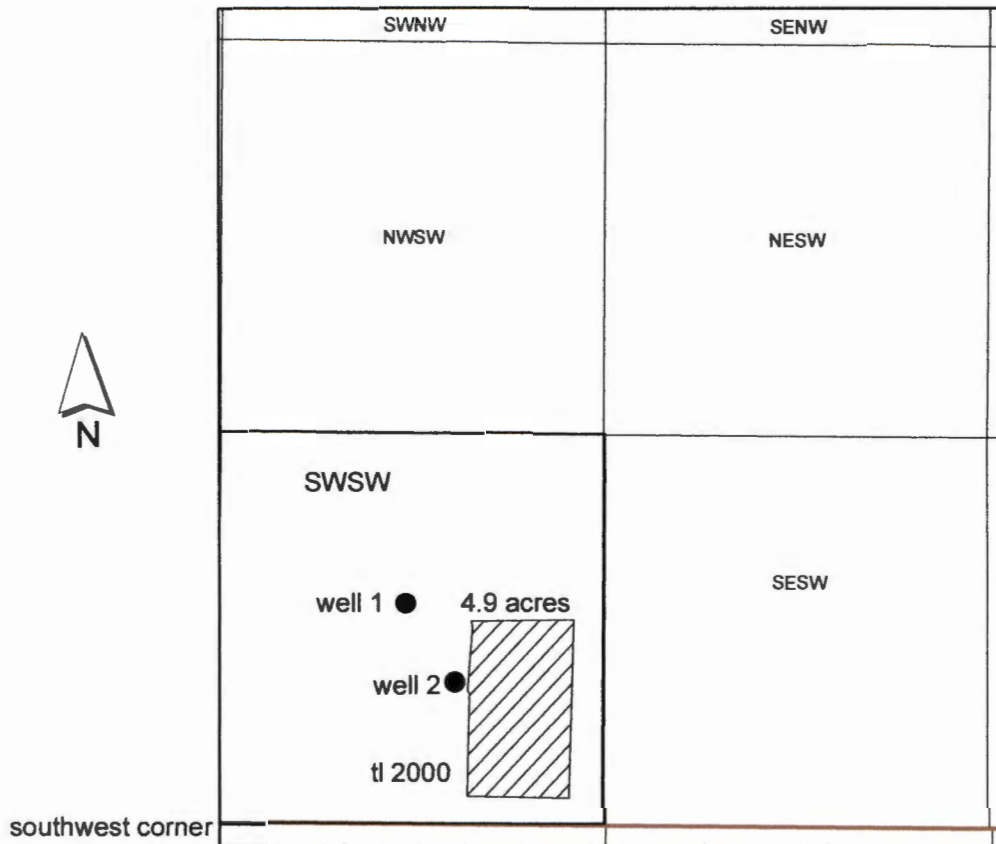

1 inch = 660 feet

Well 1 (existing well) is located approximately 771 ft north and 634 ft east from the southwest corner Section 34, according to the landowner.

RECEIVED BY OWRD

Well 2 will be located approximately 499 ft north and 813 ft east from the southwest corner of Section 34, according to the landowner.

FEB 06 2017

SALEM, OR

RECEIVED BY OWRD

NOV 21 2016

SALEM, OR

G-18452

