


T35S R6W Southeast Section 34

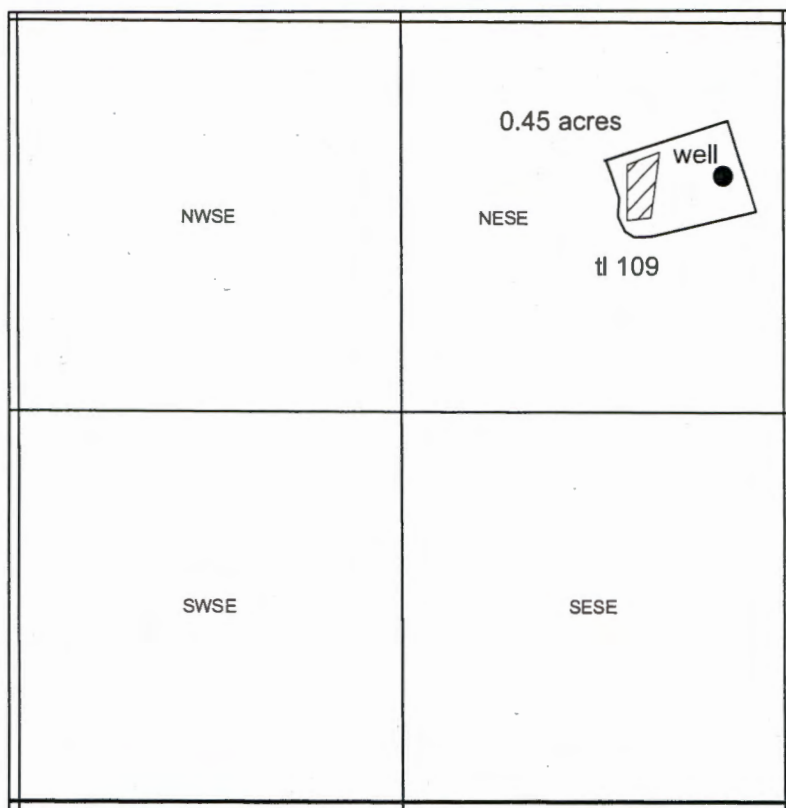

East corner Section 34

1 inch = 660 feet

The well is located approximately 210 ft west and 525 ft south from the east corner of Section 34, according to the landowner.

RECEIVED BY OWRD

FEB 17 2017

SALEM, OR

G-18458