

WATER RIGHTS

LOCATED IN
THE SE 1/4 OF SECTION 25, T2S, R4E., W.M.
CLACKAMAS COUNTY, OREGON


DATE FEBRUARY 5, 2017 SCALE 1" = 200'



PRIMARY



SECONDARY

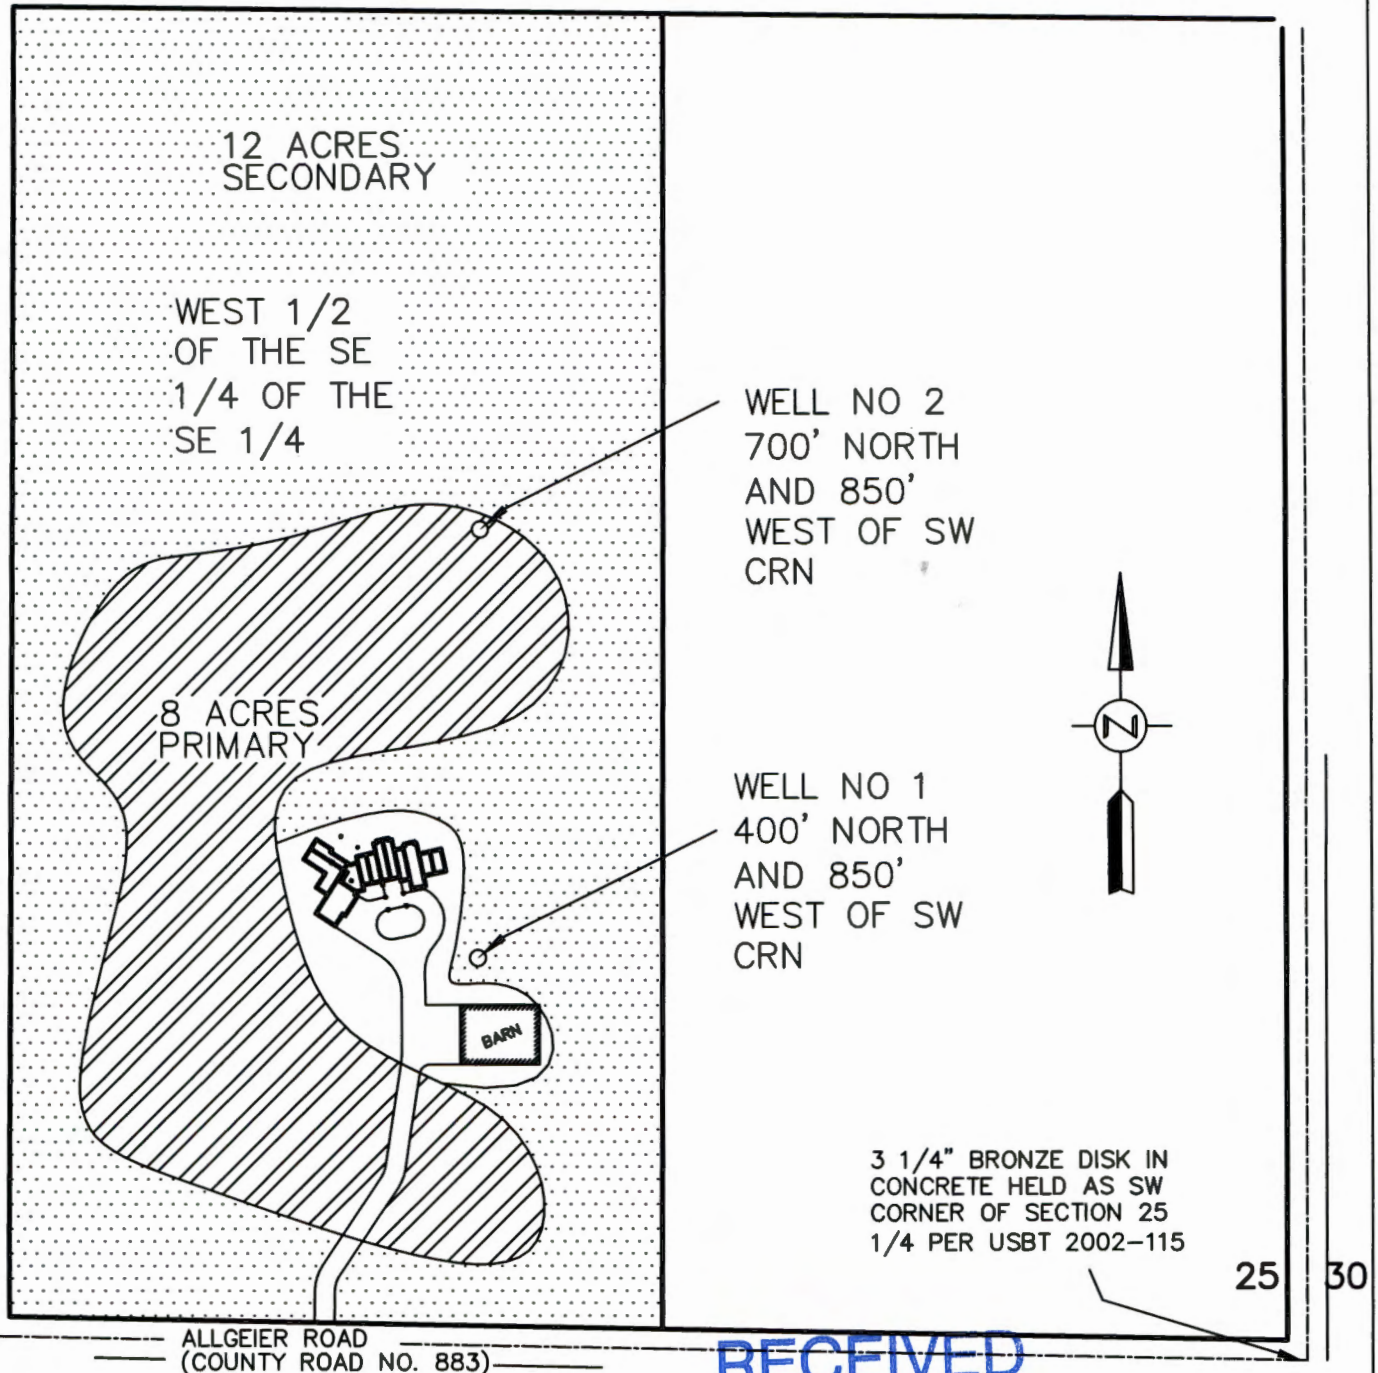

ALLGEIER ROAD
(COUNTY ROAD NO. 883)

RECEIVED

MAR 01 2017

36 31


G-1047

OWRD

WATER RIGHTS

LOCATED IN
THE SE 1/4 OF SECTION 25, T2S, R4E., W.M.
CLACKAMAS COUNTY, OREGON

DATE FEBRUARY 5, 2017 SCALE 1" = 200'

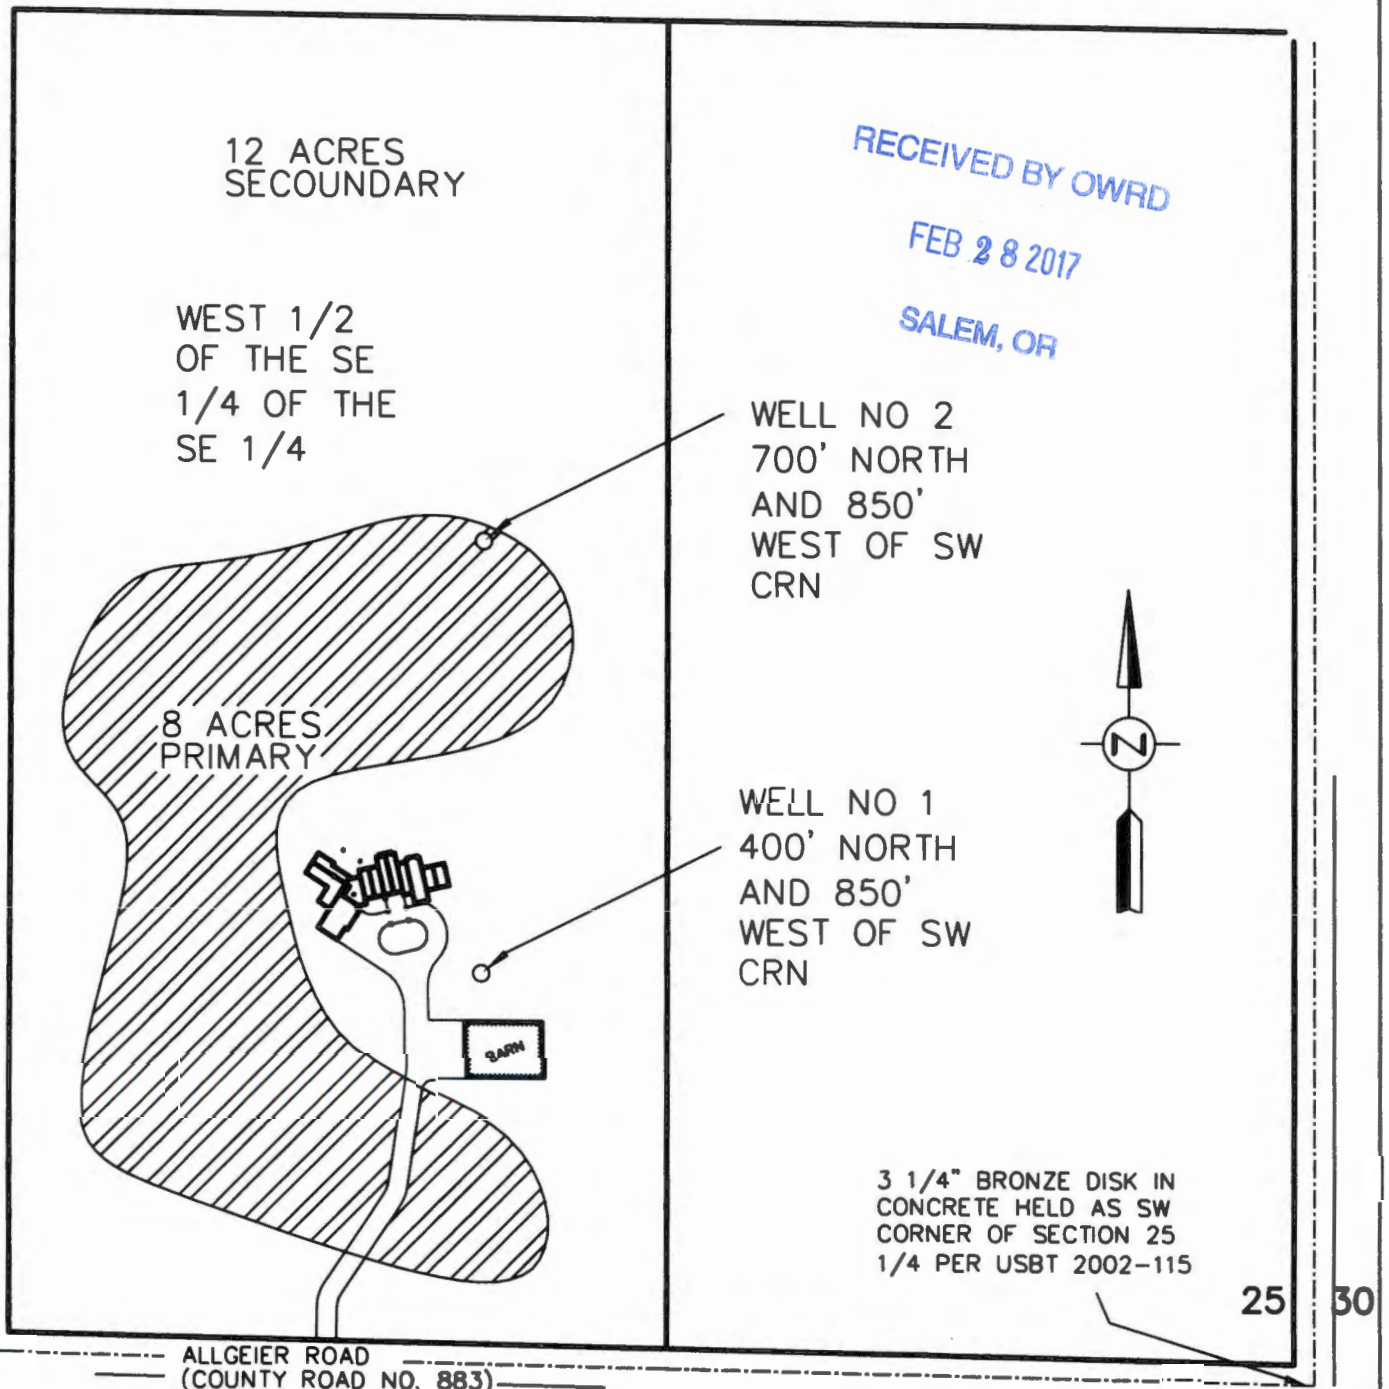



G-18474

WATER RIGHTS

LOCATED IN
THE SE 1/4 OF SECTION 25, T2S, R4E., W.M.
CLACKAMAS COUNTY, OREGON

DATE FEBRUARY 5, 2017 SCALE 1" = 200'

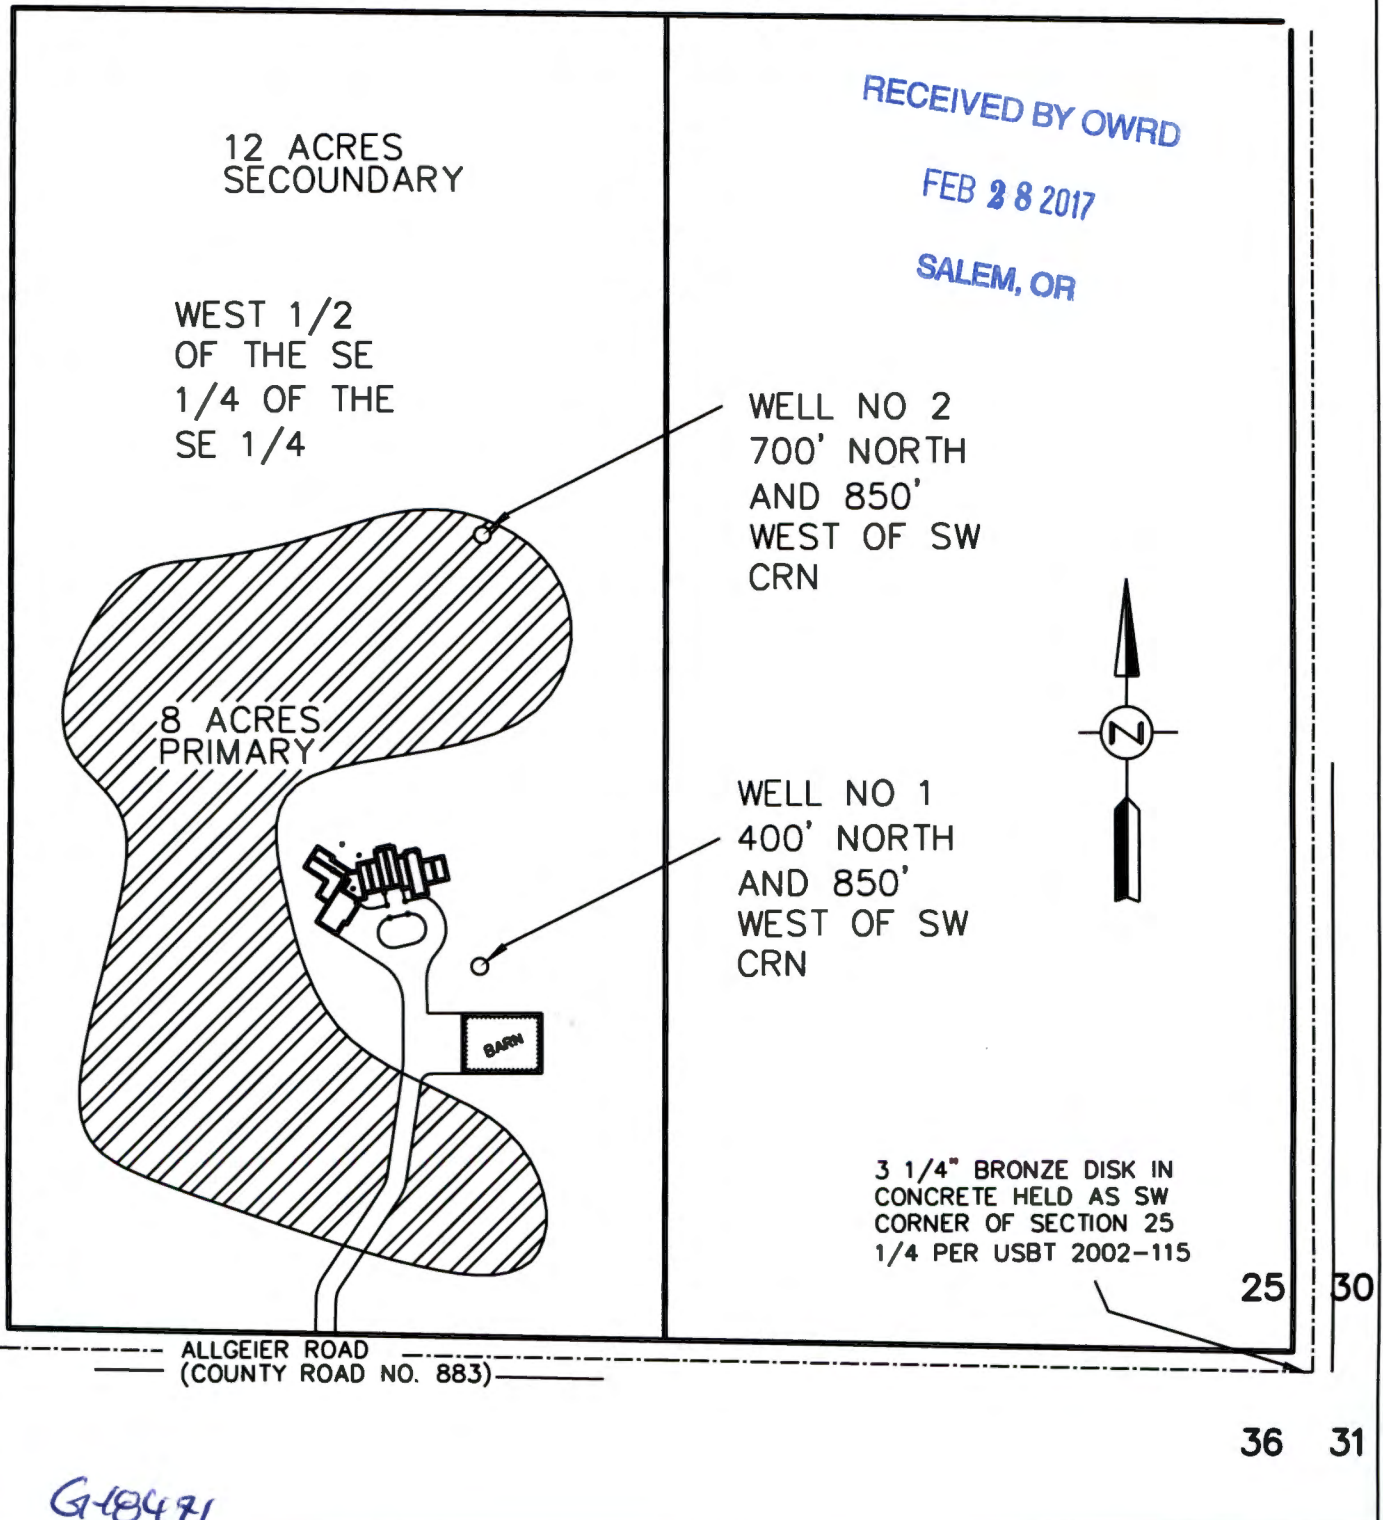

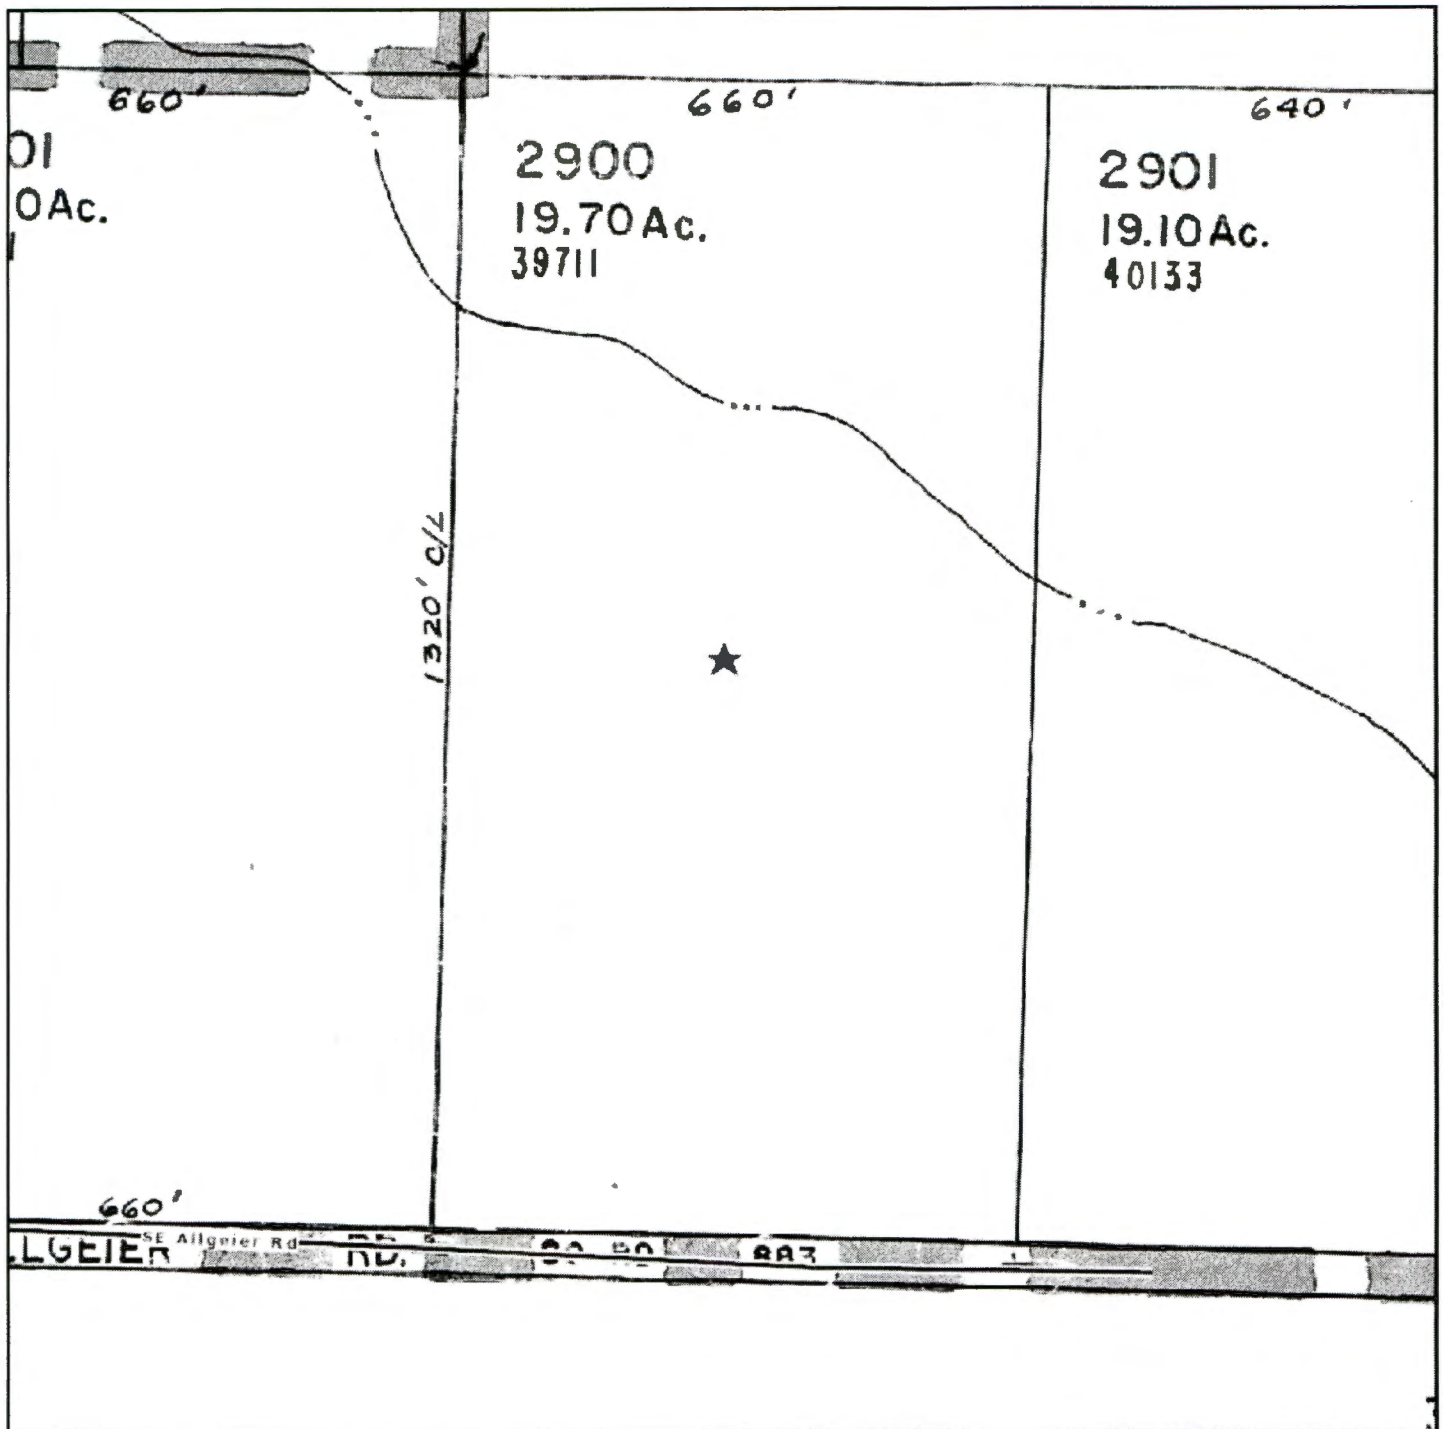

First American Title

This map/plat is being furnished as an aid in locating the herein described land in relation to adjoining streets, natural boundaries and other land, and is not a survey of the land depicted. Except to the extent a policy of title insurance is expressly modified by endorsement, if any, the company does not insure dimensions, distances, location of easements, acreage or other matters shown thereon.

geoAdvantage

RECEIVED BY OWRD

FEB 28 2017

SALEM, OR

G-18471