


T 25S R 11W
Portion
Sec 6

Application No. 59015
Permit No.

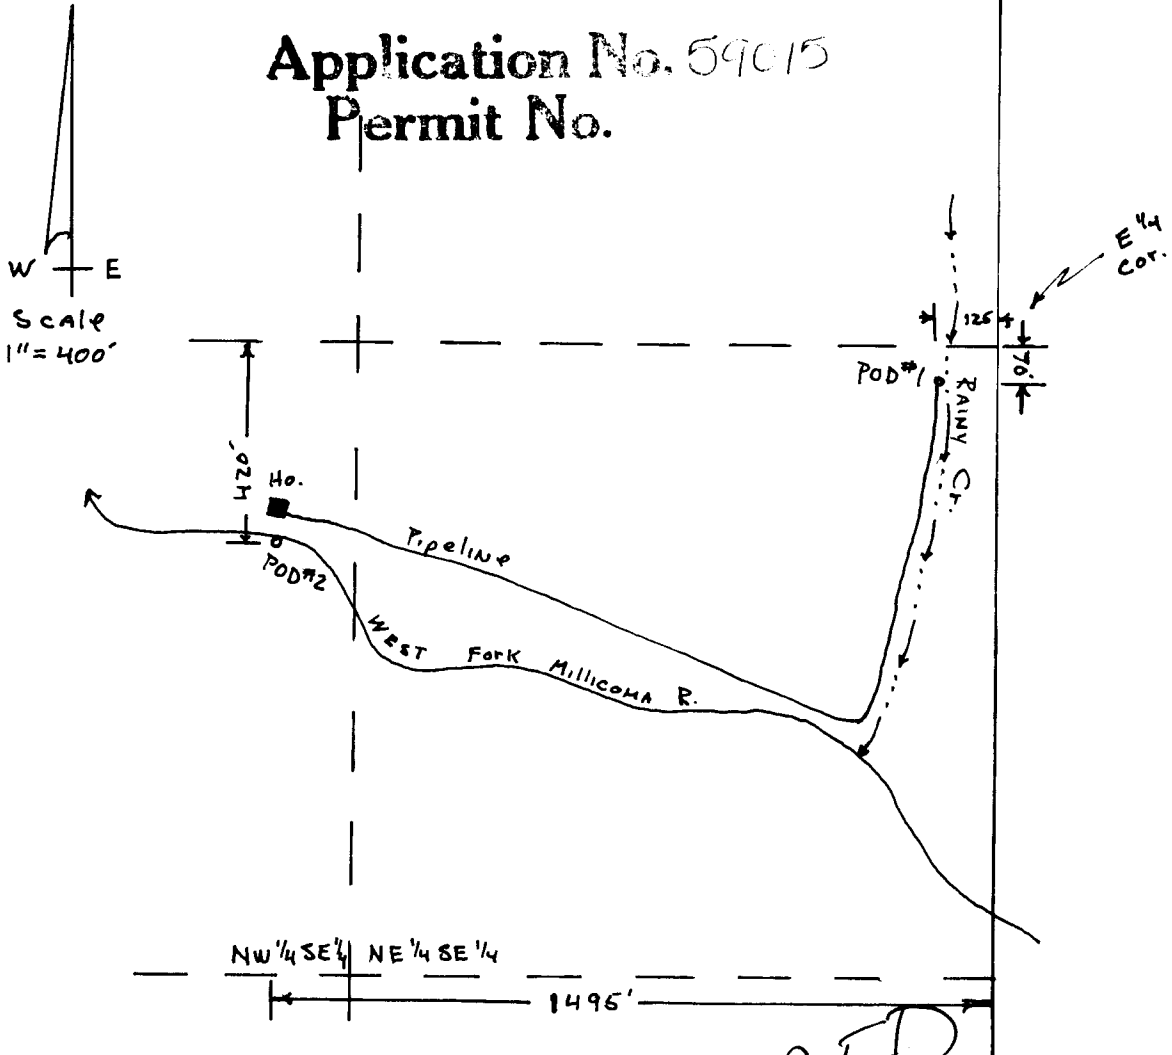

SUPERSEDED

THIS MAP FILED BY: J.P. Drolet
FROM INFORMATION FURNISHED BY THE
APPLICANT.