


Jackson County GIS

Township 36 Range 3w Section 36D



November 27, 2016

- County Line
- Streets - Label Only
- Taxlots

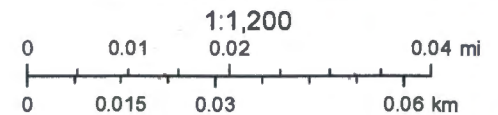

G-10472

Jackson County GIS




February 28, 2017

- County Line
- Streets - Label Only
- Taxlots

RECEIVED


FEB 28 2017

OWRD

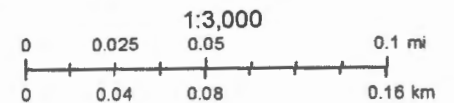

Jackson County GIS
© Jackson County 2017


Jackson County GIS

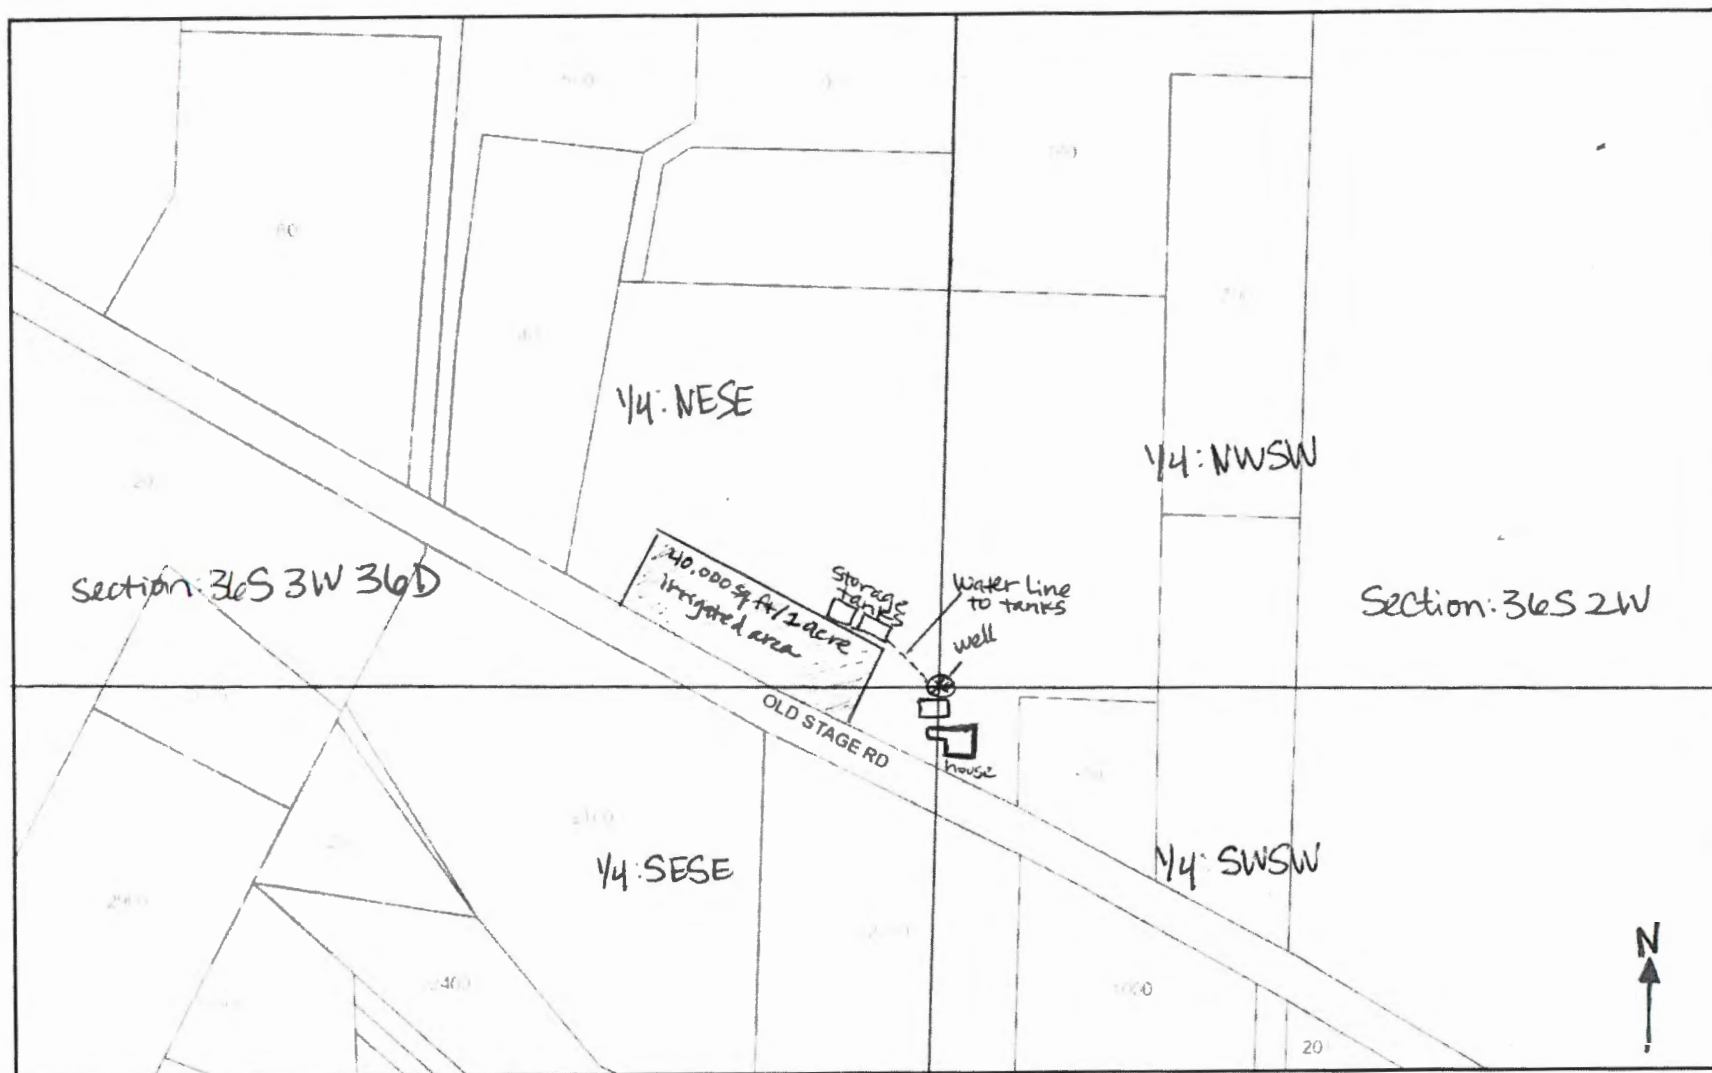

February 28, 2017

- ☐ County Line
- Streets -- Label Only
- Taxlots

⊗ Well is located directly on
crossing of 1/4-1/4
Lat: 42.39320 ± 6 ft.
Long: -122.99390

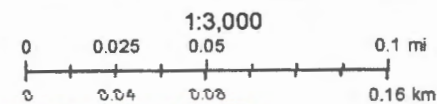

RECEIVED

MAR 02 2017


OWRD

Jackson County GIS
© Jackson County 2017

G-18442

7.10.2017 6-18472 11.13.19

Jackson County GIS

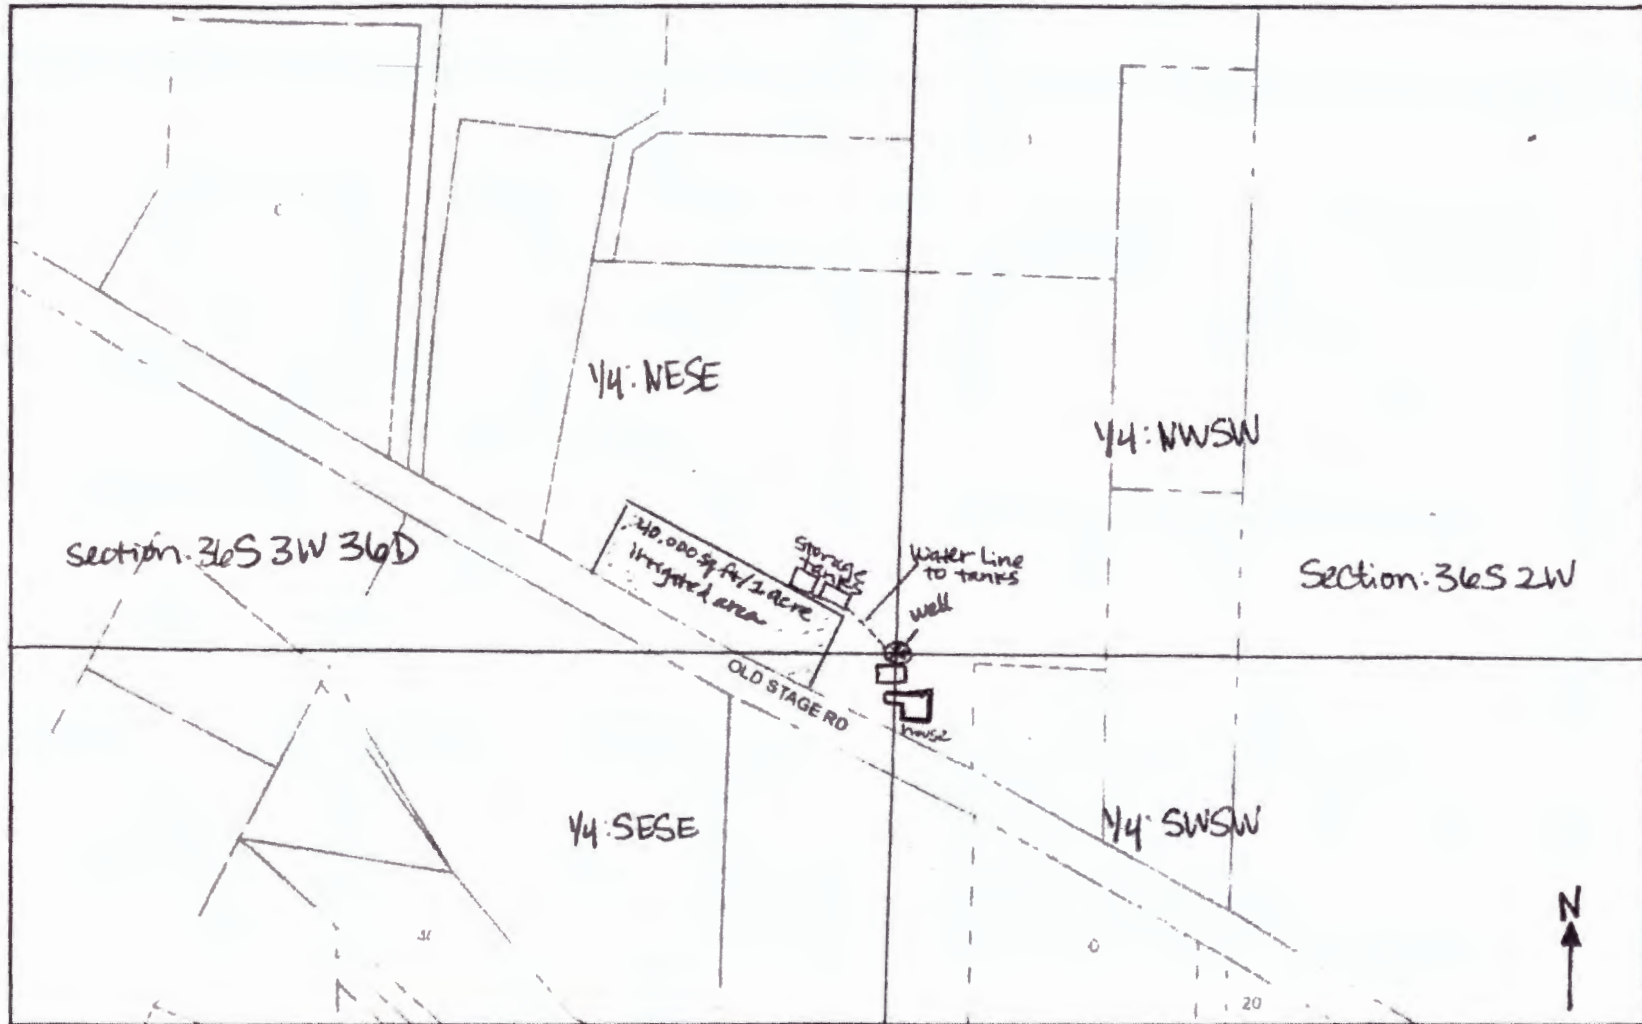

February 28, 2017


- ☐ County Line
- Streets - Label Only
- Taxlots

well location updated
by Tom Moellman on
November 13th 2009

North 00 Degrees 21 Minutes West,
1363.3 Feet From SE Corner Section 36

Tom Moellman

Well is located directly on
crossing of 1/4-1/4
Lat: 42.37320 ± 6 ft.
Long: -122.79390

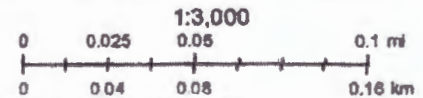

RECEIVED

MAR 02 2017

OWRD

Jackson County GIS
© Jackson County 2017