


T5S R2W, WM

MARION COUNTY

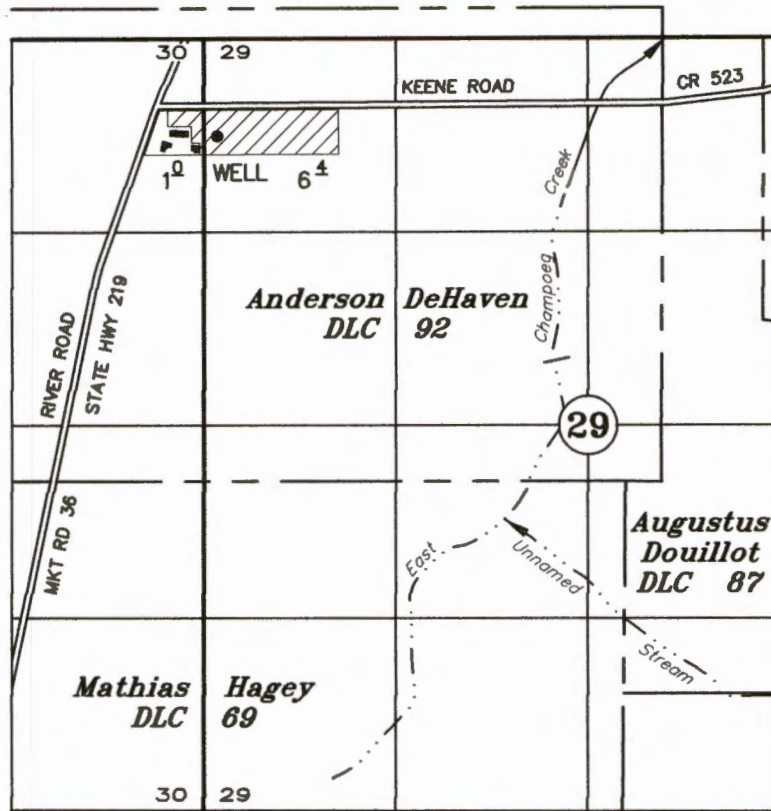

Julien M. Buhan
DLC 89

TAX LOT:
5 2W 29 600

 NURSERY
OPERATION

WELL: 870' SOUTH & 3063' WEST OF THE NE CORNER OF ANDERSON DeHAVEN DLC No. 92

APPLICATION TO APPROPRIATE GROUNDWATER

Application No. _____ Permit No. _____

Nikon & Luba Cam

February 27, 2017

SCALE: 1" = 1320'

RECEIVED

MAR 20 2017

OWRD



NOTE: This map is for the purpose of identifying the location of water rights and has no intent to dimension or locate property ownership lines.

Renewal Date: December 31, 2017

G-1849C