


P-88381

THIS MAP WAS PREPARED FOR
ASSESSMENT PURPOSE ONLY

SECTION 4 T4S R5W W.M.
YAMHILL COUNTY
1" = 400'

4 5 04

CANCELLED
200
502
600
700

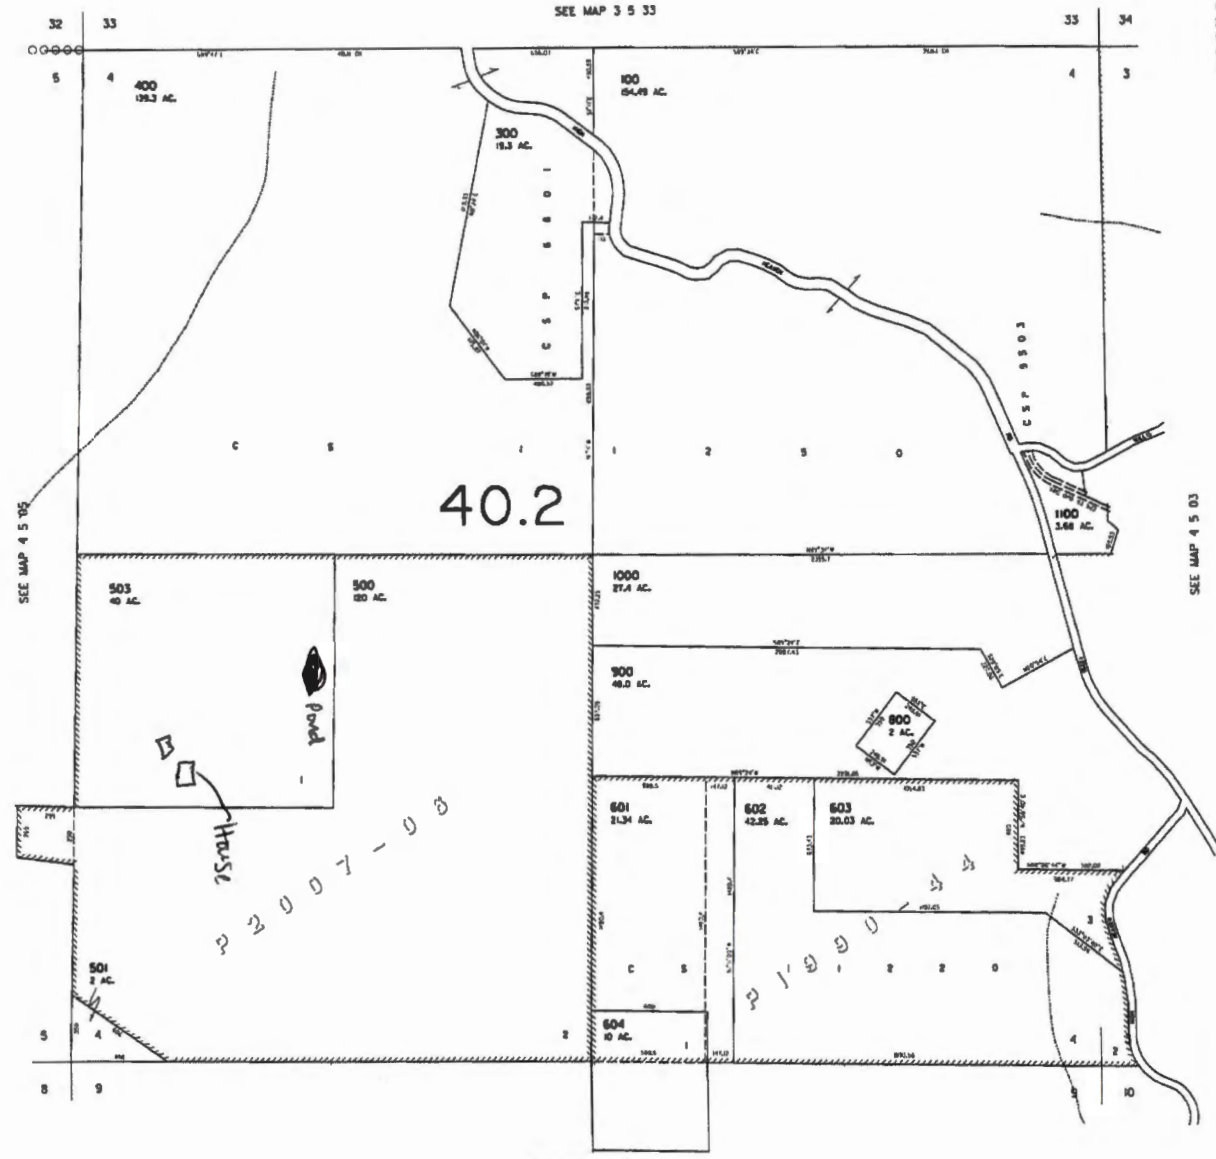

SEE MAP 4 5 03

SEE MAP 4 5 09


4 5 04

RECEIVED BY OWRD
MAR 23 2017
SALEM, OR

1" = 1320'

Tax Lot:

Township 4 South, Range 5 West, Section 4, Tax Lot 503

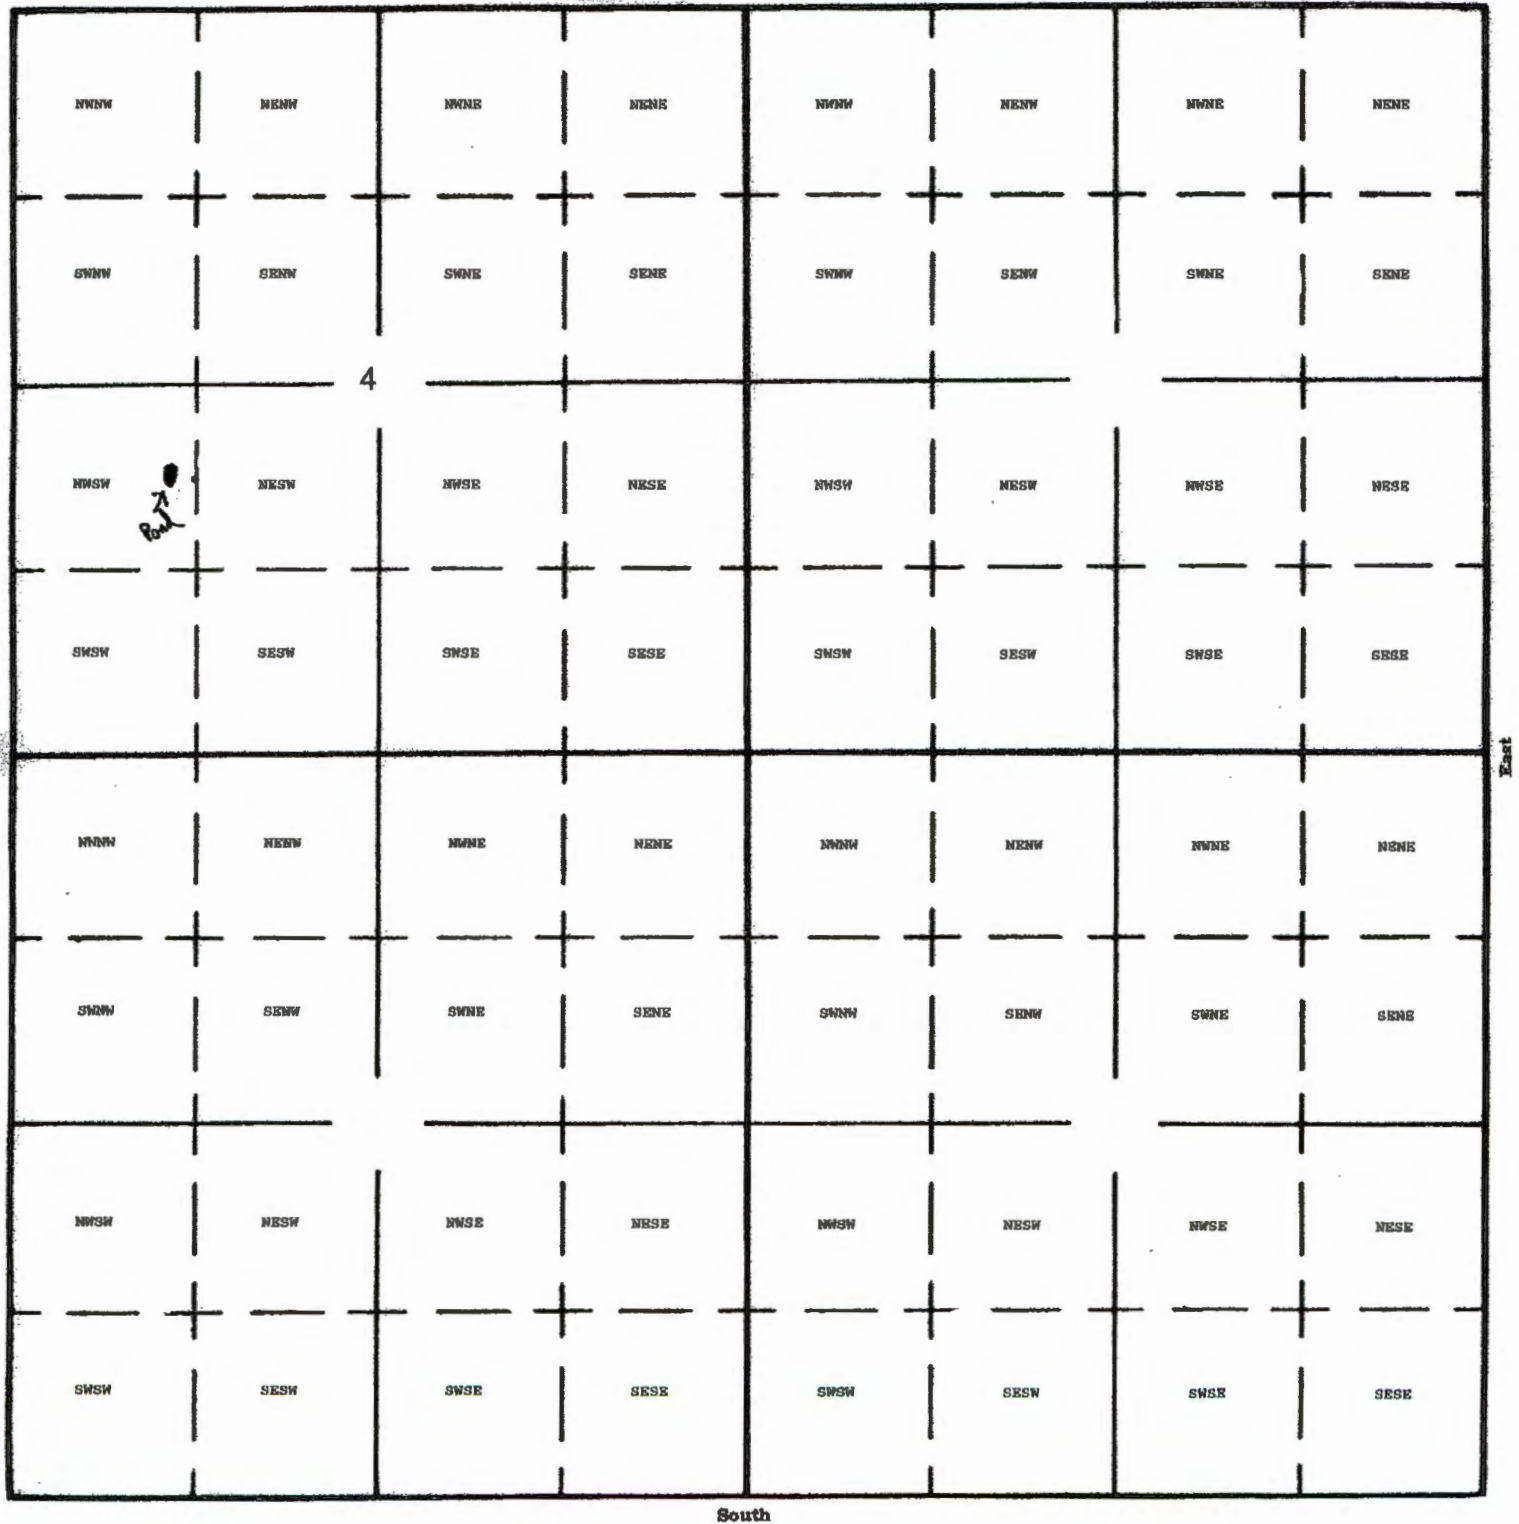

Dam Location: 1930 North and 1110 East from SW Corner Section 4

RECEIVED BY OWRD

MAR 23 2017

SALEM, OR

R-88381