


# IMMACULATE CONCEPTION CATHOLIC CHURCH STAYTON OREGON

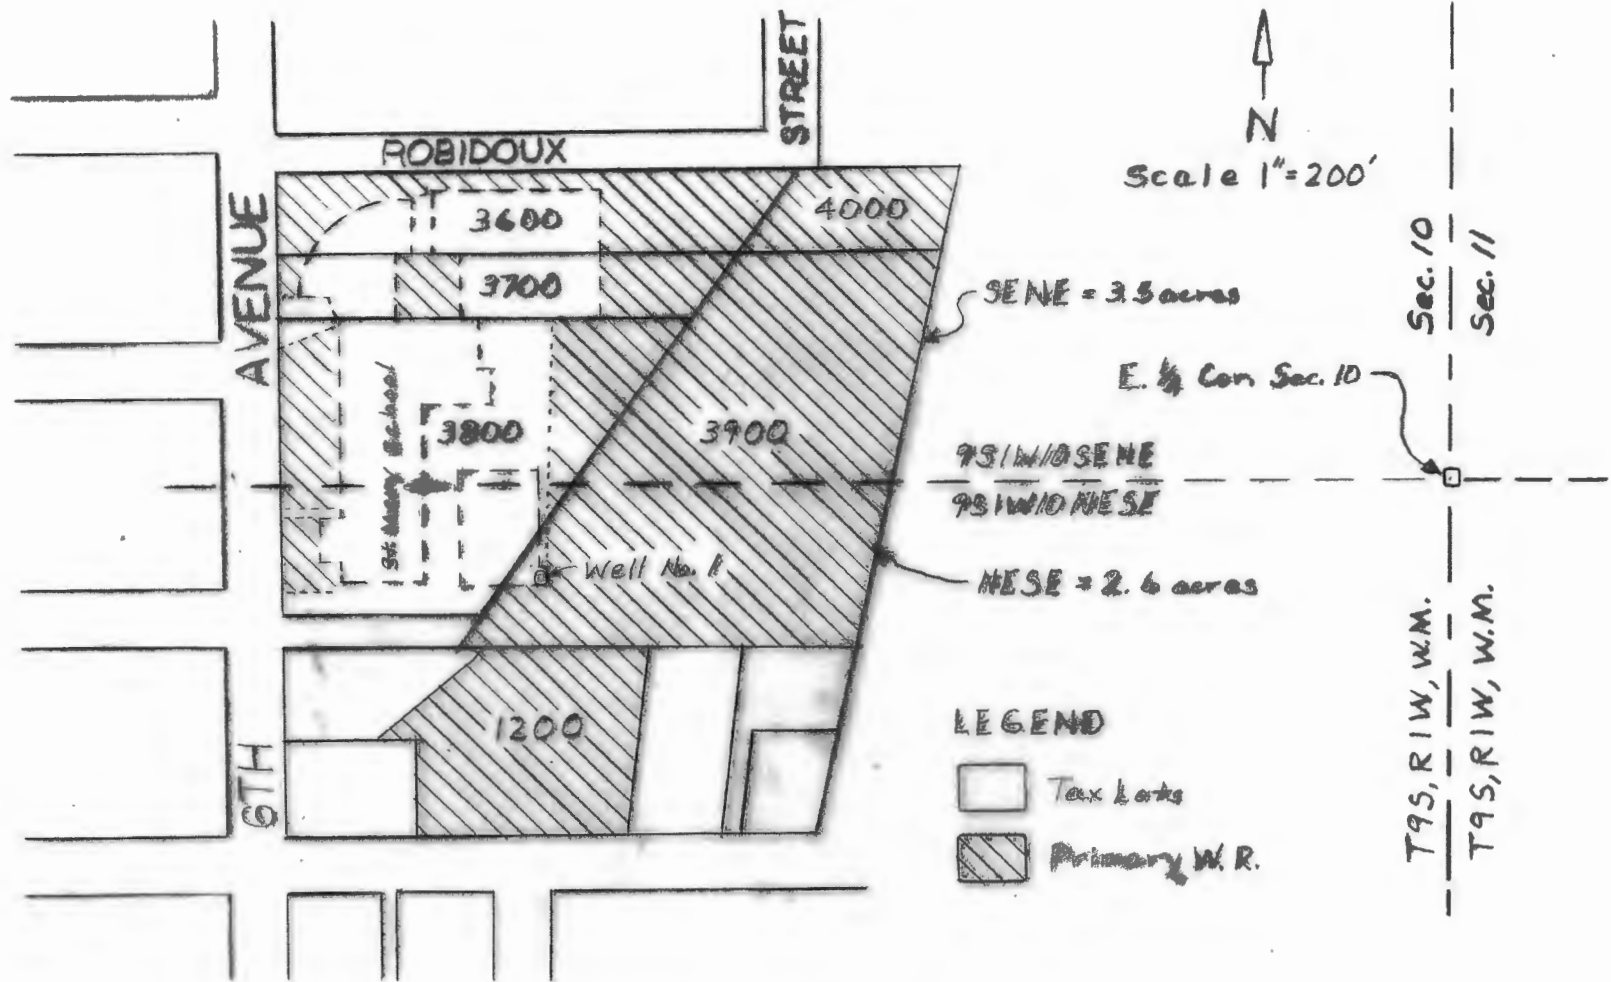


Well No. 1 (MARI 56957)  
 .970' W. and 100'S.  
 from E. 1/4 Cor. Sec. 10

Map by Will McGill

G-18424

# IMMACULATE CONCEPTION CATHOLIC CHURCH STAYTON OREGON

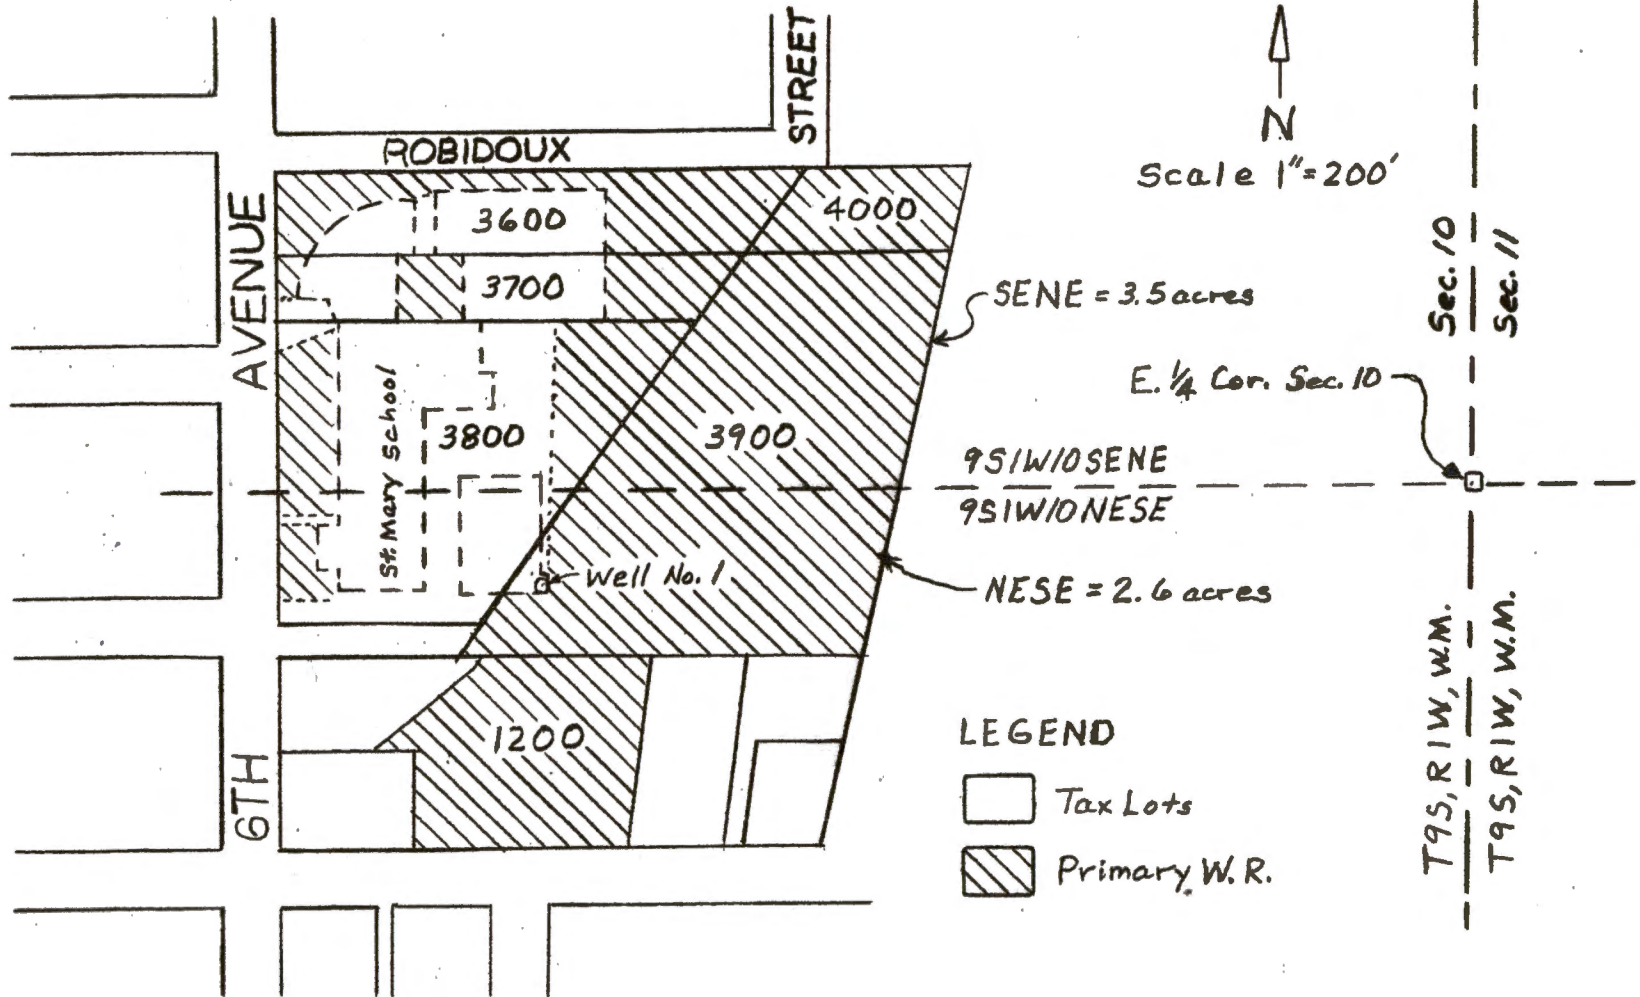

SENE = 3.5 acres  
 NESE = 2.6 acres

LEGEND  
 □ Tax Lots  
 ▨ Primary W.R.

Well No. 1 (MARI 56597)  
 970' W. and 100'S.  
 from E. 1/4 Cor. Sec. 10

Map by Will McGill

OWRPD

MAR 22 2017

RECEIVED



