

RECEIVED BY OWHU

APR '06 2017


SALEM, OR

15155 Dunn Forest Road

T10S R5W S6 TL 213

CATCHMENT POND 1

NORTH ↑

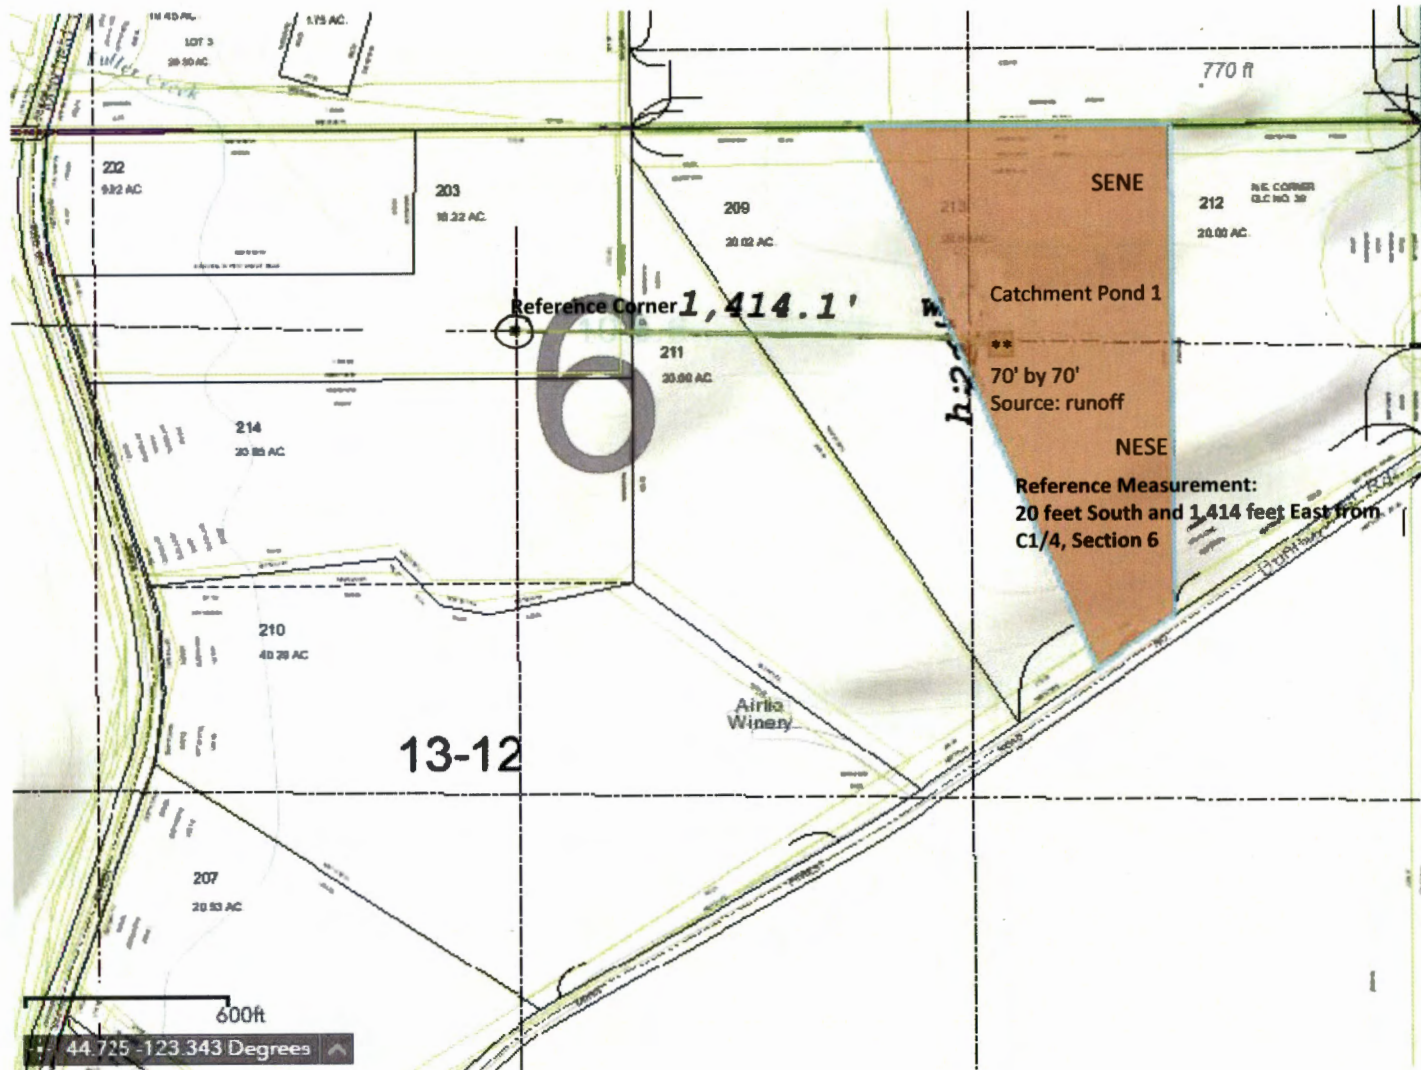

1" = 600 ft.

7-88387