



6-18-16
12:42

Oregon Water Resources Department
Water Rights Mapping Tool

OWRD Only

Search

Identify Non-Water Right Features

Tax Lots


Identify Tax Lots OR Map

Off
 On

County: Null
Taxlot: 672400 114
Owner1: DIXON JENNA LEE
Owner2:
Owner Address: 13780 NW BERRY CREEK RD, MCMINNVILLE OR 97128
Site Address:
Acres: 80.4
TRSQQ: Null
Effective Date: January 1, 2016

Note: Tax lot information provided here is for general query purposes. It may not be up to date or may not be an official record. Please contact the respective county tax assessor's office for more current and specific information.

It is recommended to zoom to a detailed extent before query.

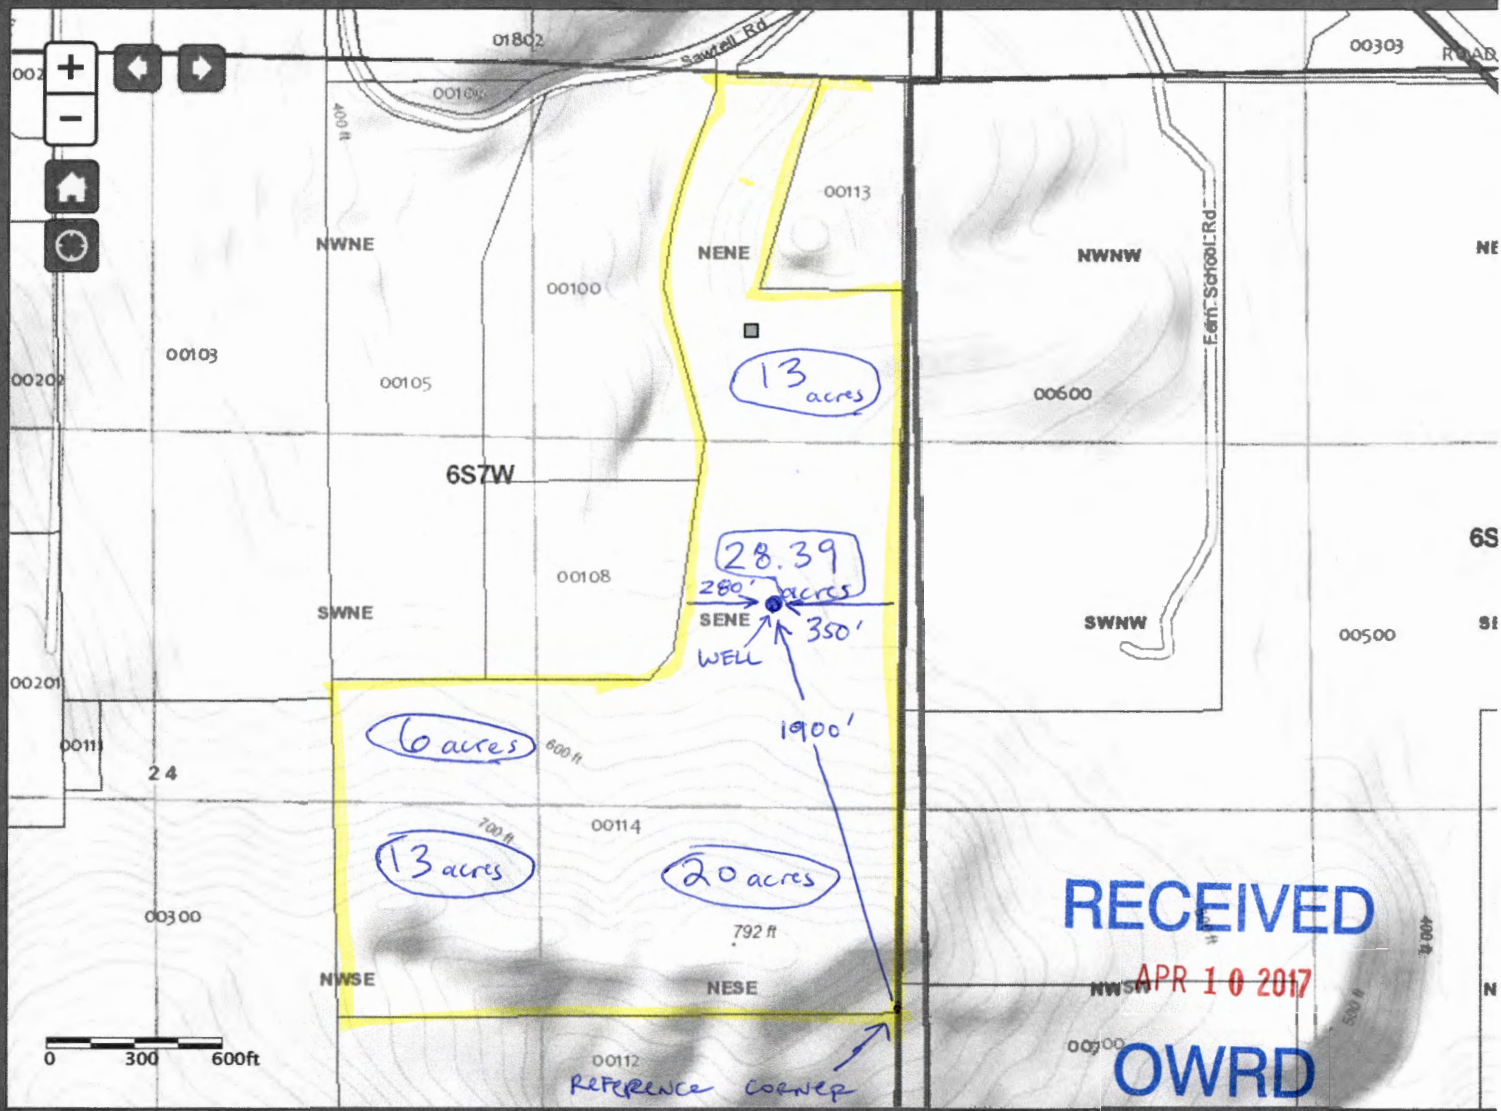

Tools
Layers
Bookmarks

POD POU Irrigation Districts AOI WR By Time