


Alternate Pond Application Map
 TS 36S, R 4W, Sec 16 TI 1408
 NWNE

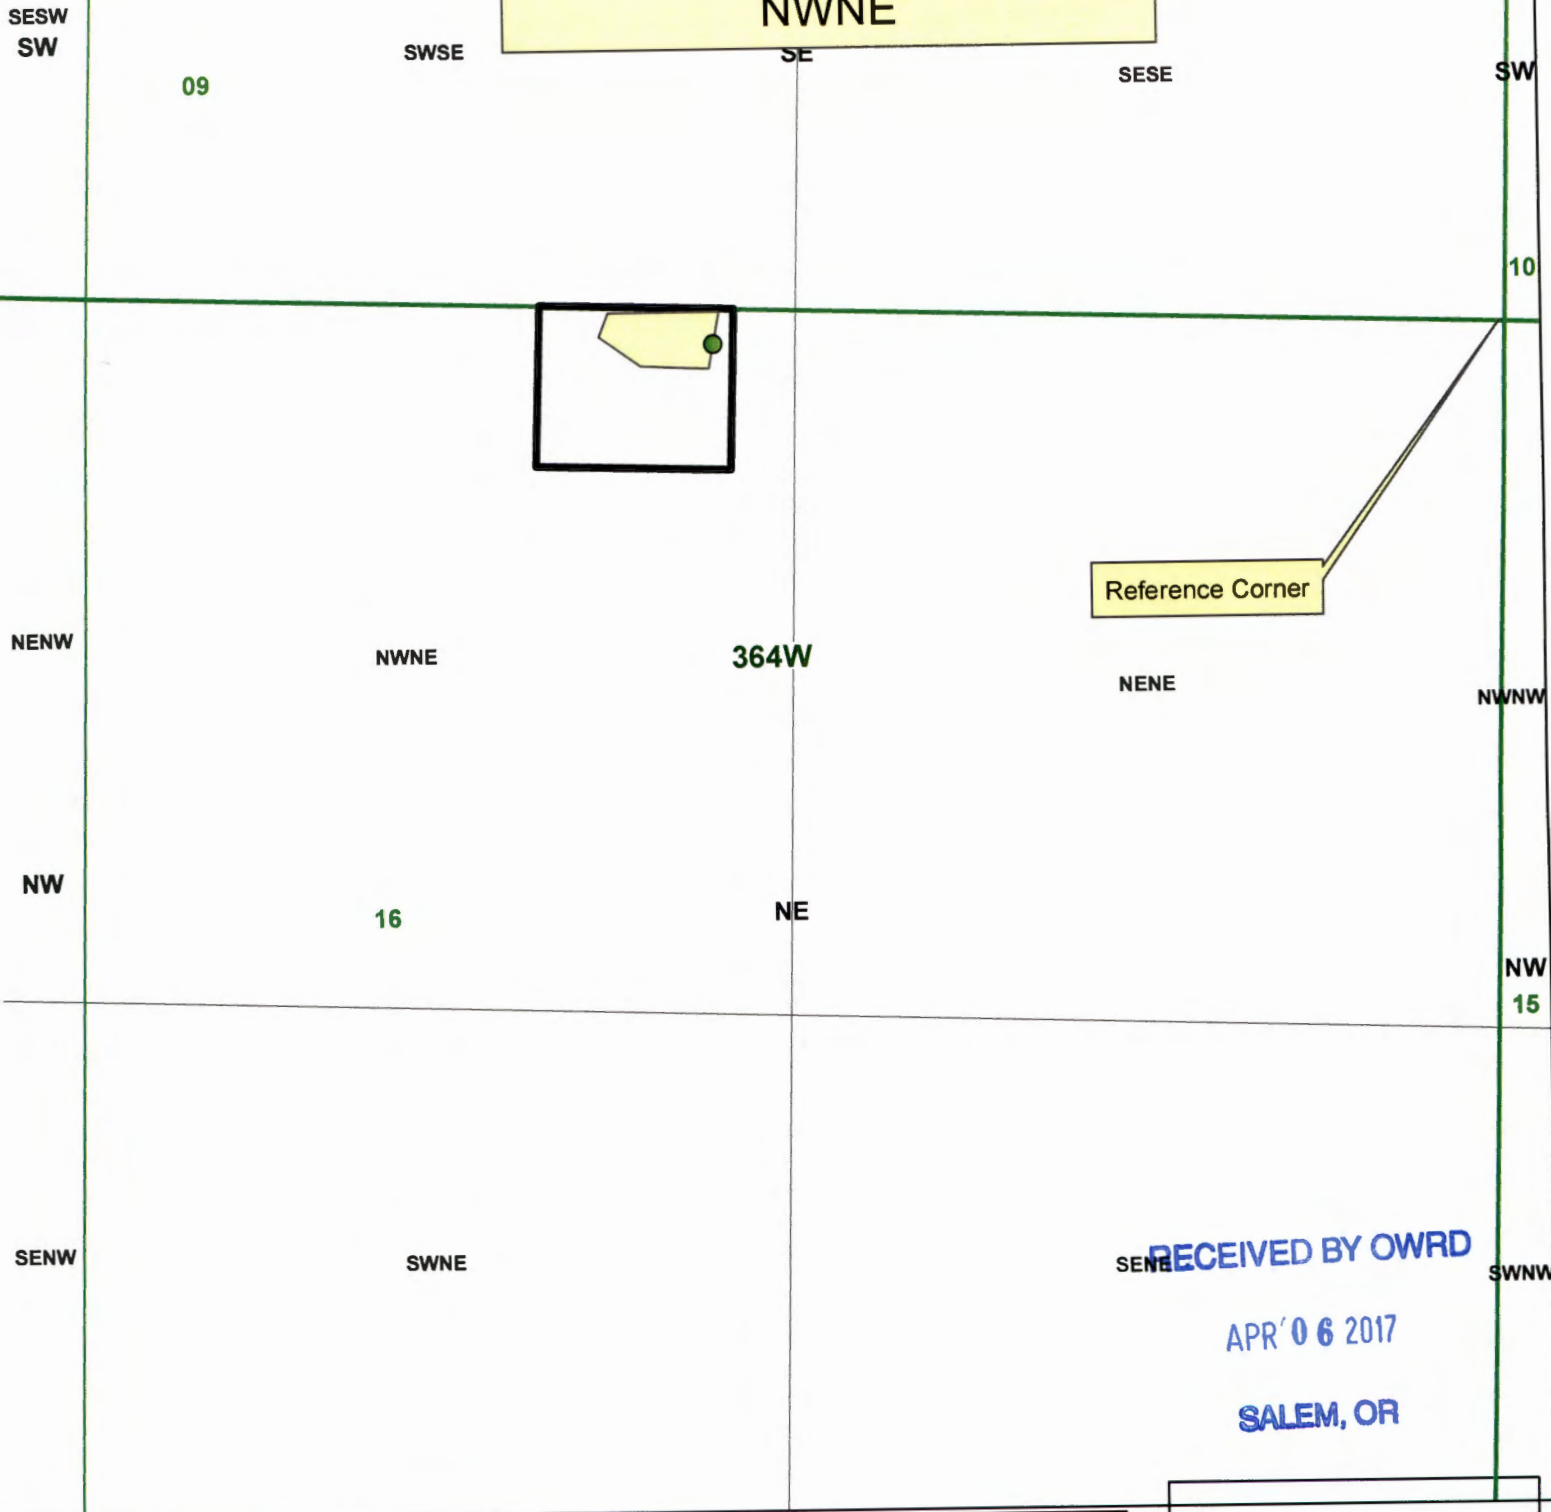

Reference Corner

RECEIVED BY OWRD
 APR '06 2017
 SALEM, OR

Legend

-  Location of Pond
-  TL 1408
-  Dam



Center of Dam is located 1485 ft West and
 63 ft South of the NE corner of Section 16




JACKSON COUNTY
WATERMASTER

Prepared by Shavon Haynes


This map is based on a digital database compiled by Jackson County from a variety of sources. Jackson County cannot accept responsibility for errors, omissions, or positional accuracy. There are no warranties, expressed or implied.

Date: 01/23/2017 35-2w-13 tl 1000.mxd_haynes

2-88389

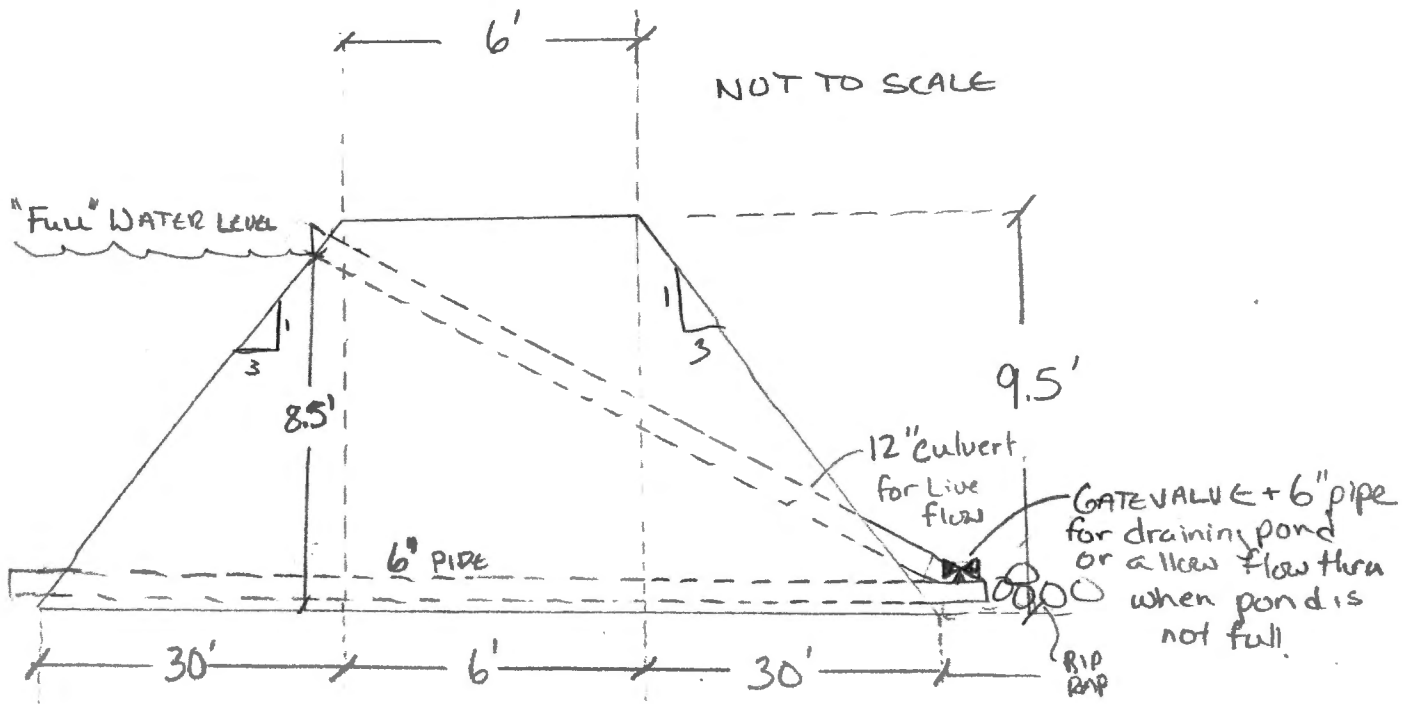

Dam Cross Section

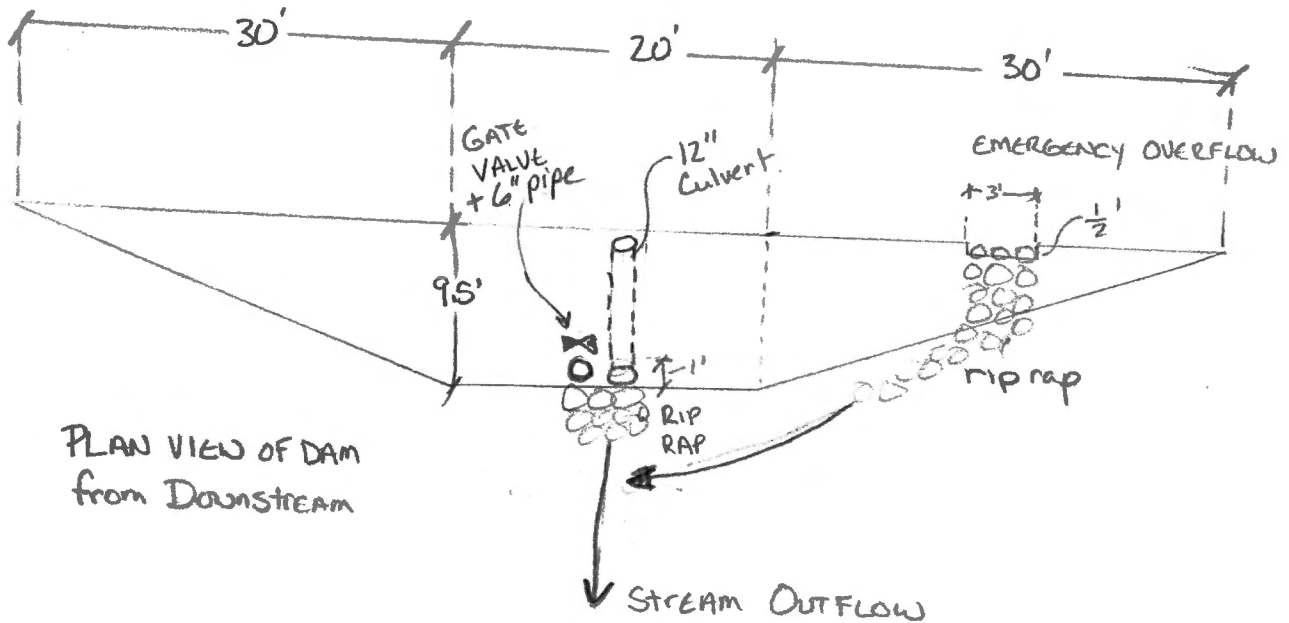

PLAN VIEW OF DAM from Downstream

RECEIVED BY OWRD

APR 06 2017

SALEM, OR

2-88389