


EXHIBIT B

T28S, R27E, W.M.
Harney County, Oregon

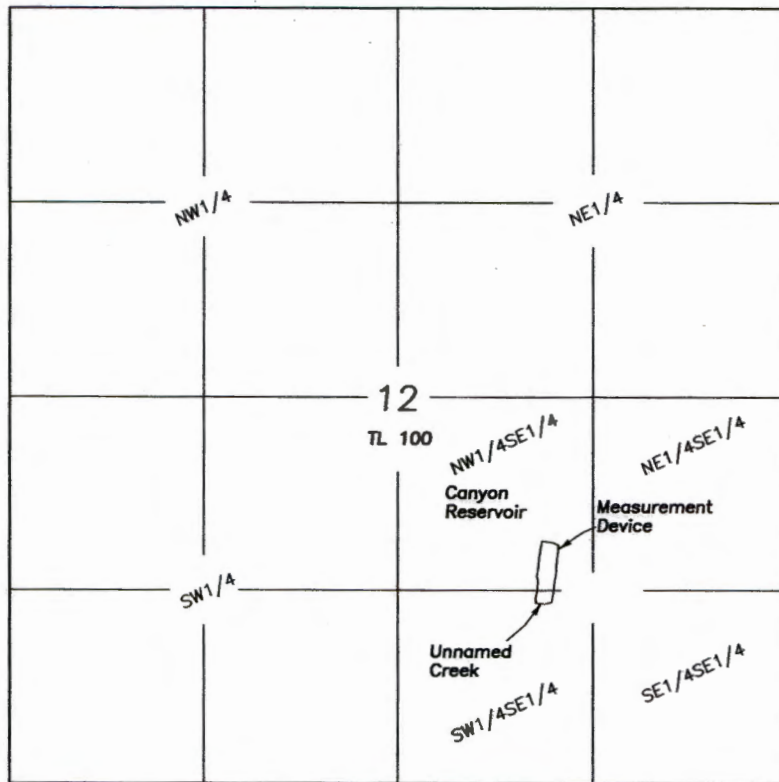

Outlet is located 1630' North & 1560' West of the
SE corner of Section 12.

Measuring device is located 10' North of the Outlet.



SCALE 1"=1320'

RECEIVED BY OWRD

APR 10 2017

SALEM, OR

FINAL PROOF SURVEY
CLAIM OF BENEFICIAL USE
CANYON RESERVOIR

For

Bureau of Land Management

November 9, 2016

LEGEND

Application No. R-59662

Permit No. R-8094

Priority 12/21/1979

A portion of Tax Lot
28-27 TL100

NOTE: Tax Lot 100 is owned by the BLM
and is more that 23,000 acres.
No boundaries of the tax lot
can be shown.

NOTE: The preparation of this map
was for the purpose of identifying
the location of the proposed water
right and has no intent to provide
dimensions or location of property
ownership lines.

Prepared by
Cornerstone Surveying, Inc

P.O. BOX 33

JOHN DAY, OR. 97845


(541)575-1813

cornerstonesurvey@centurytel.net

RECEIVED BY OWRD

FEB 06 2017

SALEM, OR

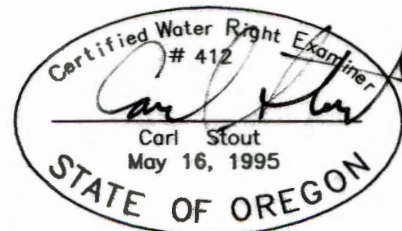

R-88390