


T 40S R8W Southeast Quarter Section 27

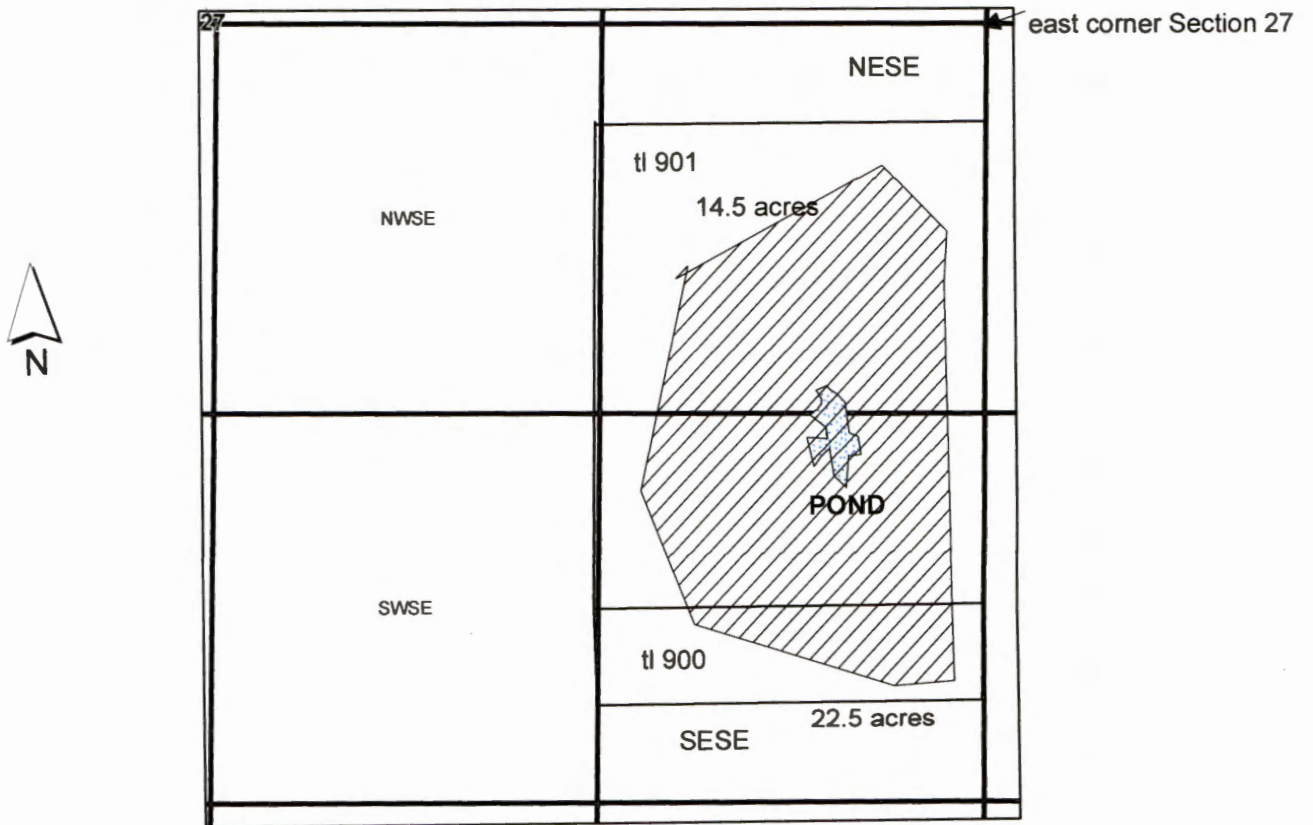

1 inch = 660 feet

The approximate center of the pond is located 503 ft west and 1390 ft south from the east corner of Section 27. The area of the pond is 0.7 acres.

RECEIVED BY OWRD

APR 17 2017

SALEM, OR


L. R. R. R.

Assessor's Map 40-08-27 tl 901

RECEIVED BY OWRD

APR 17 2017

SALEM, OR

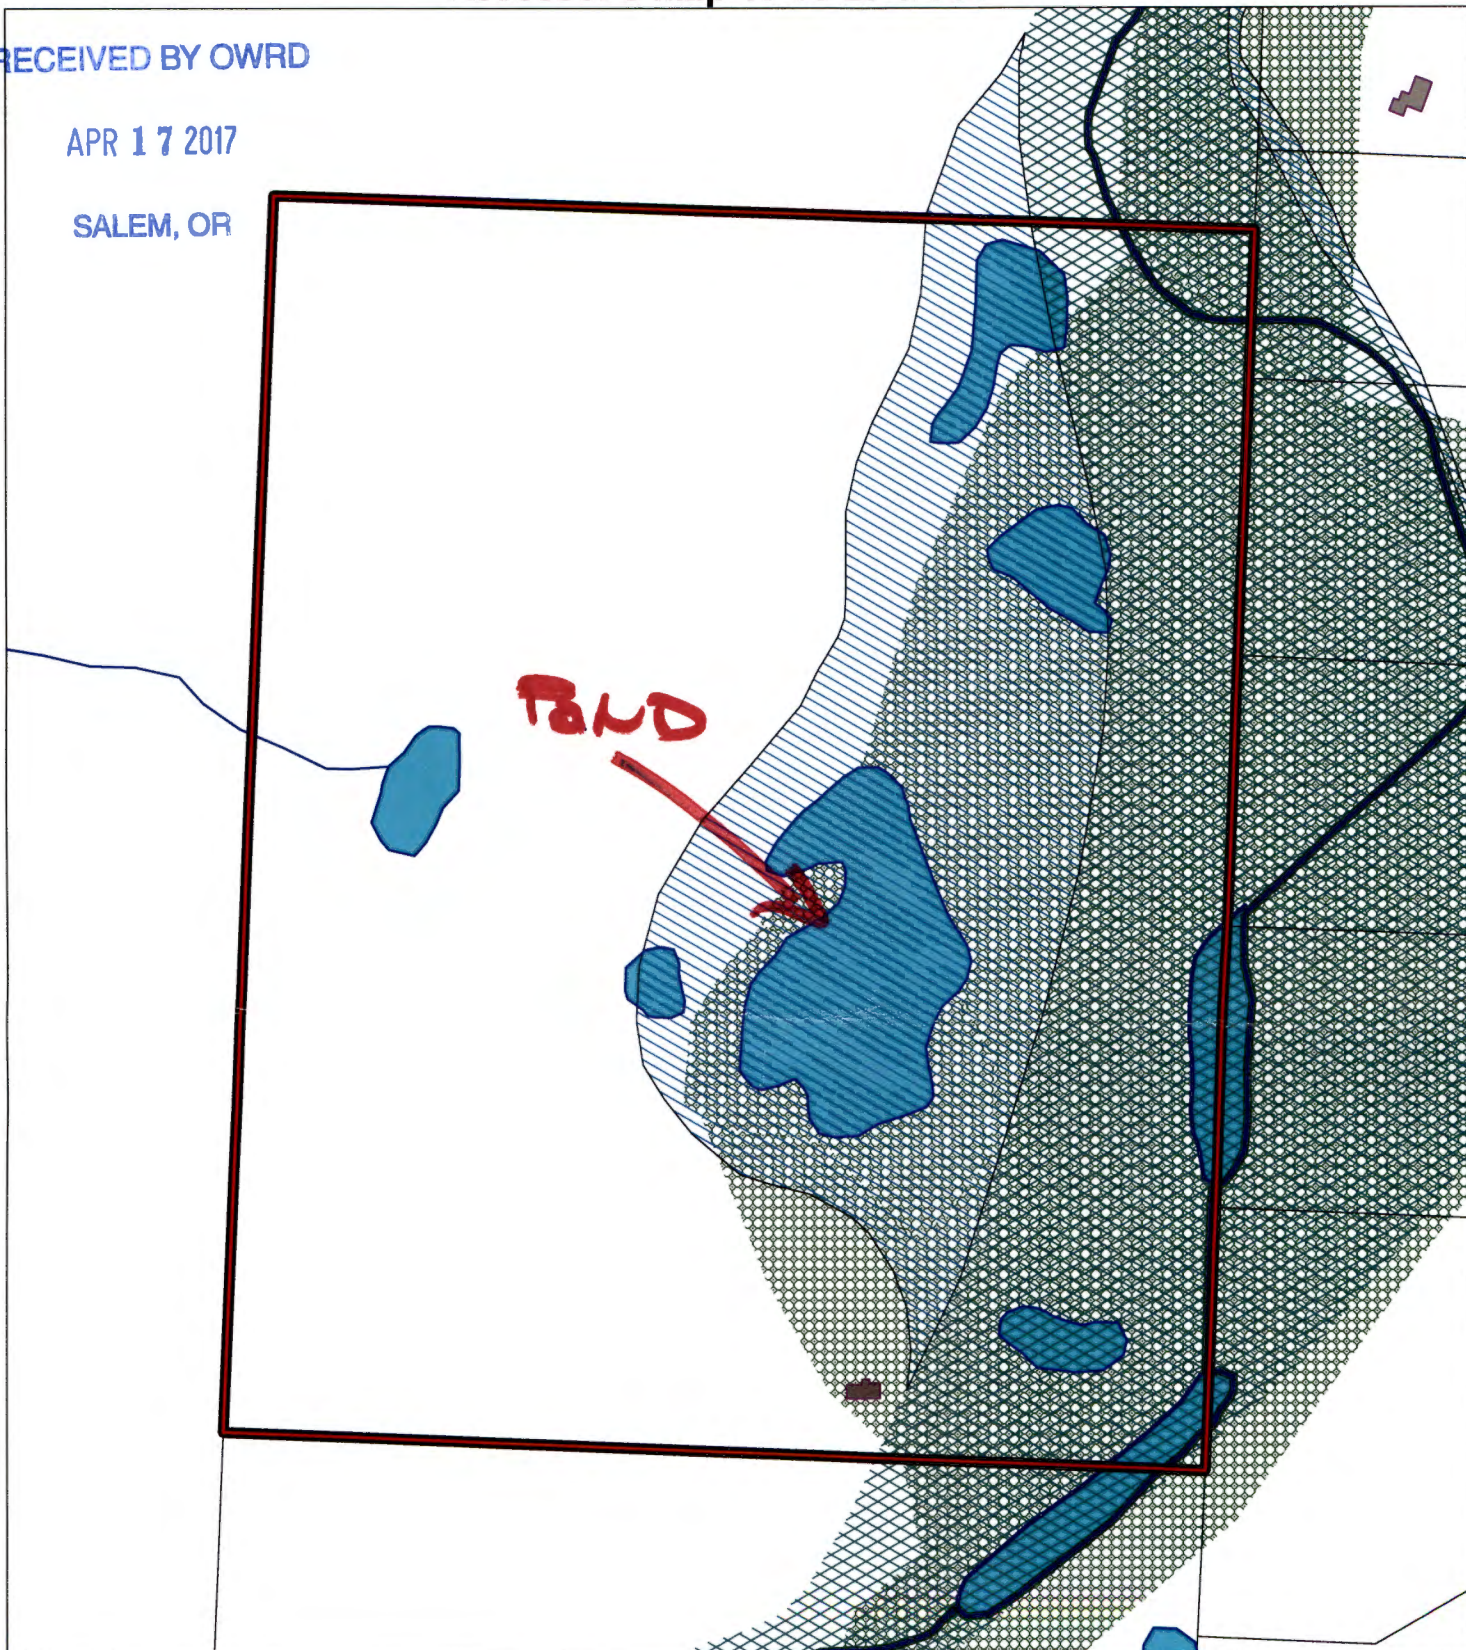

Legend

FEMA Flood Map	
	Floodway
	Floodway Fringe
	Taxlots
Water (line)	
	Class 1
	Class 2
Water (polygon)	
	Water Bodies
	Wetlands (Line)
	Wetlands (polygon)

300 0 300 600 Feet

The information on this map is furnished for general interest purposes only. This information is provided without warranties of any kind, express or implied, and it should not be used to support any purchase or other investment. Neither Josephine County, Cave Junction, nor Grants Pass will accept responsibility for any errors or inaccuracies in the depicted information.



Scale
1:3117



Locator Map



6-02217