

1298 Pleasant Creek Rd., Rogue River, OR 9753;

T35 R4W Sec. 3 Tax Lot 100

82.69 ac. zoned EFU


$N\frac{1}{2}NE\frac{1}{4}$ T35 R4W Sec.3

RECEIVED BY OWRD

JAN 18 2017

SALEM, OR

Scale : 1 inch = 330 ft.

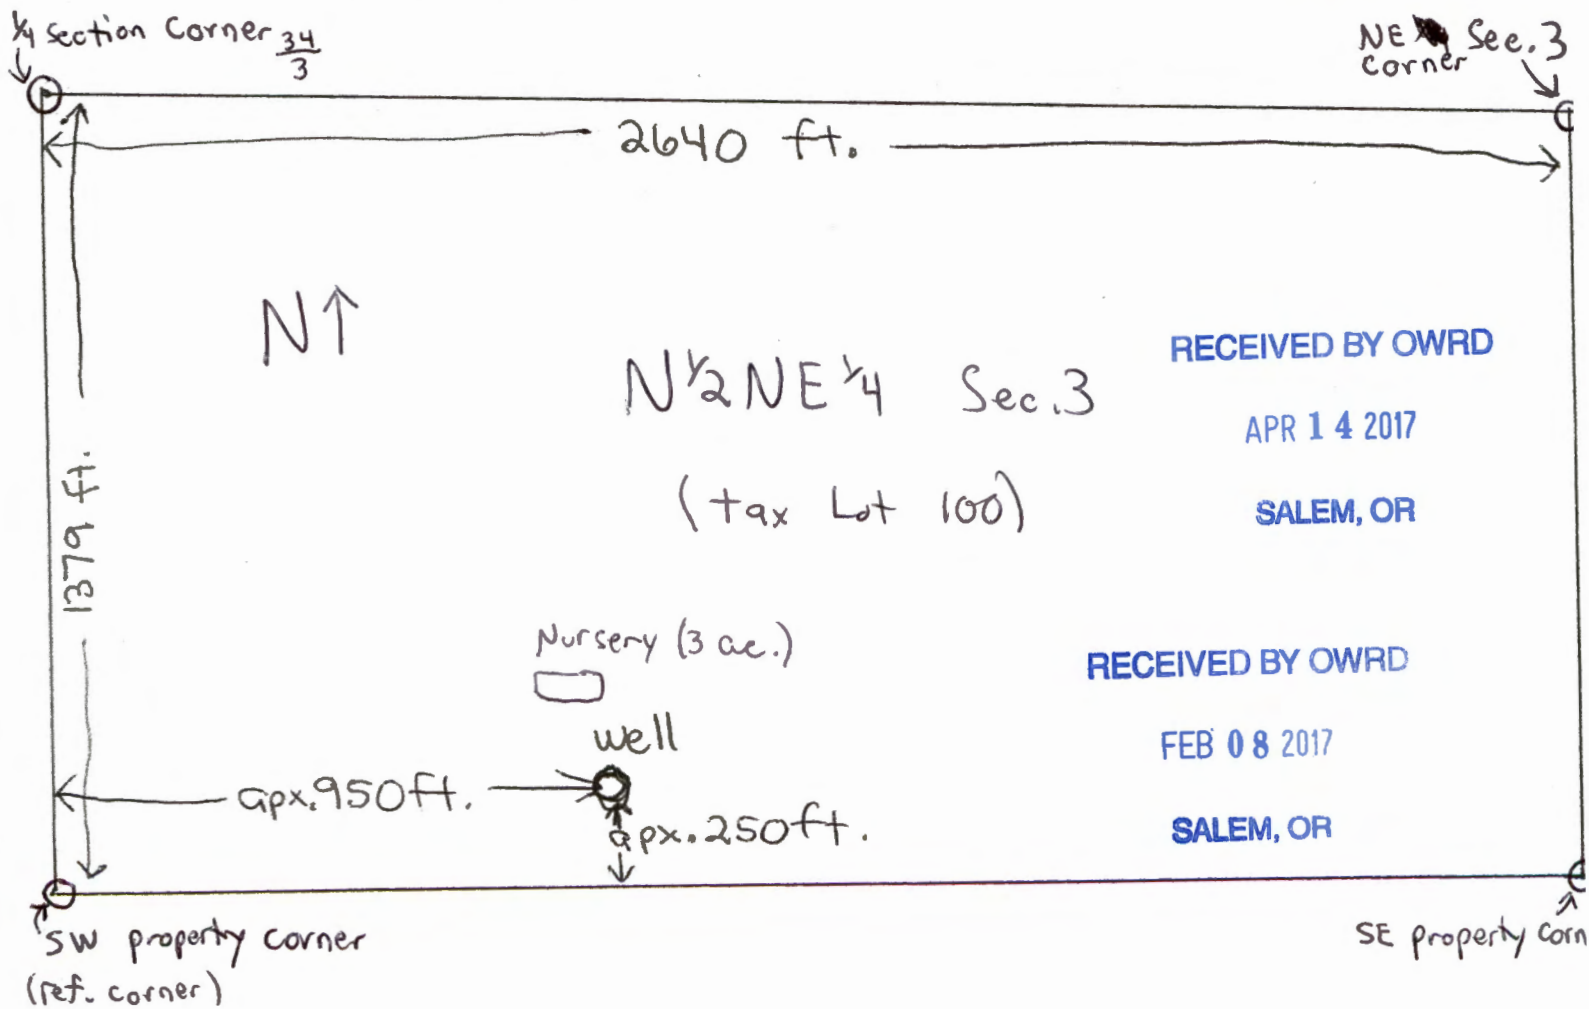

G-18498