



RECEIVED

JAN 08 2018

OWRD

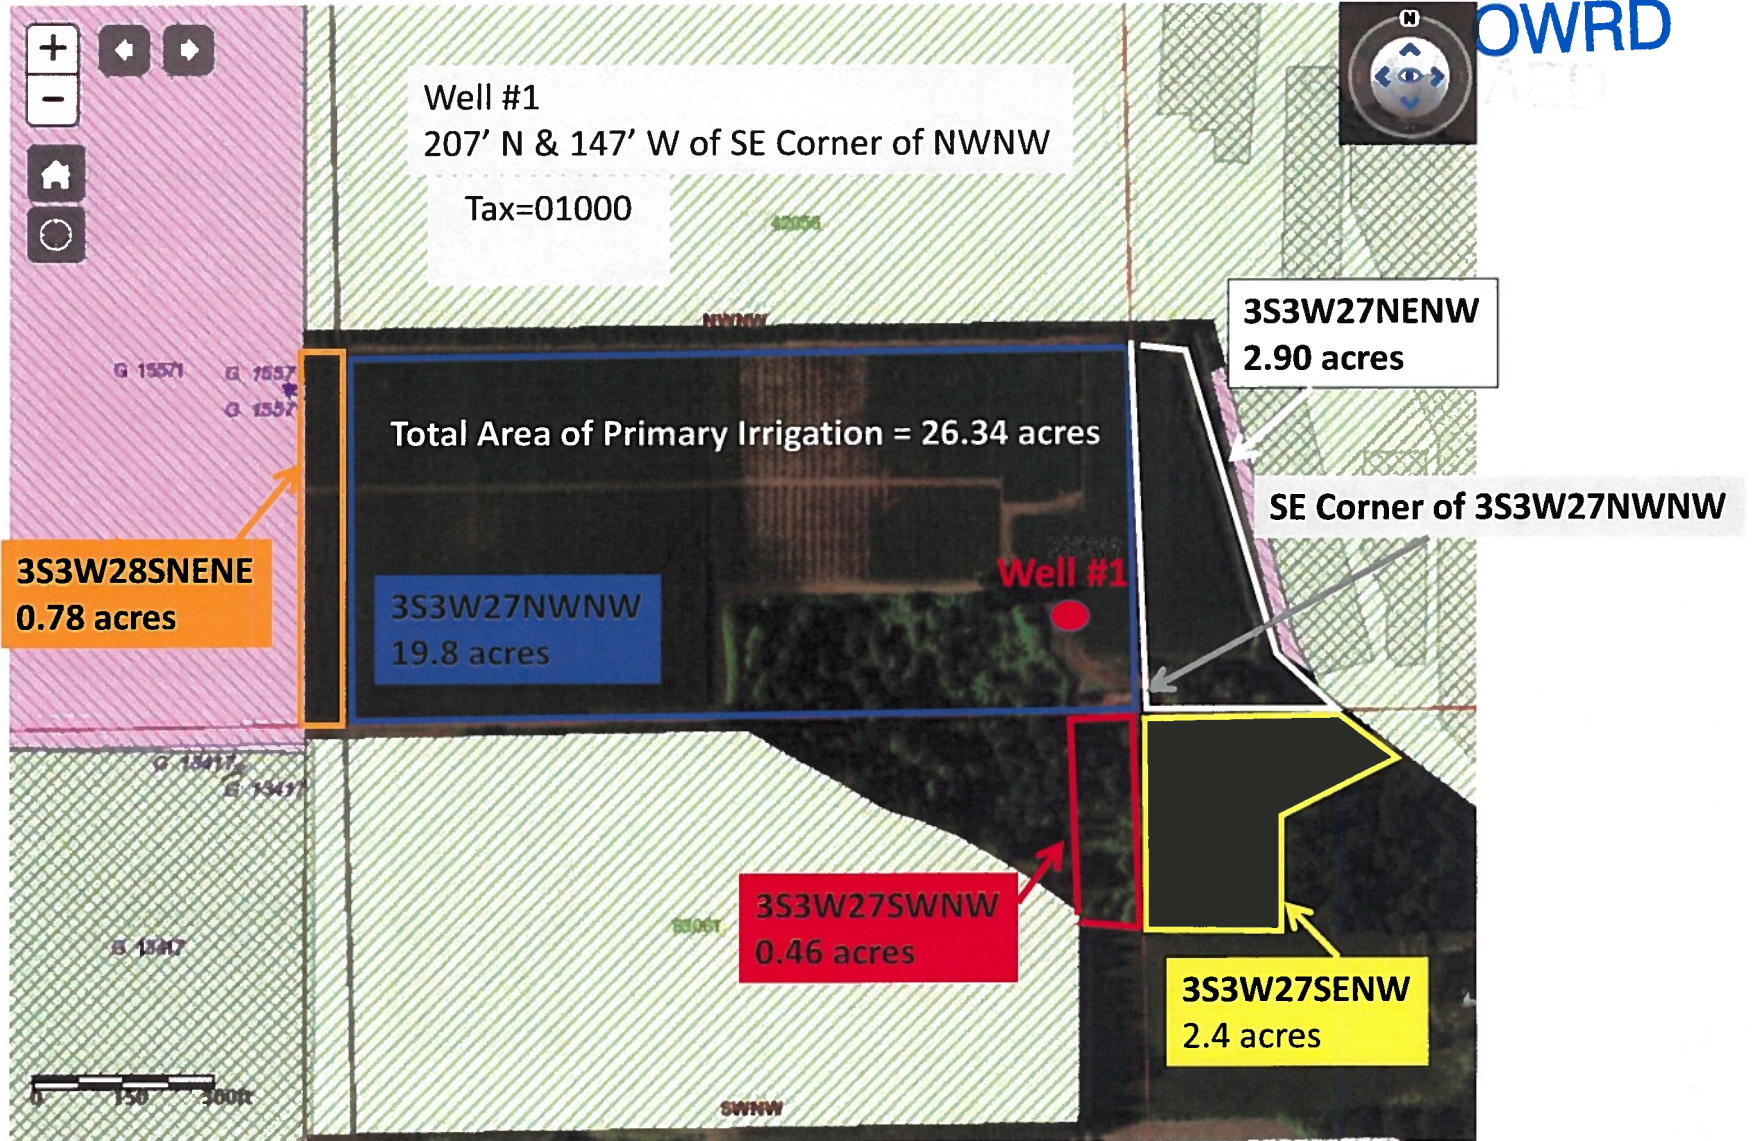

G-18501

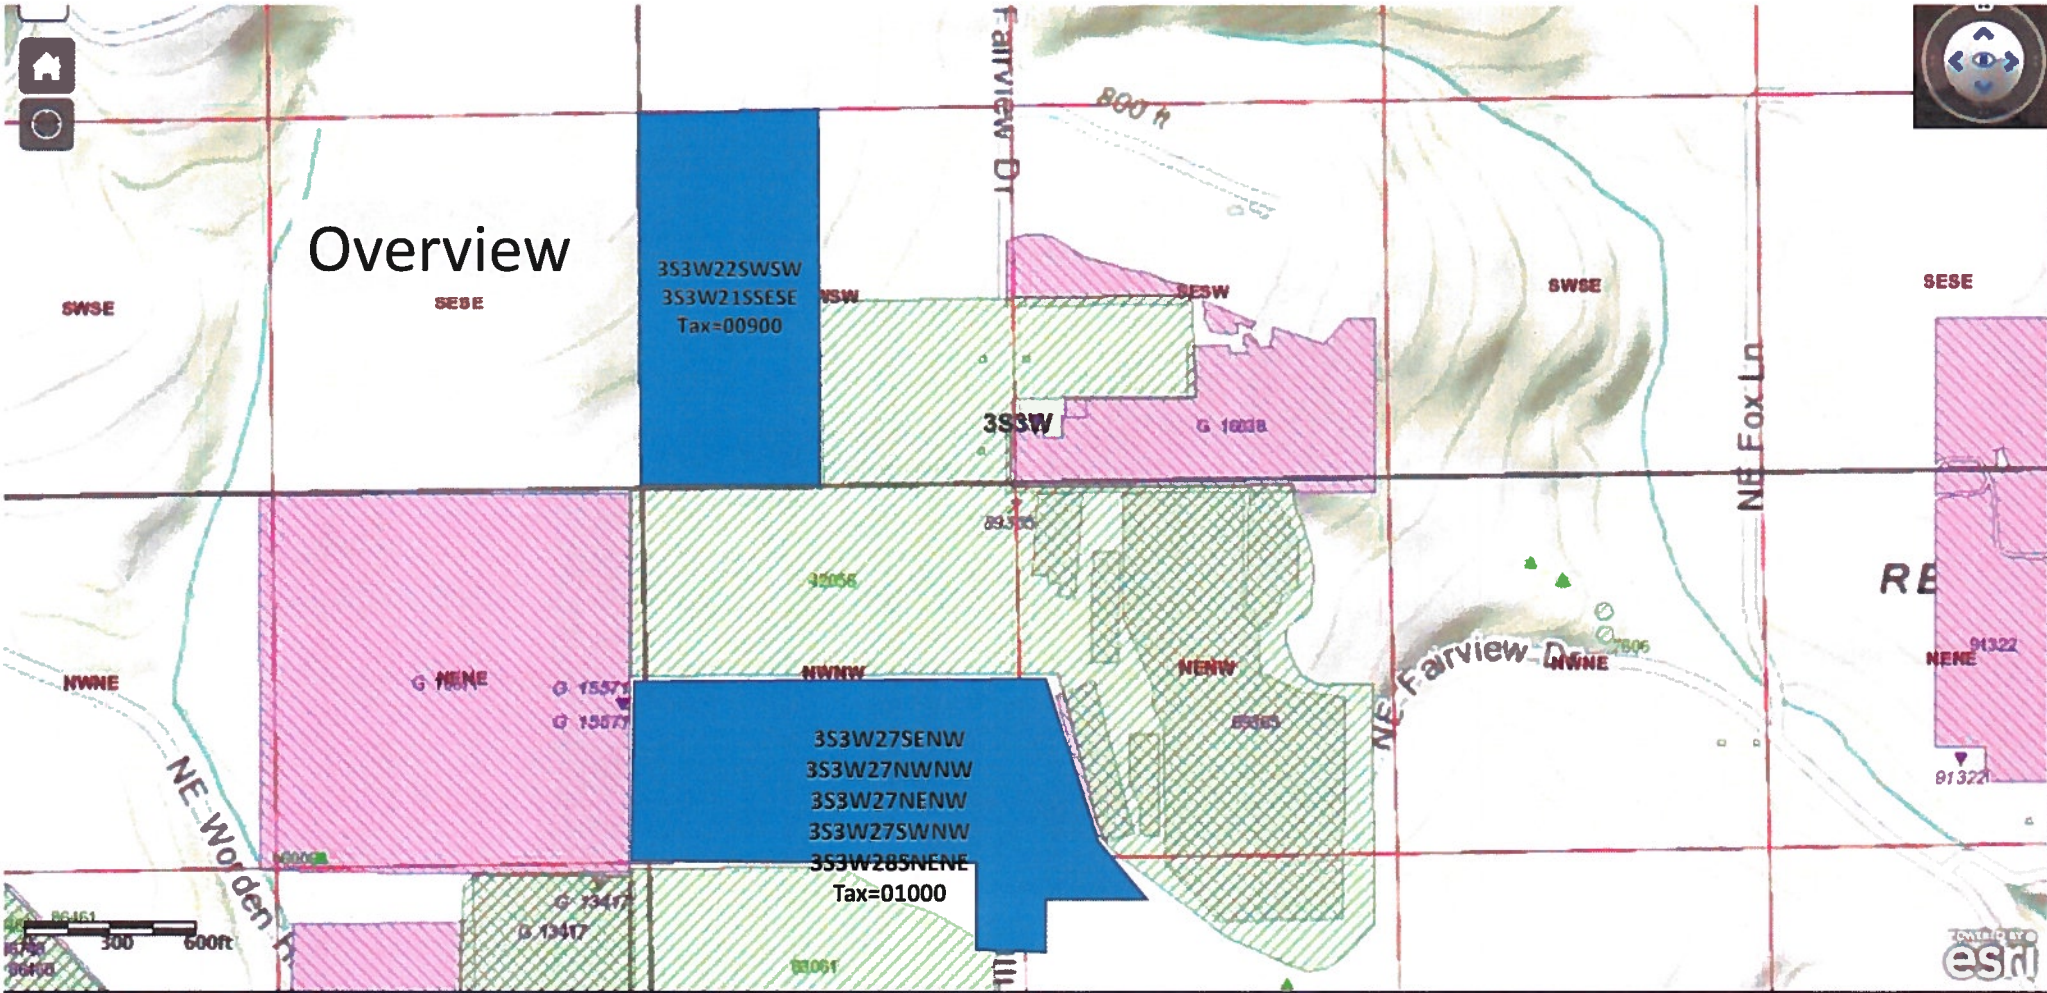

RECEIVED

JAN 08 2018

OWRD

6 12501

JAN 08 2018

OWRD

