

RECEIVED BY OWRD

RECEIVED BY OWRI

Wayne and Amanda Staehely
1" = 1320'

AUG 23 2016



North


MAY 15 2017

Tax Lot:

SALEM, OR

SALEM, OR


Township 4 South, Range 1 East, Section 34, Tax Lot 1100, 1101

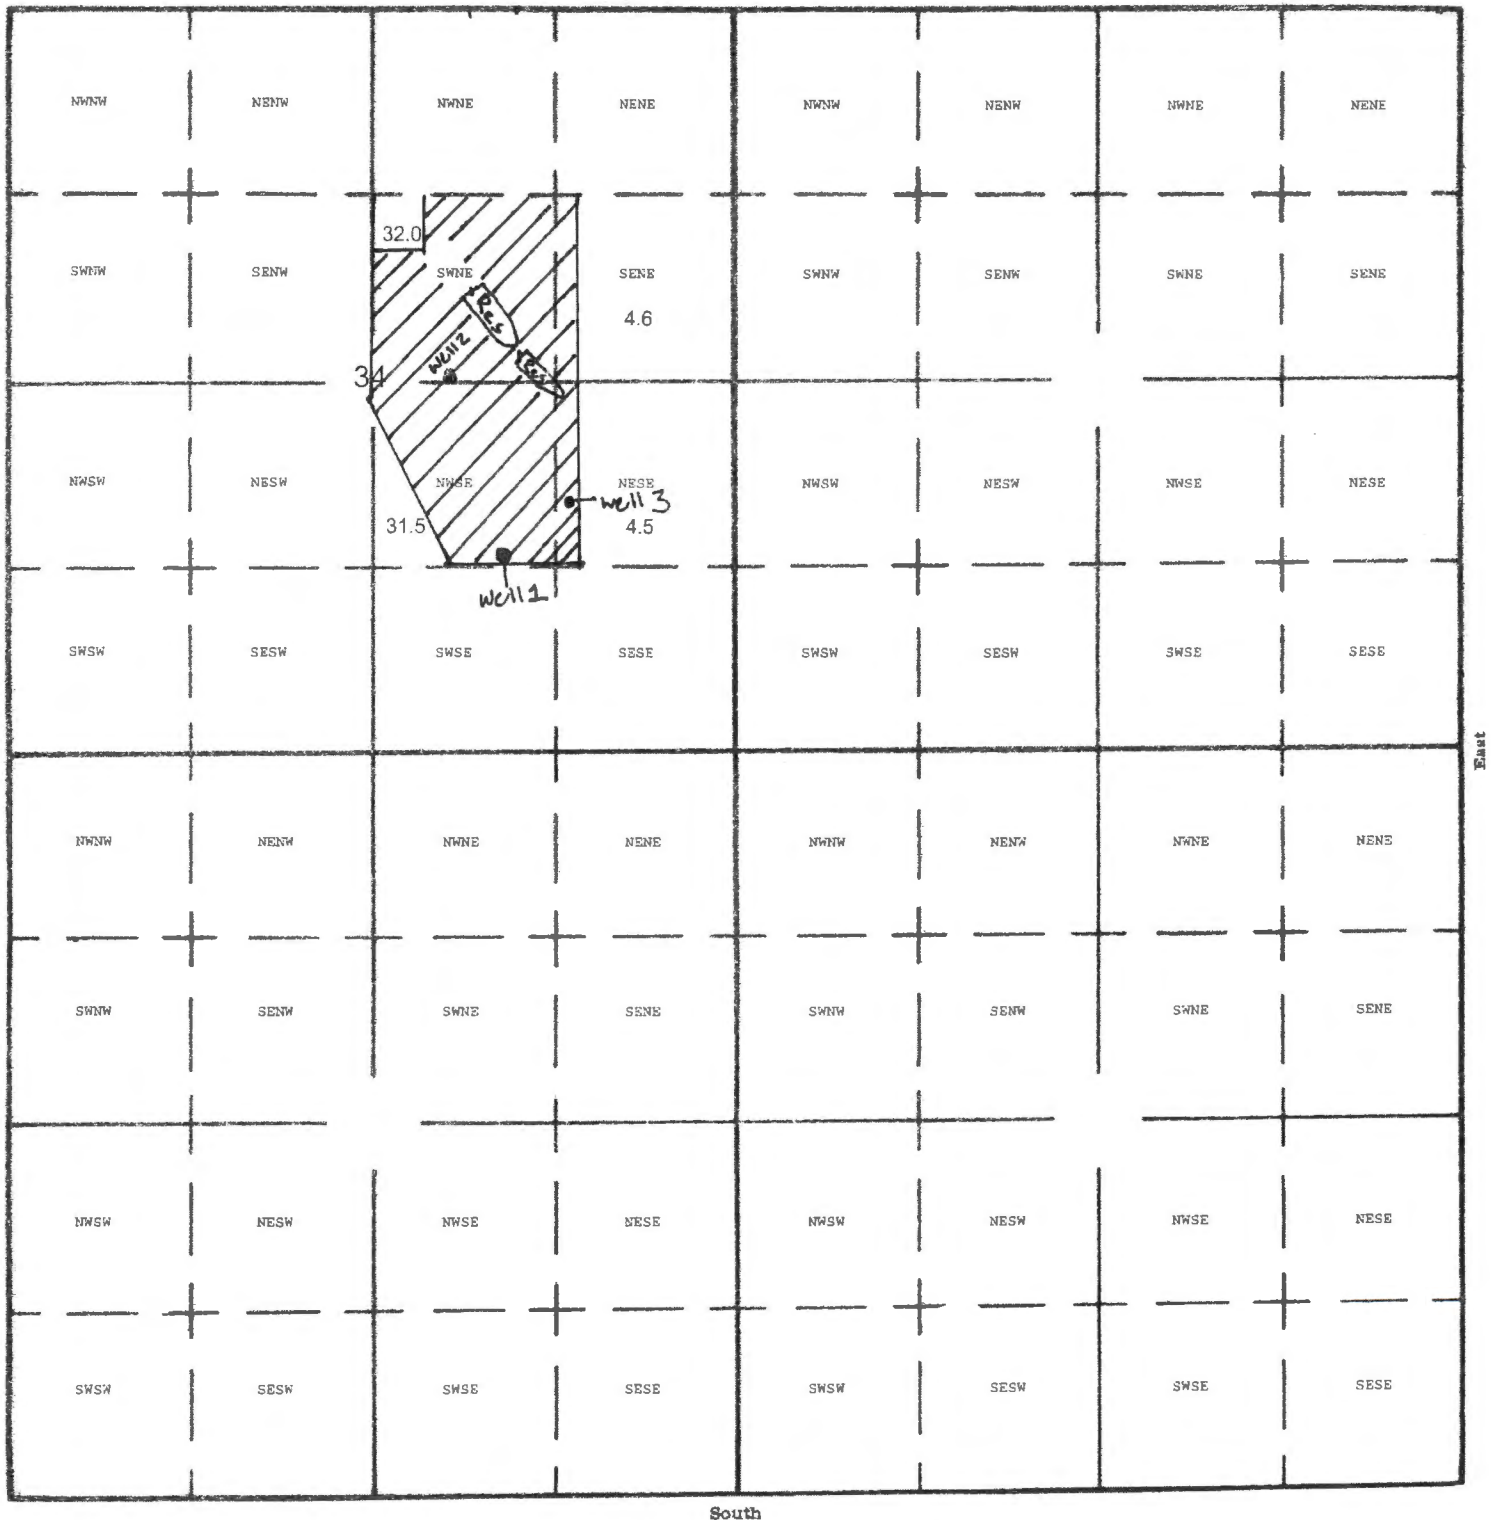

Well #1: (CLAC 12773) 3950 Feet South and 1665 Feet West from the NE Corner Section 34 Lat 45.17617 Long -12266757
Well #2: (CLAC 72276) 3950 Feet South and 1665 Feet West from the NE Corner Section 34
Well #3 Proposed Well: 3545 Feet South and 1200 Feet West from the NE Corner Section 34
North Dam #1: 1890 Feet South and 2050 Feet West from the NE Corner Section 34
North Dam #2: 2455 Feet South and 1600 Feet West from the NE Corner Section 34

R-88412

Amanda Staehely
7-6-16

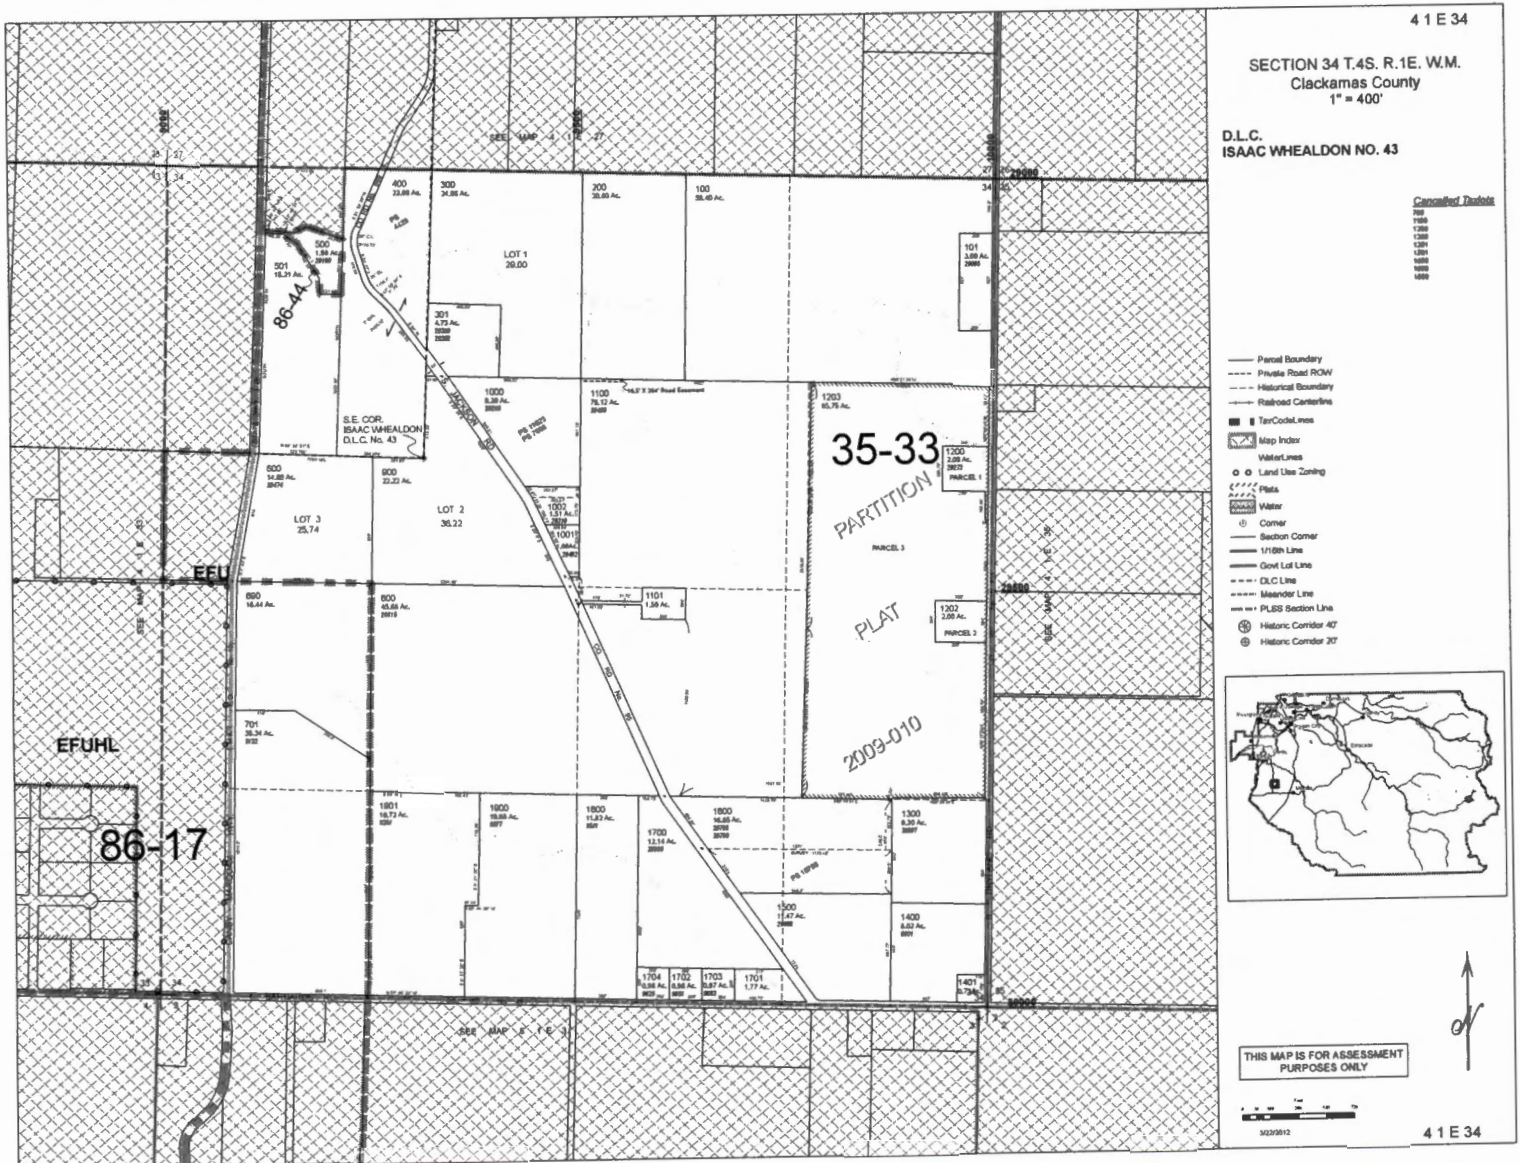

RECEIVED BY OWRD

MAY 15 2017

SALEM, OR

R-88412