

T1S, R4E Section 33
SW 1/4

Scale 1" = 500'

Center of dam is located
530' N, 1540' E
from the SW corner S 33


RECEIVED BY OWRD

MAY 11 2017

SALEM, OR



SW Corner Section 33

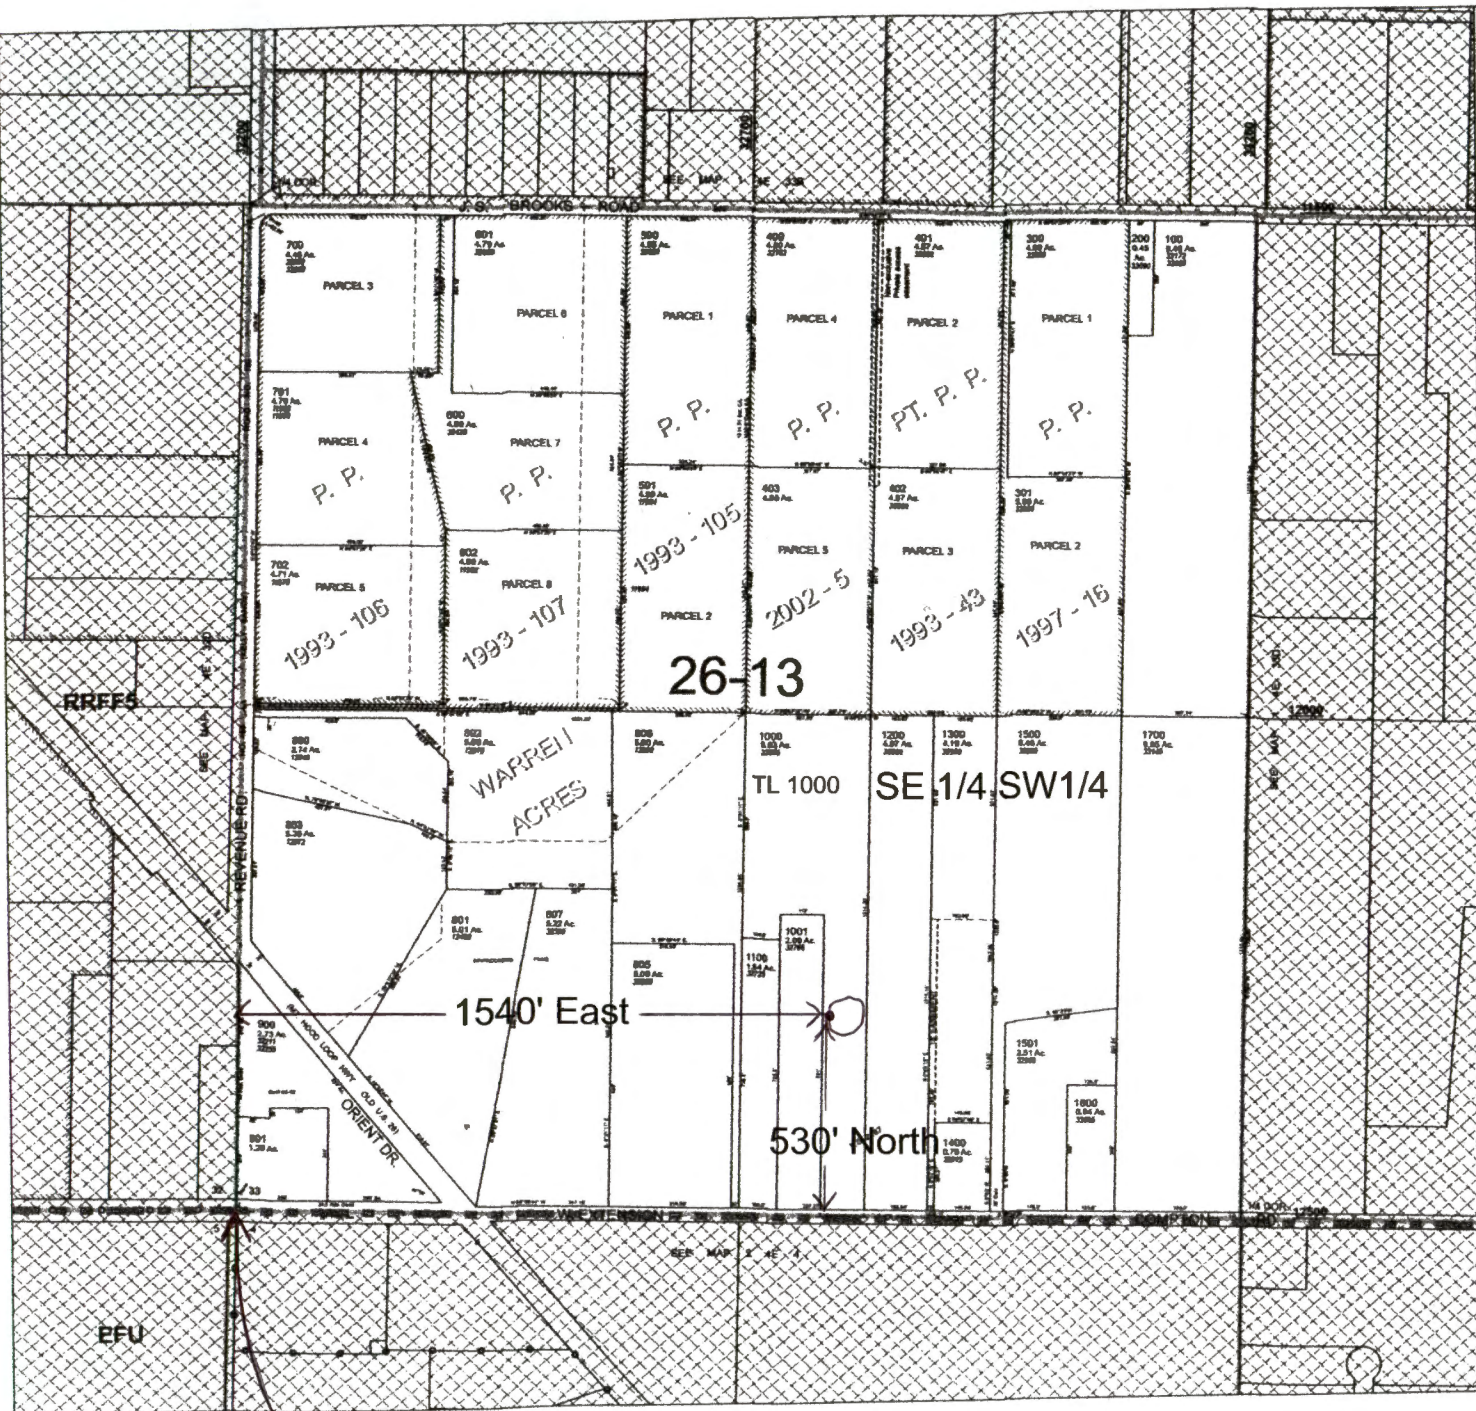

L-88413

RECEIVED BY OWRD
MAY 11 2017
SALEM, OR

