


Teeny Pond Water Right Map

1" = 1320'

Tax Lot:

Township 6 South, Range 1 East, Section 17, Tax Lot 1800 & 500

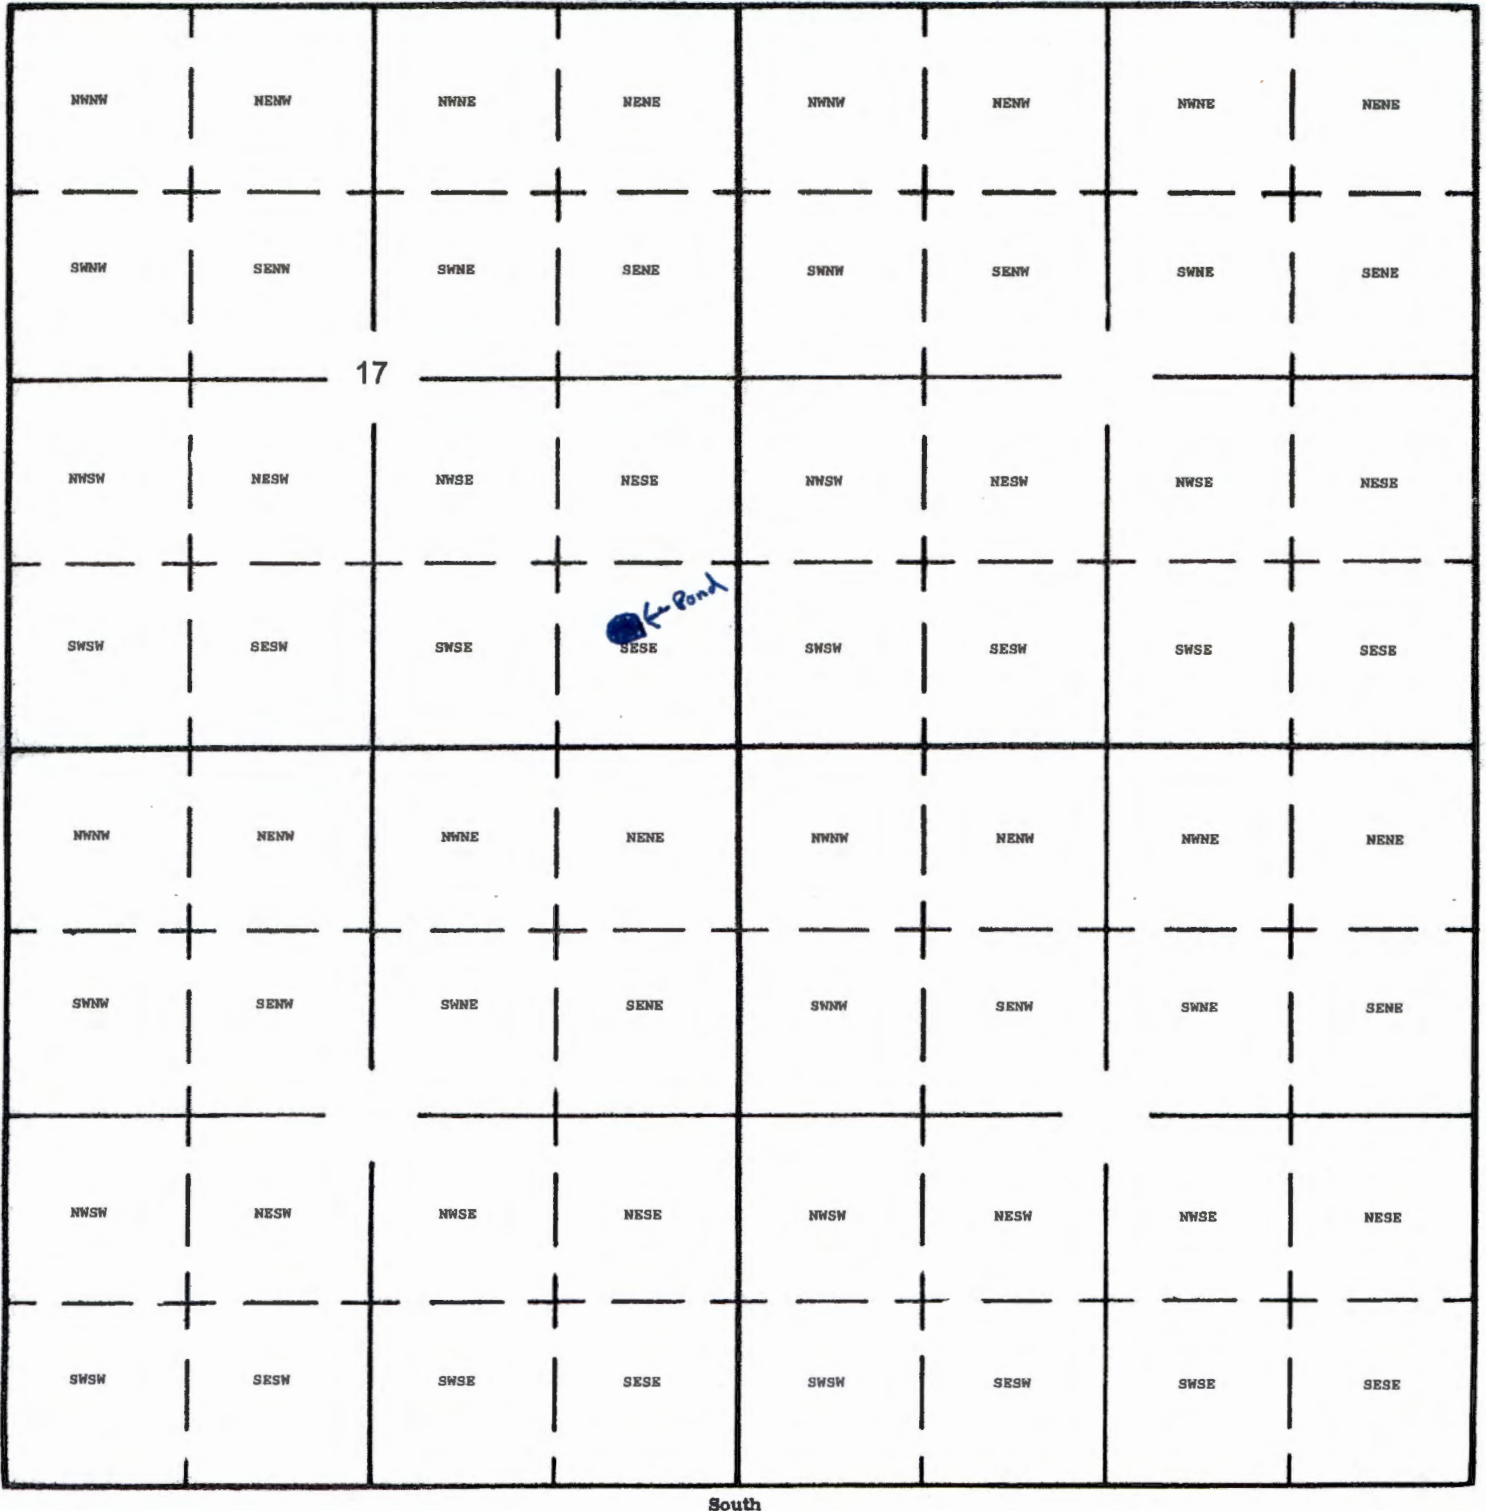

Dam Location: 850 North and 720 West from SE Corner Section 17

Ray Stapp 5-17-2017

RECEIVED BY OWRD

JUN 12 2017

SALEM, OR

R-88446

Oregon Water Resources Department
Water Rights Mapping Tool

[Main](#) [Help](#)
[Return](#) [Contact Us](#)

OWRD Only 725 Summer St NE, Salem, OR

Search

Identify Non-Water Right Features

Tax Lots

Identify Tax Lots [OR Map](#)

Off
 On

County: Null
 Taxlot: 061E17 01800
 Owner1: TEENEY, MITCHELL J
 Owner2:
 Owner Address: 13318 DOMINIC RD NE, MT ANGEL OR 97362
 Site Address: , , OR
 Acres: 20.8
 TRSQQ: Null
 Effective Date: January 1, 2016

Note: Tax lot information provided here is for general query purposes. It may not be up to date and may not be an official record. Please contact the respective county tax assessor's office for more current and specific information.

It is recommended to zoom to a detailed extent before query.

Tools

Layers

Bookmarks

POD POU Irrigation Districts AOI **WR By Time**

RECEIVED BY OWRD

JUN 12 2017

SALEM, OR

R-88916