


1" = 400'

9S
1W
SEC 15
6-18530



P. PLAT

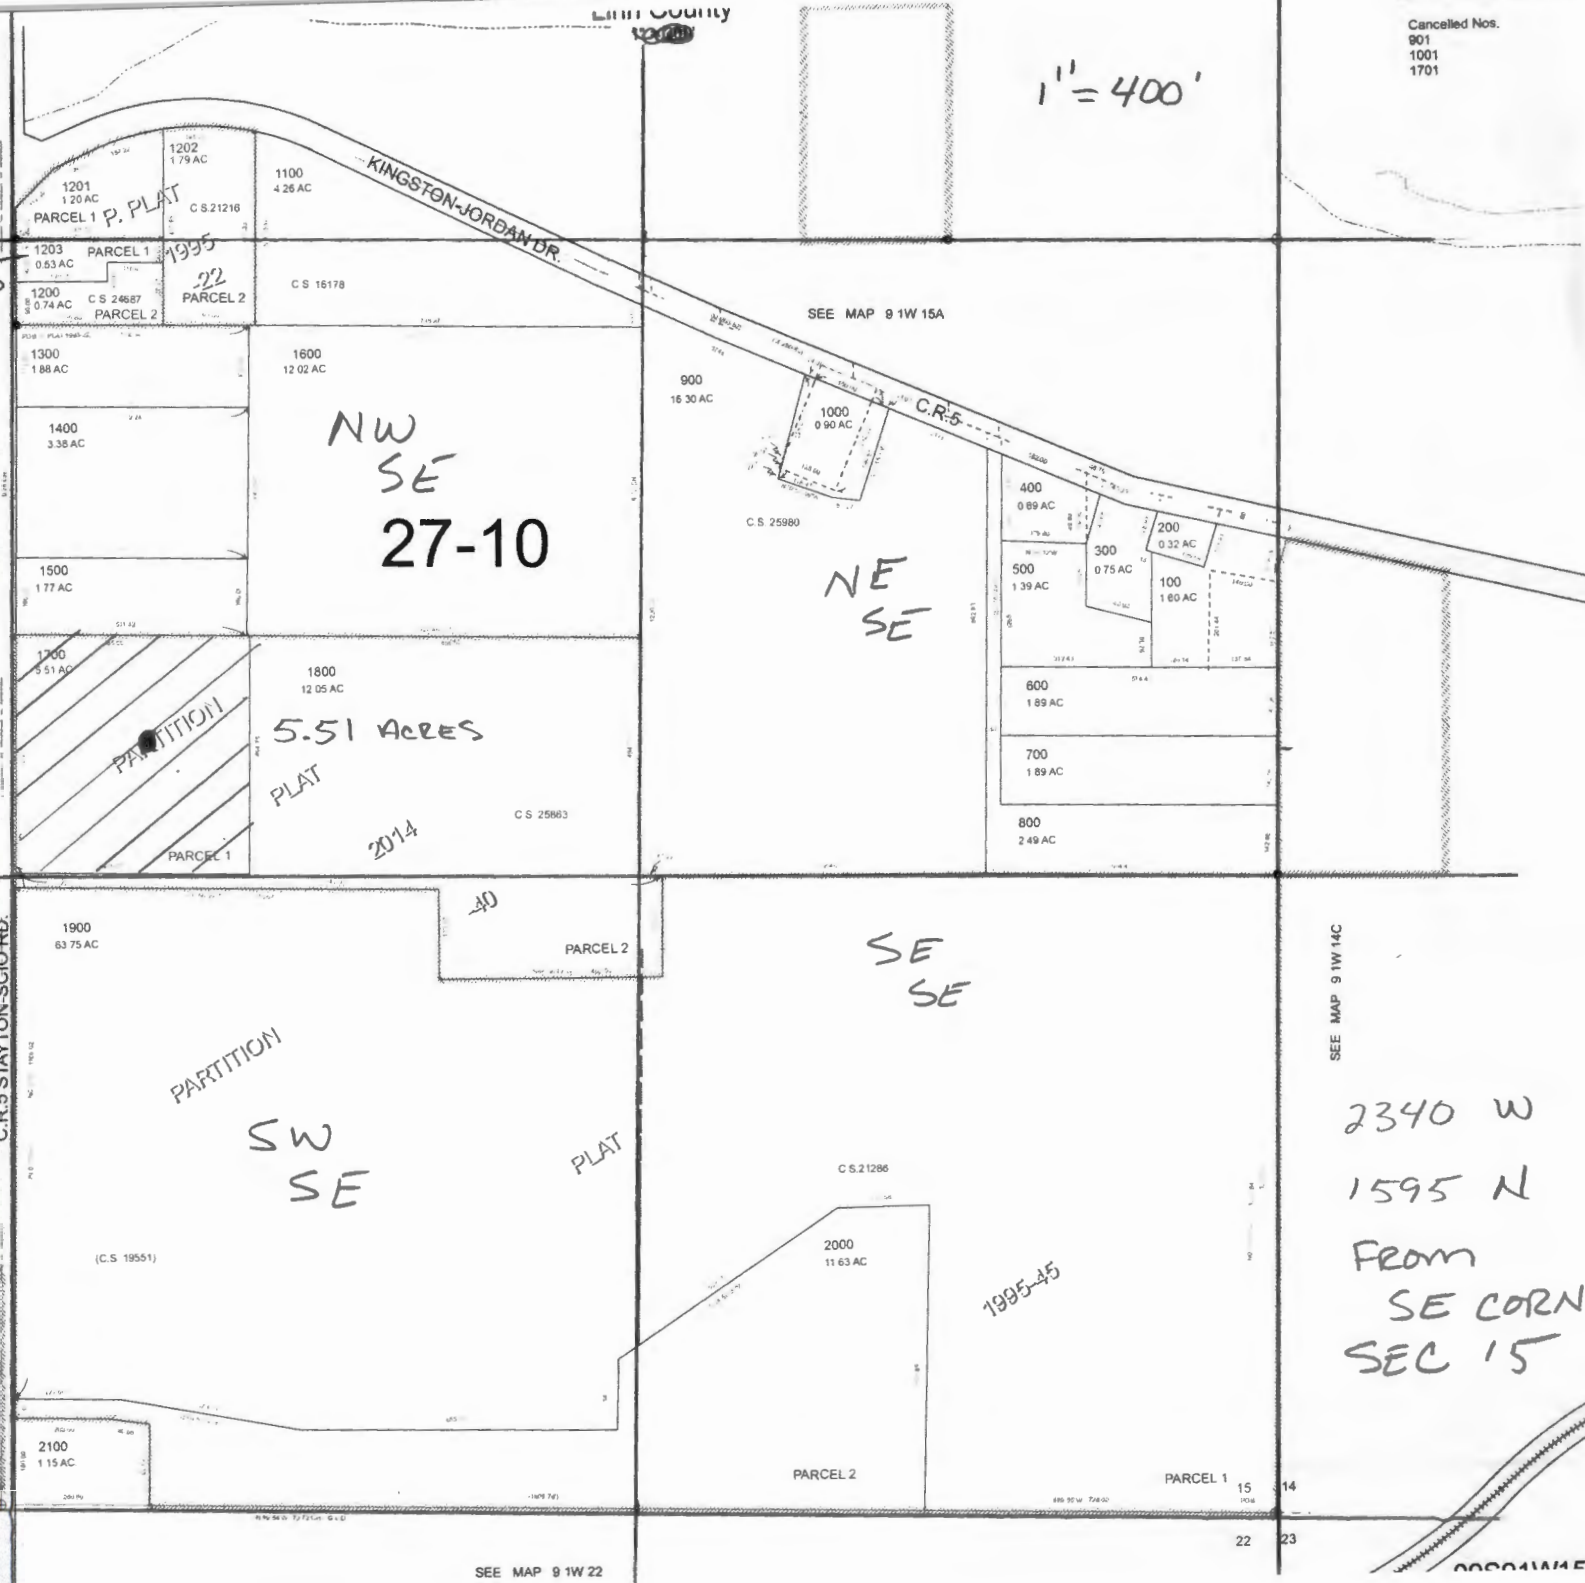

NW
SE
27-10

NE
SE

SE
SE

5.51 ACRES
PLAT
2014

PARTITION

SW
SE

PLAT

1995-45

2340 W
1595 N
FROM
SE CORN
SEC 15

RECEIVED

JUN 28 2017

OWRD

SEE MAP 9 1W 14C

SEE MAP 9 1W 15

C.R. 5 STAYTON-SCIO RD.

40

PARCEL 2

C.S. 21286

2000
11.63 AC

PARCEL 2

PARCEL 1 15

22

23