

SEE MAP 4 IE 14

86-17

RECEIVED BY OWRD

JUL 03 2017

SALEM, OR

RECEIVED BY OWRD


JUN 16 2017

SALEM, OR

E.F.U.-20

WELL LOCATED
FROM SW CORNER
SECTION 13
1310 FT. NORTH
550 FT. EAST

LL-1708

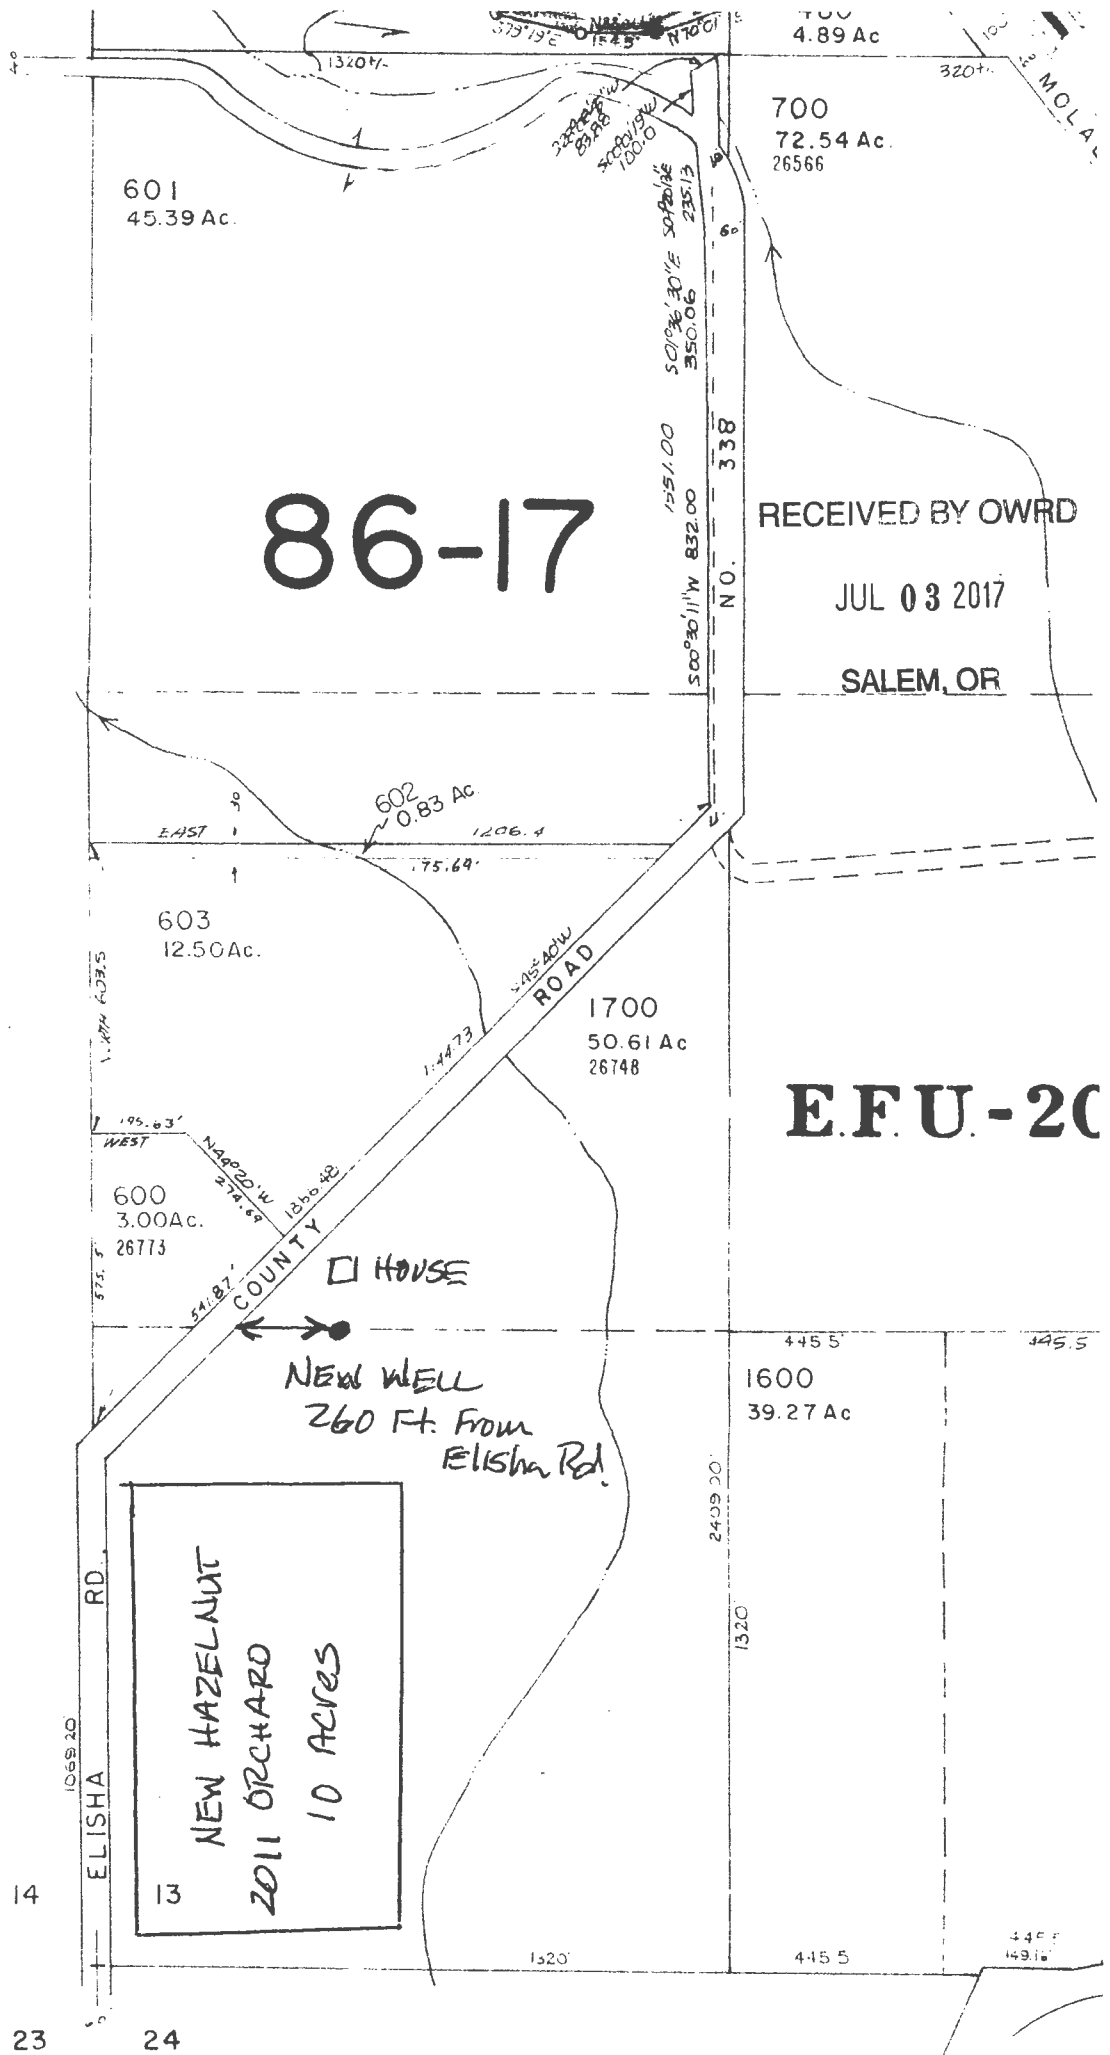

2000

Elisha Rd.

2011 Orchard

2013 orchard Jeffs

2013 orchard Dorris

2017 Orchard North

New well 2011

26748 S Elisha Road

2017 Orchard South

2017 Google

S-Motalla-Forest-Rd

S-Macksburg-Rd






Google earth

Imagery Date: 7/24/2016 45°13'01.73" N 122°38'02.80" W elev 234 ft eye alt 3886 ft

LC-1708

