

no photo

Permit No. 24818Application No. 31483County Lane**Proof of Appropriation of Water**

1. Name H. R. Oglesby 2. Address Veneta, Oregon

3. Source of supply Potaha Creek

Tributary of Wildcat Creek

4. Amount of water 0.38 cfs. 5. Priority date 10-1-60
April 11, 1957

6. Use irrigation 1/80 - 2 1/2

7. Location of point of diversion No. 1 NE 1/4 NE 1/4 18 18 S 7 W
No. 2 NE 1/4 NE 1/4 13 18 S 8 W, W. M.
(Legal Subdivision)

8. The description of land given below corresponds to that found in your permit covering land to be irrigated, or, if for other purposes, the place of use.

Township	Range	Section	Legal Subdivision	No. Acres Actually Irrigated
Willamette Meridian				
18 S	7 W	18	NE 1/4 NE 1/4	1 ✓
			NW 1/4 NE 1/4	7 ✓
			NE 1/4 NW 1/4	5 ✓
			Lot 1 (NW 1/4 NW 1/4)	9 ✓
18 S	8 W	13	NE 1/4 NE 1/4	8 ✓
				30

I have read the above and foregoing proof of appropriation of water; I know the contents thereof, and that the facts therein stated are true.

IN WITNESS WHEREOF, I have hereunto set my hand this day of

19.....

Inspected
C. Baker
May 9, 1962

REPORT OF PERSON MAKING INSPECTION

Description of works:

Diversion Point- New point, located on application map. The ~~div~~ point measured 660ft south and 700ft east of sec corner ¹²⁷/₁₃₁₈. At this point the owner has two pumps. The 5Hp handles the west end of the land, while the 7½Hp pump handles the east end of the property. The pumps operate directly out of Potaha Creek Tributary of Wildcat Creek

Pumps (1) Rain Flow Model 1¼ W 5 2, 1½"x1¼" direct Centrifugal
(2) Gardner Denver 3" B model, 4"x3" direct Centrifugal.

Motors (1) 5Hp, 1Φ, General Electric
(2) 7½Hp, General Electric, 1Φ, 1760 RPM

Pipe- 1160' 6" Main Line; 2000' 5" Main Line, 1340' Main Line
1220' 4" perforated Lateral; 580' 2" Lateral

Sprinkler Heads- 16 Buckner Rainer Model 860, single 12 nozzle,

Crop- Pasture

Total Lift- 40 feet approx.

Information: H.R. Oglesby (District Forester). Owner claimed to have irrigated land last season. The application map checked okay so accepted it on an inspection basis.

I, Carl R. Baker, do hereby certify that I have made an inspection of the works described herein and in Permit No. 24818, on the 9 day of May, 1962, and found the foregoing statements and descriptions of works to be accurate. In my opinion the appropriation has been completed to the extent of _____ and I recommend the issuance of water right certificate for this amount.

(Quantity of water in second-feet or acre-feet)


NOTICE TO INSPECTORS

If conditions do not justify the above report by you, please return this form without your signature, with a full report by letter.

Carl R. Baker
(Name)
Field Engineer
(Title)

H. R. Oglesby

▲

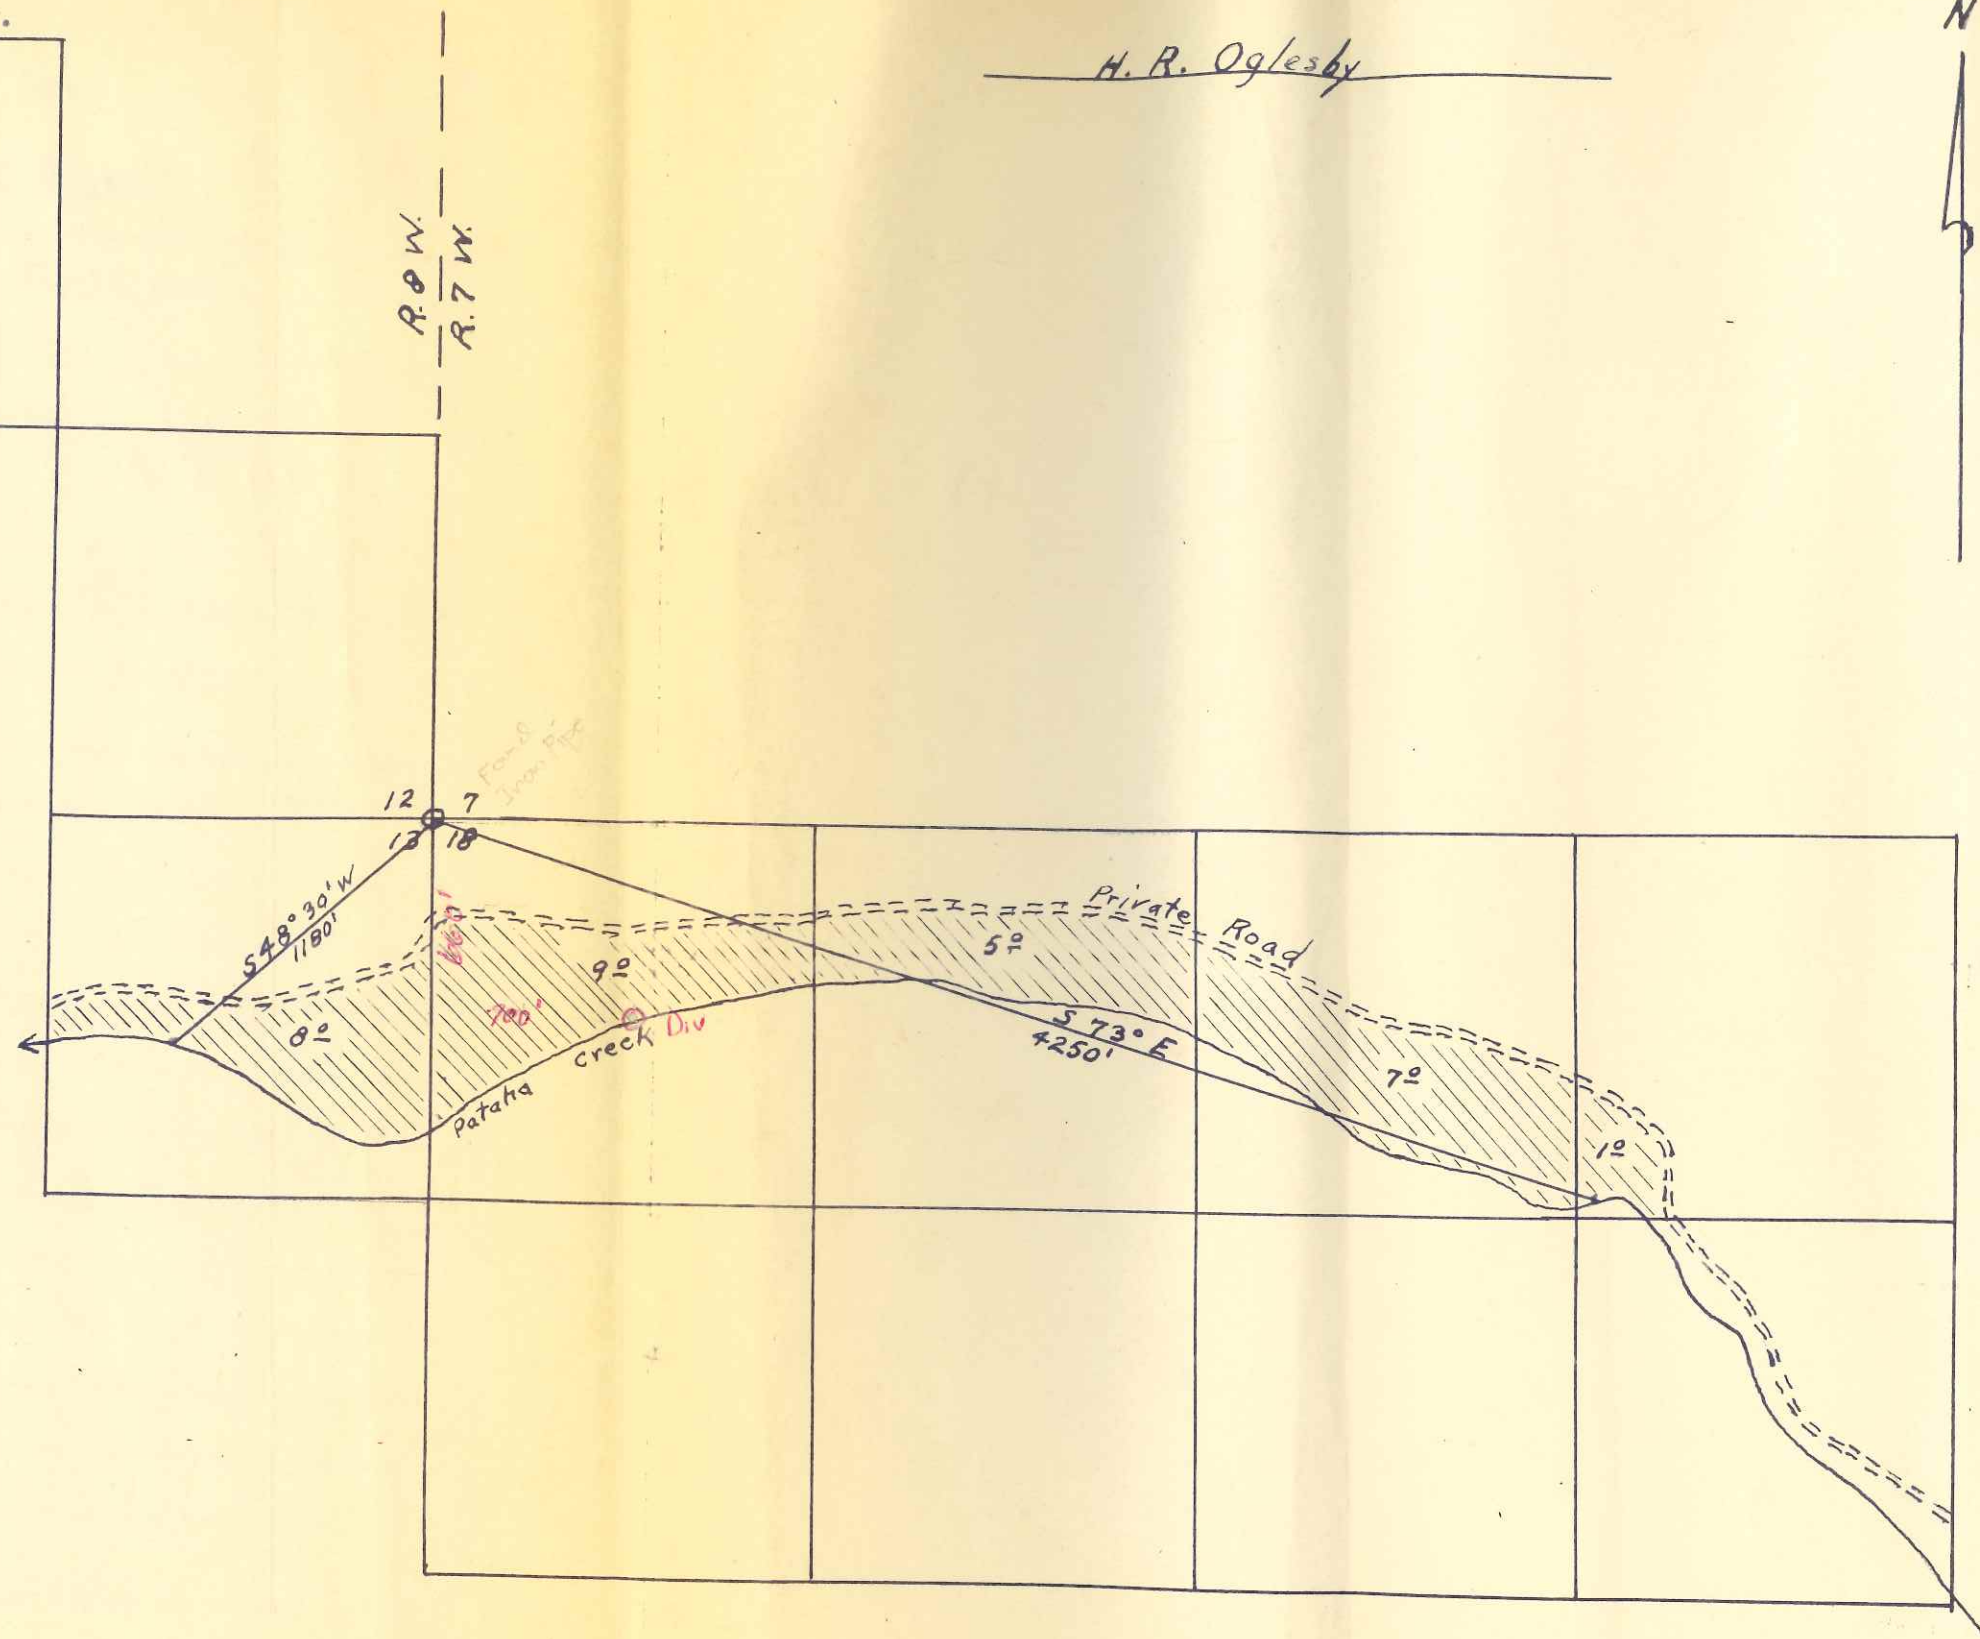

Scale: $1'' = 660'$
 $8'' = 1 \text{ mile}$

Application No. 31483
Permit No. 24818