


Application Map for Brett J. Austin

Township 8 South, Range 44 East, Section 18, Tax Lot 4301, W.M.

Scale = 4" to the Mile
1" = 1320'

THIS MAP WAS PREPARED FOR
ASSESSMENT PURPOSE ONLY

DETAIL MAP NO. 1
T.8S. R.44E. W.M.
BAKER COUNTY

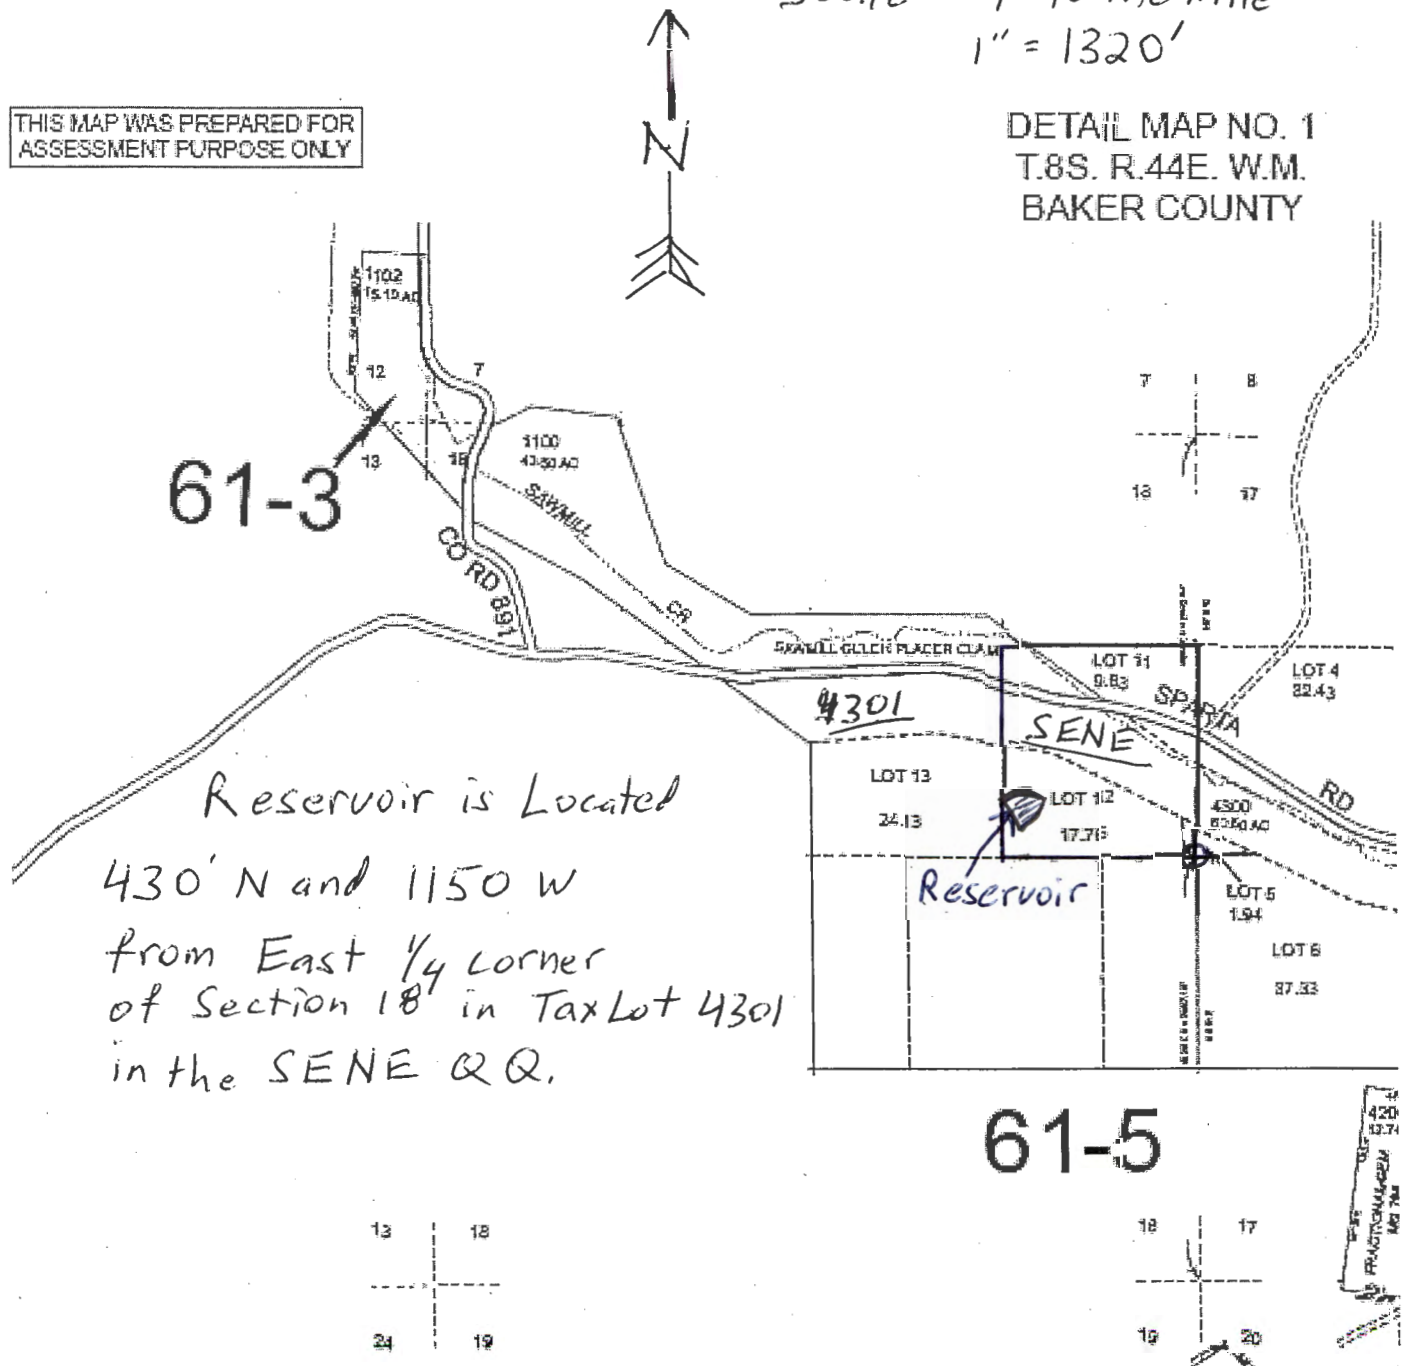


RECEIVED BY OWRD

JUL 10 2017

SALEM, OR

R-88424

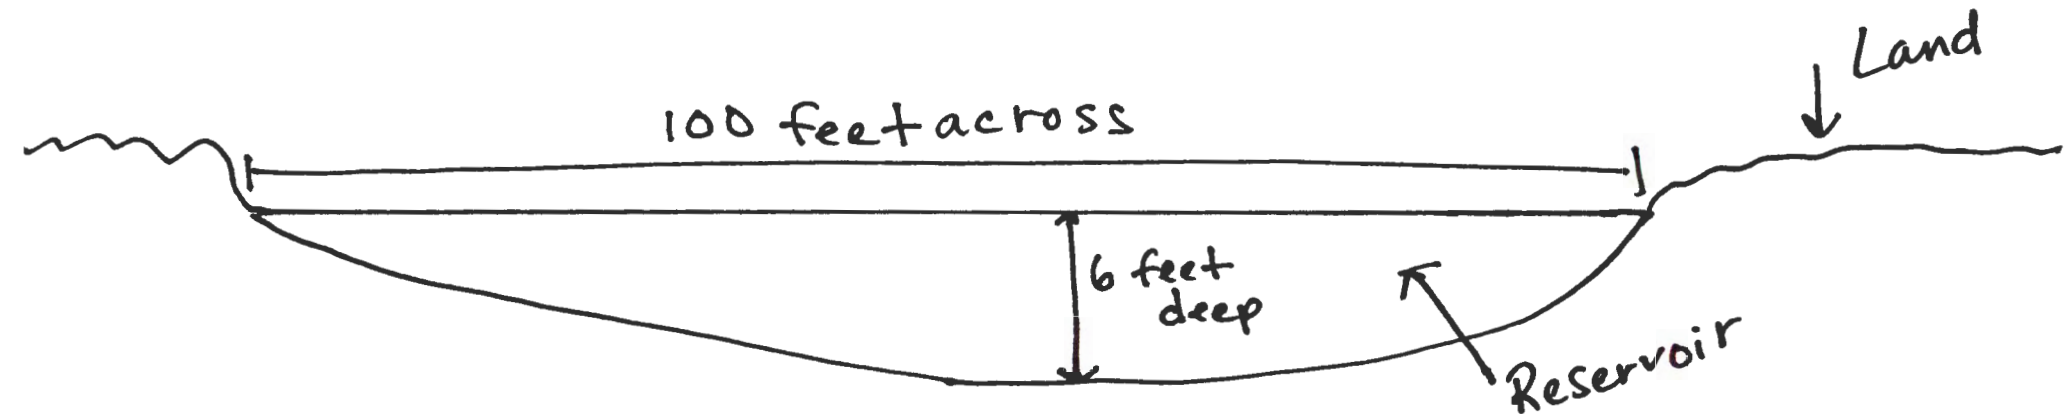

RECEIVED BY OWRD

JUL 10 2017

SALEM, OR

Brett Austin
attachment to
Reservoir Application

12488-21