


Map # 2 of 2

T.15S., R.5W., W.M.
Section 6

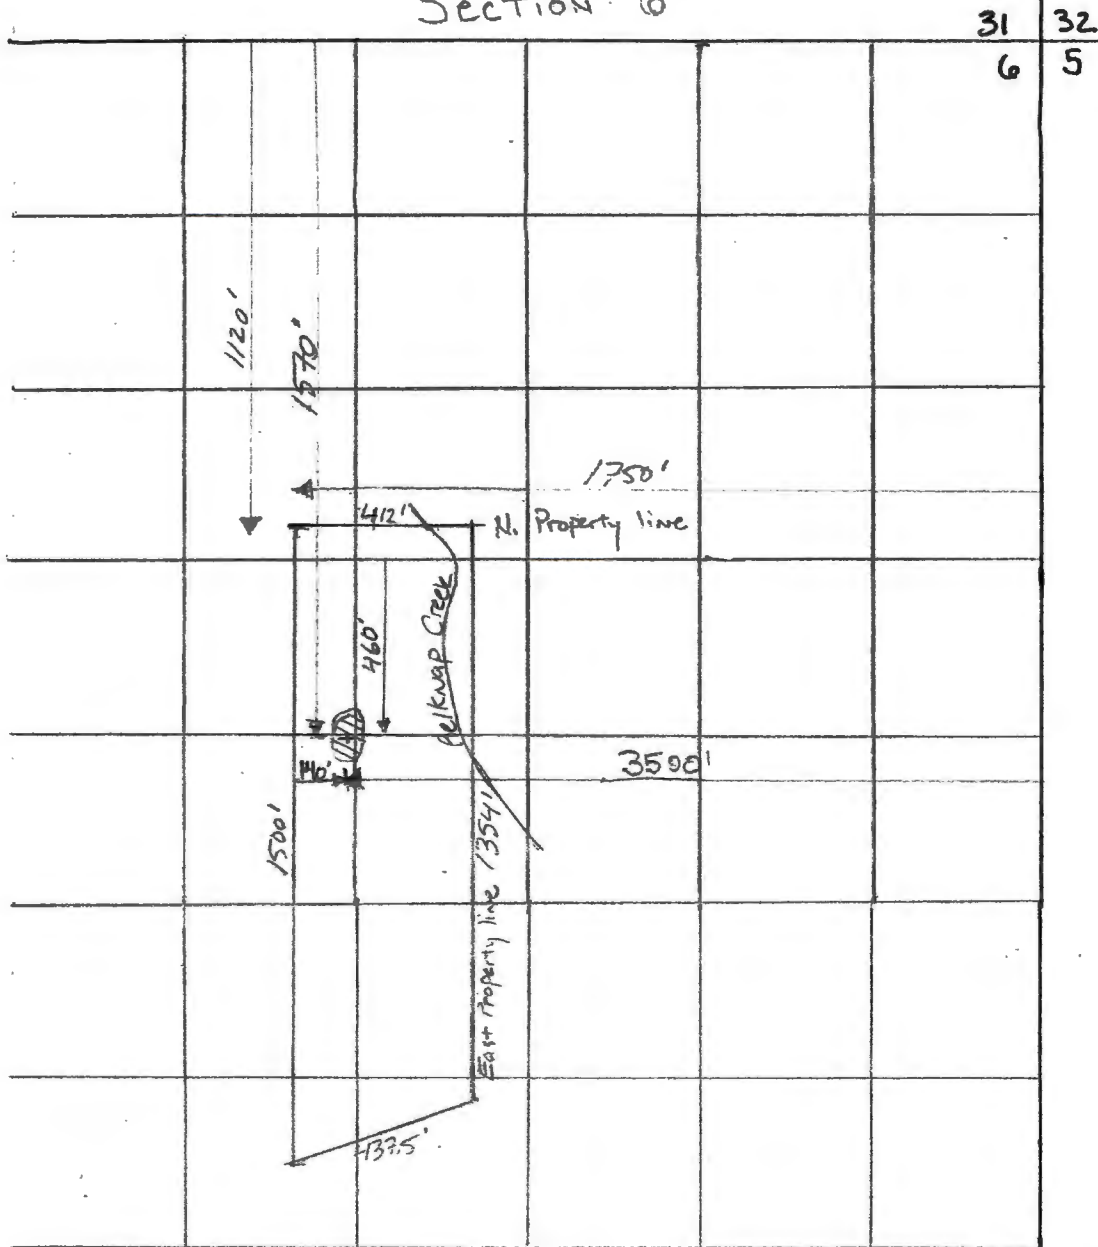

Scale: 1" = 400'

The ~~reservoir~~ is located in the middle
of NE 1/4 Section 6, T 15 S, R5W
of the Willamette Meridian; 1570' South
and 3500' West from the east corner between
Sections 6 and 31

RECEIVED BY OWRD

JUL 14 2017

R-00420

SALEM, OR

Map # 1 of 2


THIS MAP WAS PREPARED FOR
ASSESSMENT PURPOSE ONLY

SECTION 6 T.15S. R.5W. W.M.
BENTON COUNTY
1" = 400'

0 200 400 Feet

15506

REV: 08-27-2012
CANCELED:
1901
803
809
1202
1203

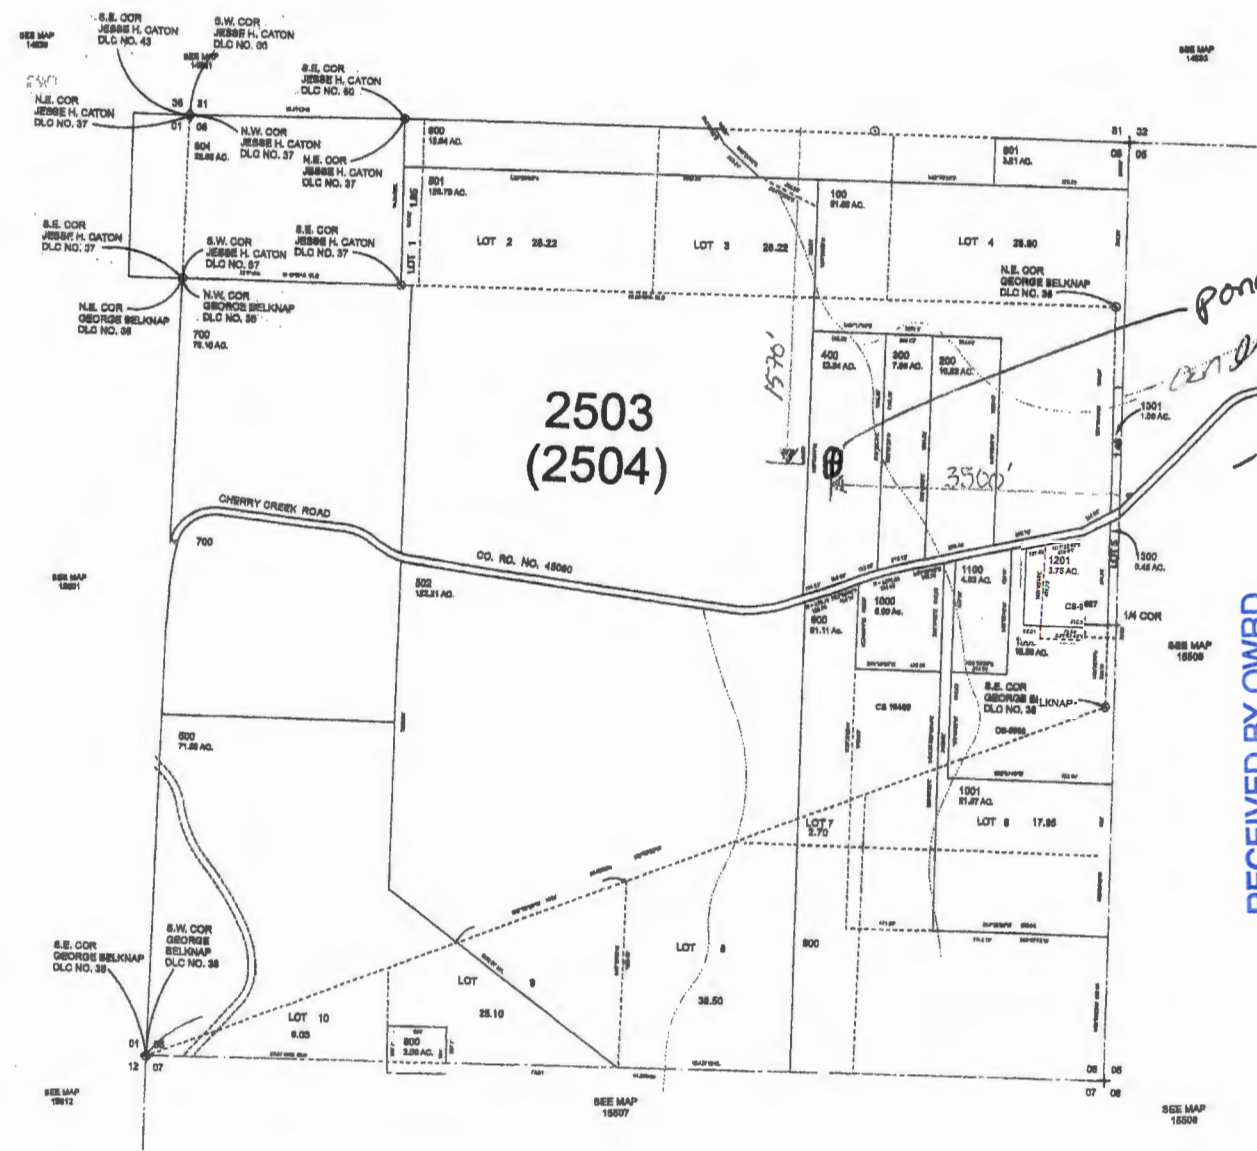

*Pond location
an existing
pond
- runoff fed*

RECEIVED BY OWRD

JUL 14 2017

SALEM, OR

15506

R-88428