


1" = 400'

T. 26 S., R. 8 W., SEC. 1

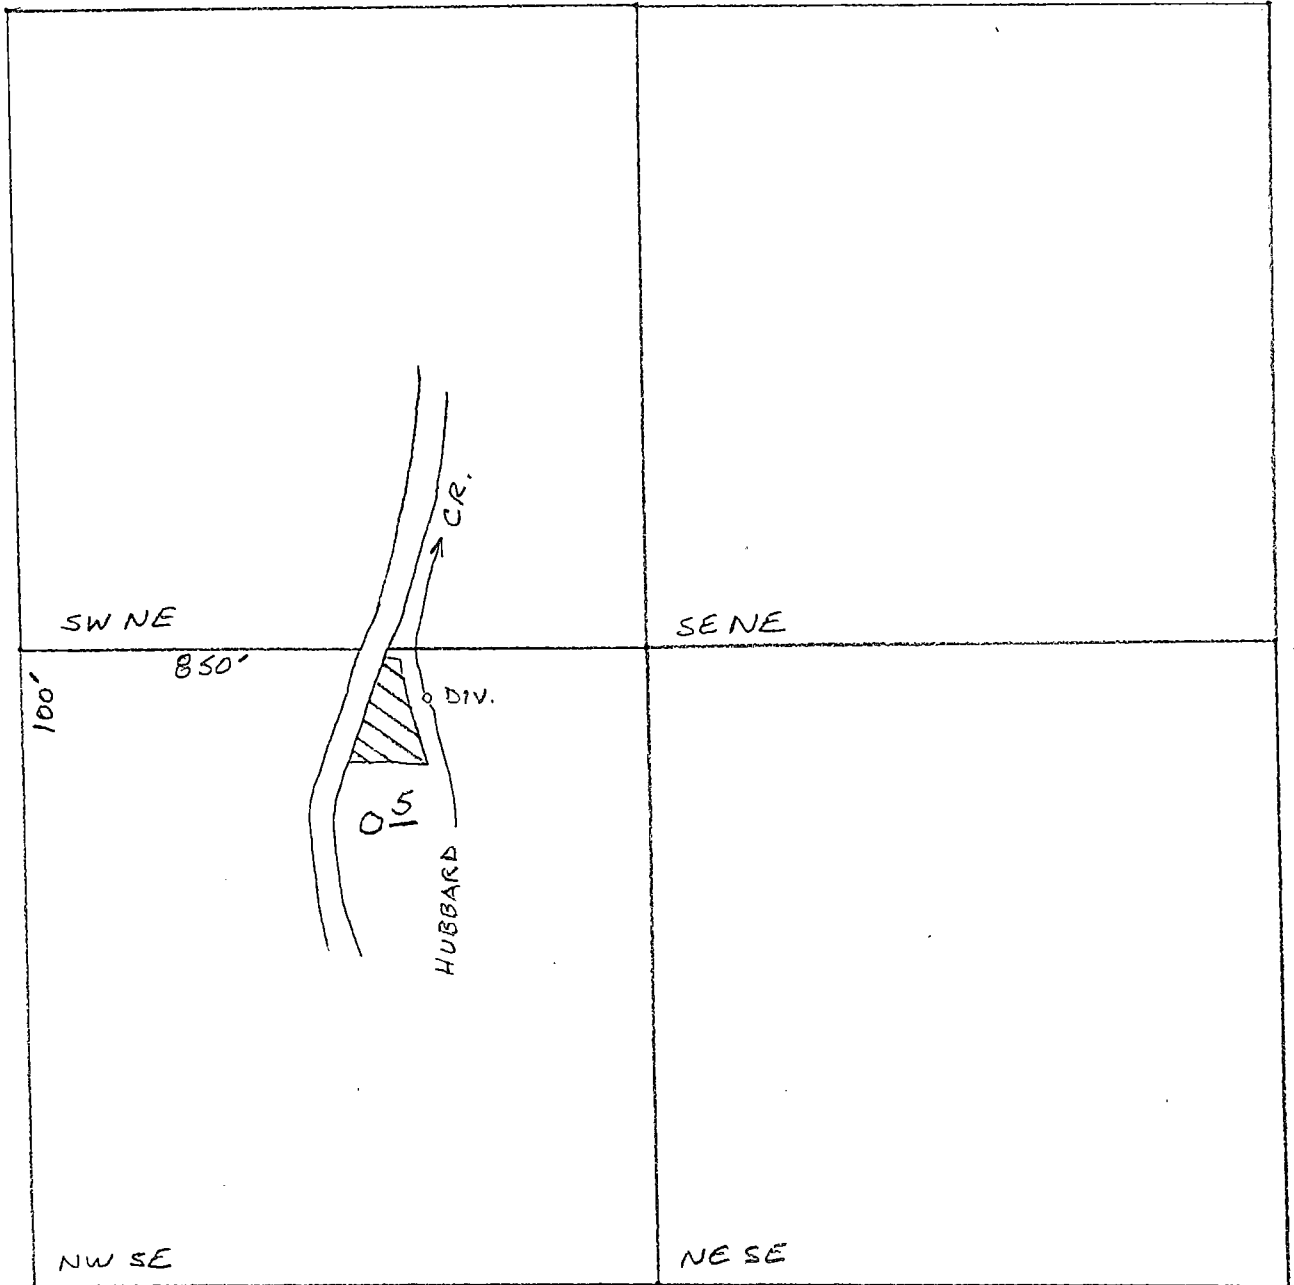

Application No. 65518
Permit No. 47774

RECEIVED
AUG 9 1993
WATER RESOURCES DEPT.
SALEM, OREGON