


1" = 1320'

Tax Lot: 352W01-00600

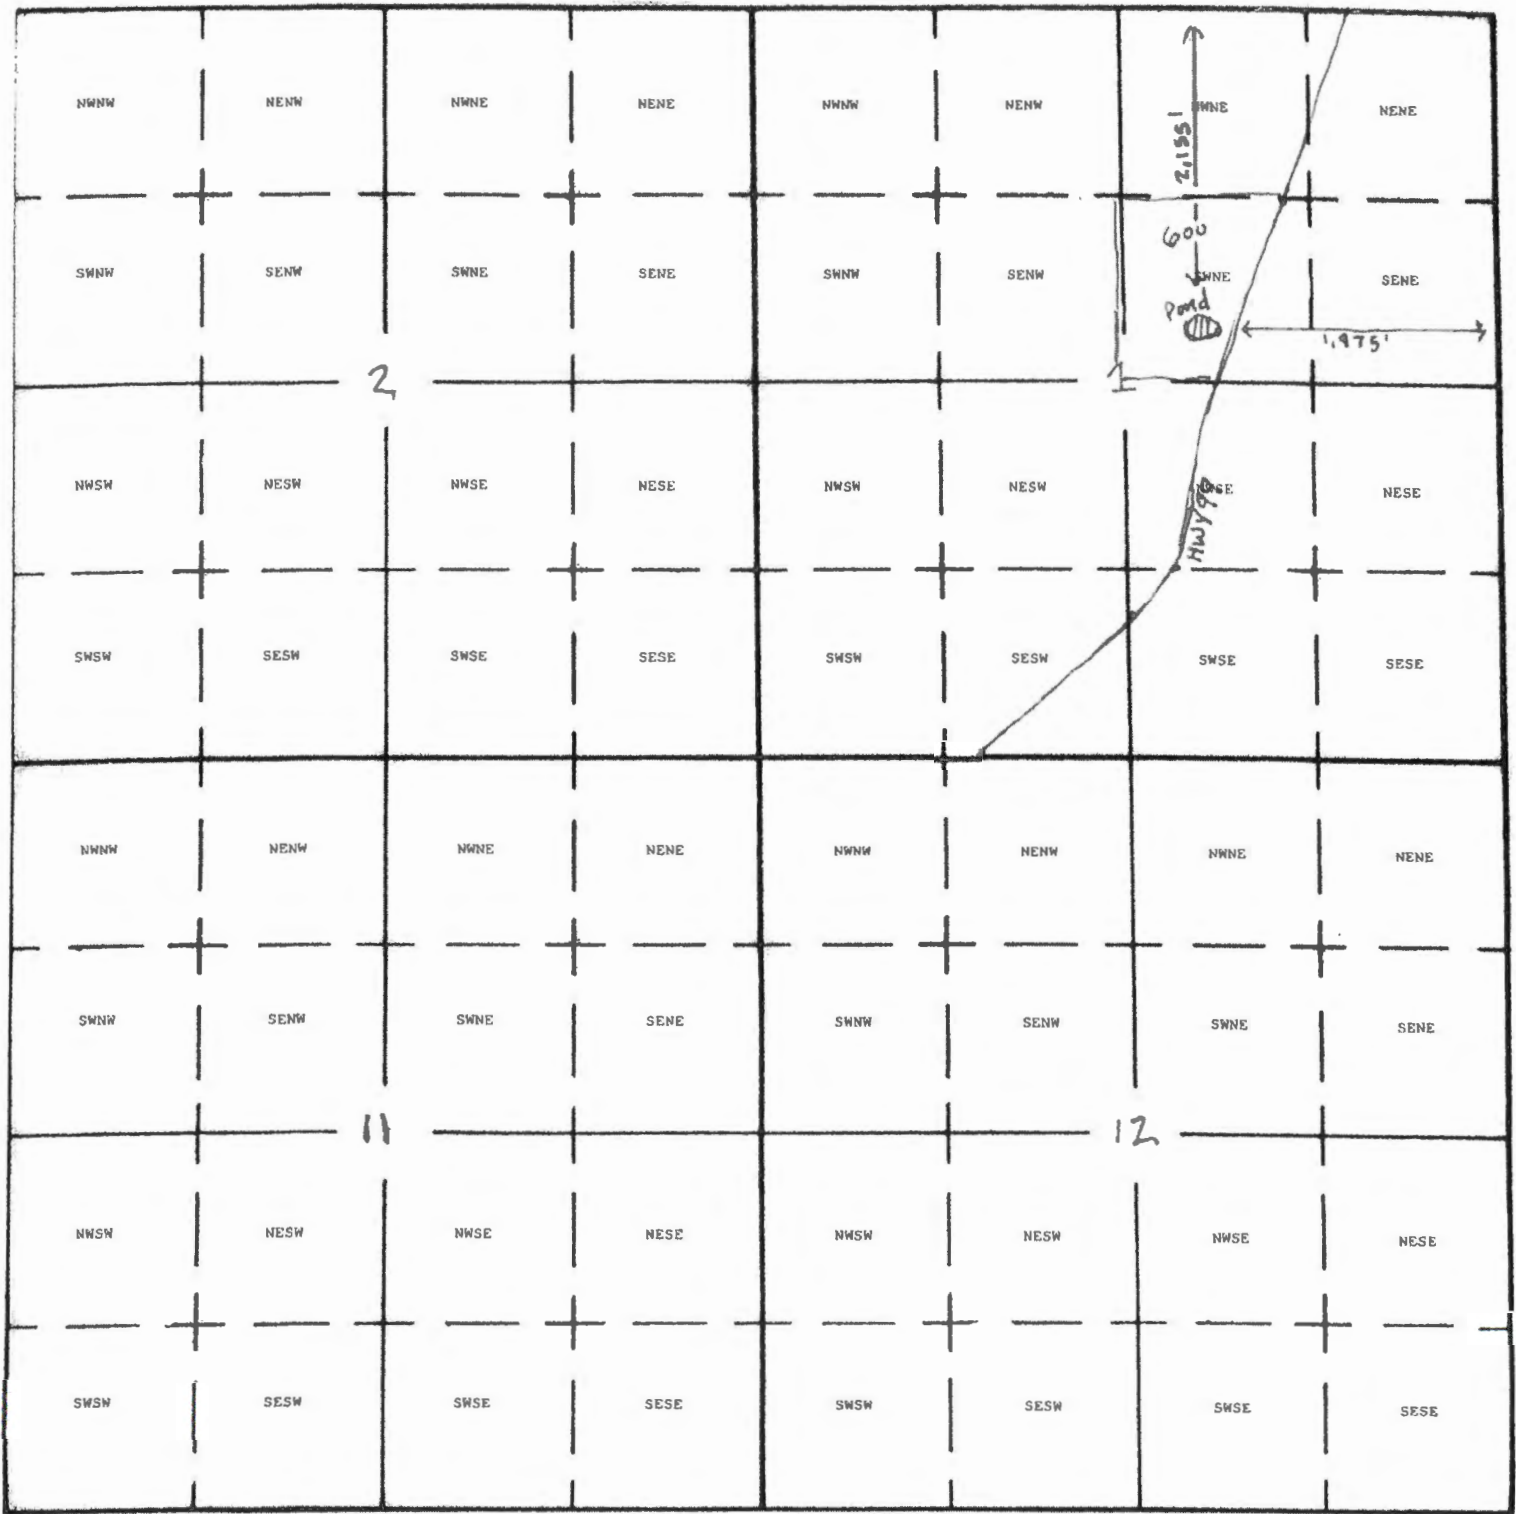


Pond Location = 1,975 feet east and 2,155 feet south of the northeast corner of section 1.

RECEIVED

JUL 27 2017

R-88430

OWRD

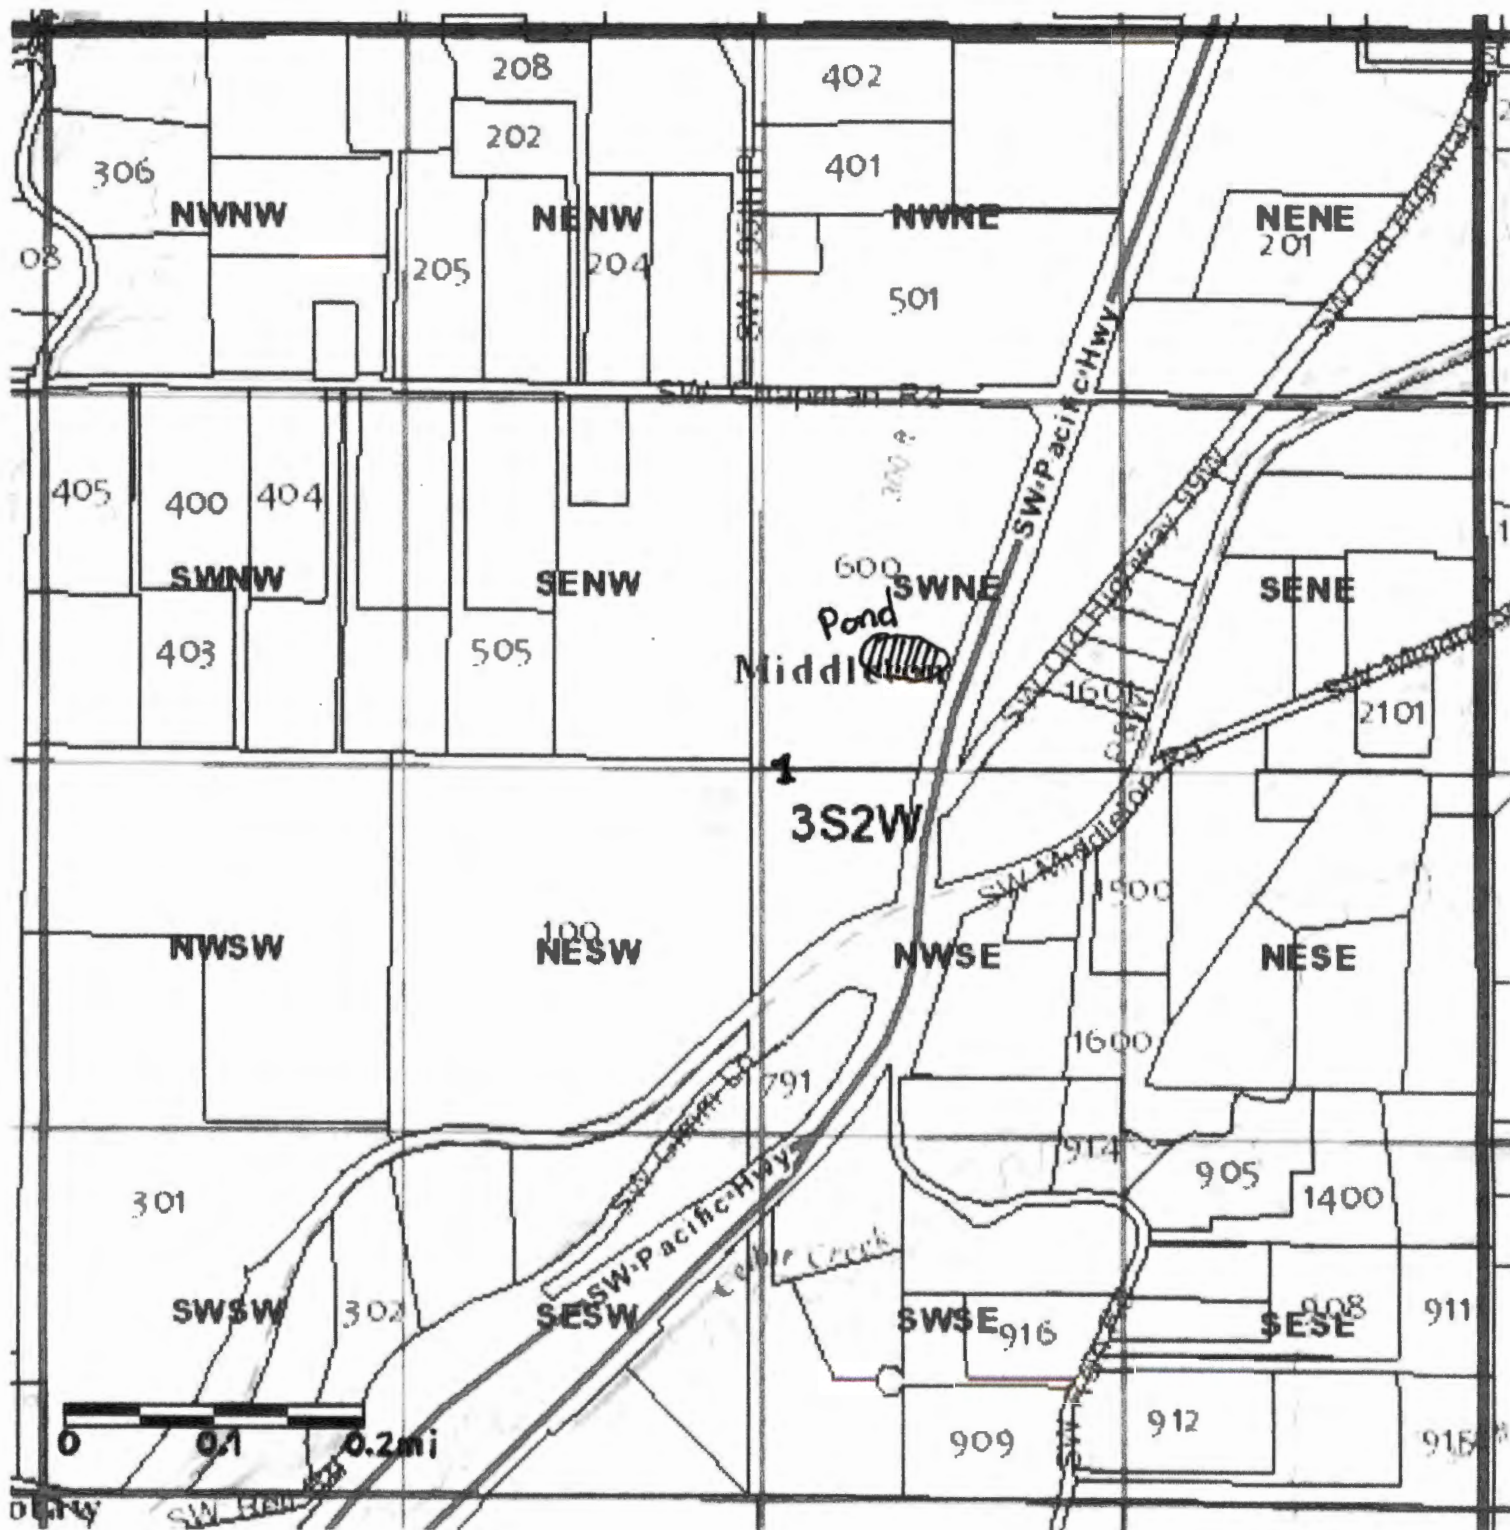

RECEIVED BY OWRD

JUL 24 2017

SALEM, OR