


S.E. 1/4 SEC. 33 T.1S. R.4E. W.M.
CLACKAMAS COUNTY
1" = 200'

Cancelled Taxlots

401
1300
1400
2200
2301

- Parcel Boundary
- Private Road ROW
- Historical Boundary
- Railroad Centerline
- TaxCodeLines
- Map Index
- WaterLines
- Land Use Zoning
- Plats
- Water
- Corner
- Section Corner
- 1/16th Line
- Govt Lot Line
- DLC Line
- Meander Line
- PLSS Section Line
- Historic Corridor 40'
- Historic Corridor 20'

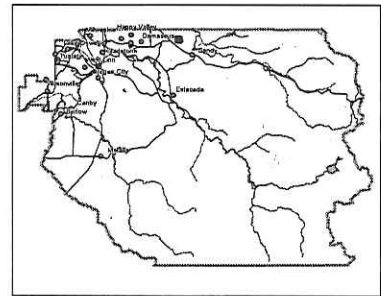

THIS MAP IS FOR ASSESSMENT
PURPOSES ONLY





Google earth





Oregon Water Resources Department Water Rights Mapping Tool

Home Main
OWRD Only
Return Contact Us

12950 S Butte Creek Rd.



Search

Identify Non-Water Right
Features

Tax Lots

Identify Tax
Lots

[OR](#)
[Map](#)

- ☐ Off
☒ On

County: Null

Taxlot: 14E33D 01400

Owner1: FUGERE DIONE M &
ANDREW C WEBBER

Owner2:

Owner Address: 31109 SE DIVISION
DR, TROUTDALE OR
97060

Site Address: 33685 SE COMPTON
RD, BORING 97009

Acres: 5.1

TRSQQ: Null

Effective Date: January 1, 2016


Note: Tax lot information provided here
is for general query purposes. It may not
be up to date or may not be an official
record. Please contact the respective
county tax assessor's office for more
current and specific information.

It is recommended to zoom to a detailed
extent before query.

Tools

Layers

Bookmarks

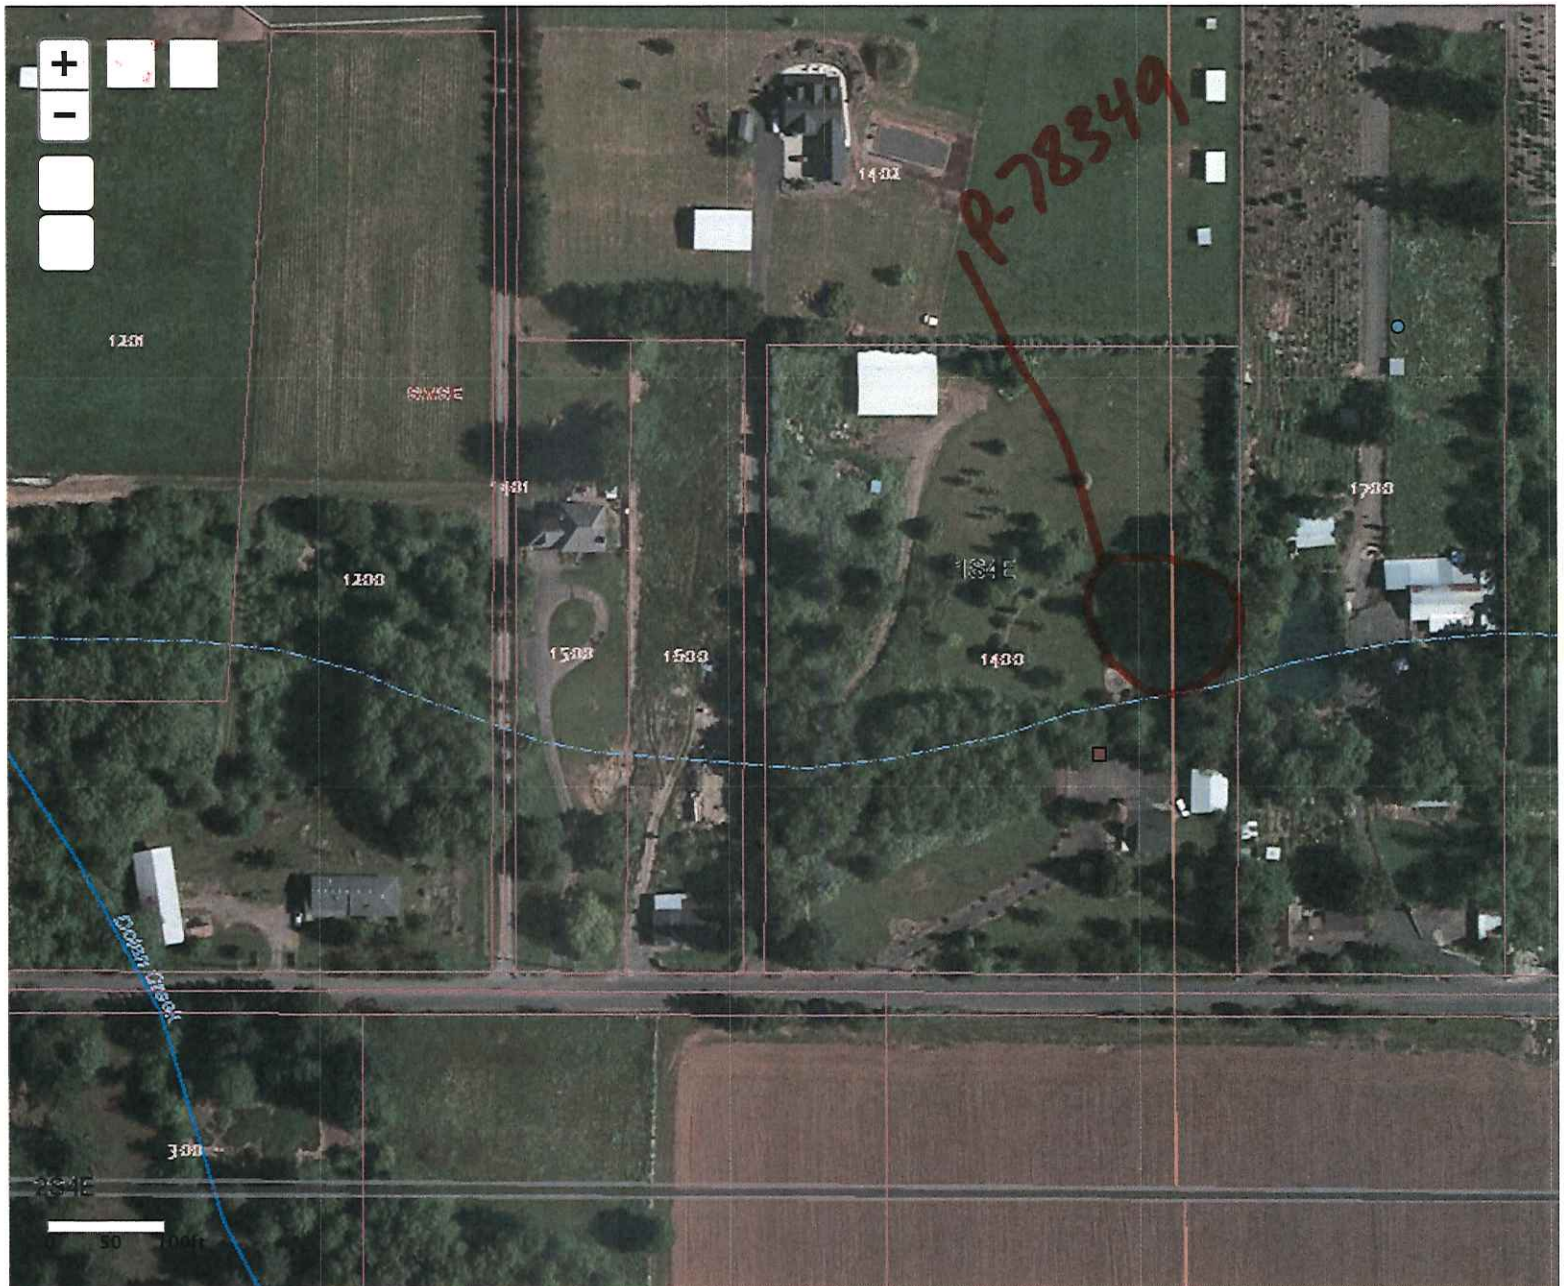

POD

POU

Irrigation Districts AOI

WR By Time



Oregon Water Resources Department Water Rights Mapping Tool

Home Main
OWRD Only
Return

12950 S Butte Creek Rd.

Contact Us

Search

Identify Non-Water Right
Features

Tax Lots

Identify Tax
Lots

[OR](#)
[Map](#)

☐ Off
☒ On

County: Null

Taxlot: 14E33D 01400

Owner1: FUGERE DIONE M &
ANDREW C WEBBER

Owner2:

Owner
Address: 31109 SE DIVISION
DR, TROUTDALE OR
97060

Site Address: 33685 SE COMPTON
RD, BORING 97009

Acres: 5.1

TRSQQ: Null

Effective Date: January 1, 2016


Note: Tax lot information provided here
is for general query purposes. It may not
be up to date or may not be an official
record. Please contact the respective
county tax assessor's office for more
current and specific information.

It is recommended to zoom to a detailed
extent before query.

Tools

Layers

Bookmarks

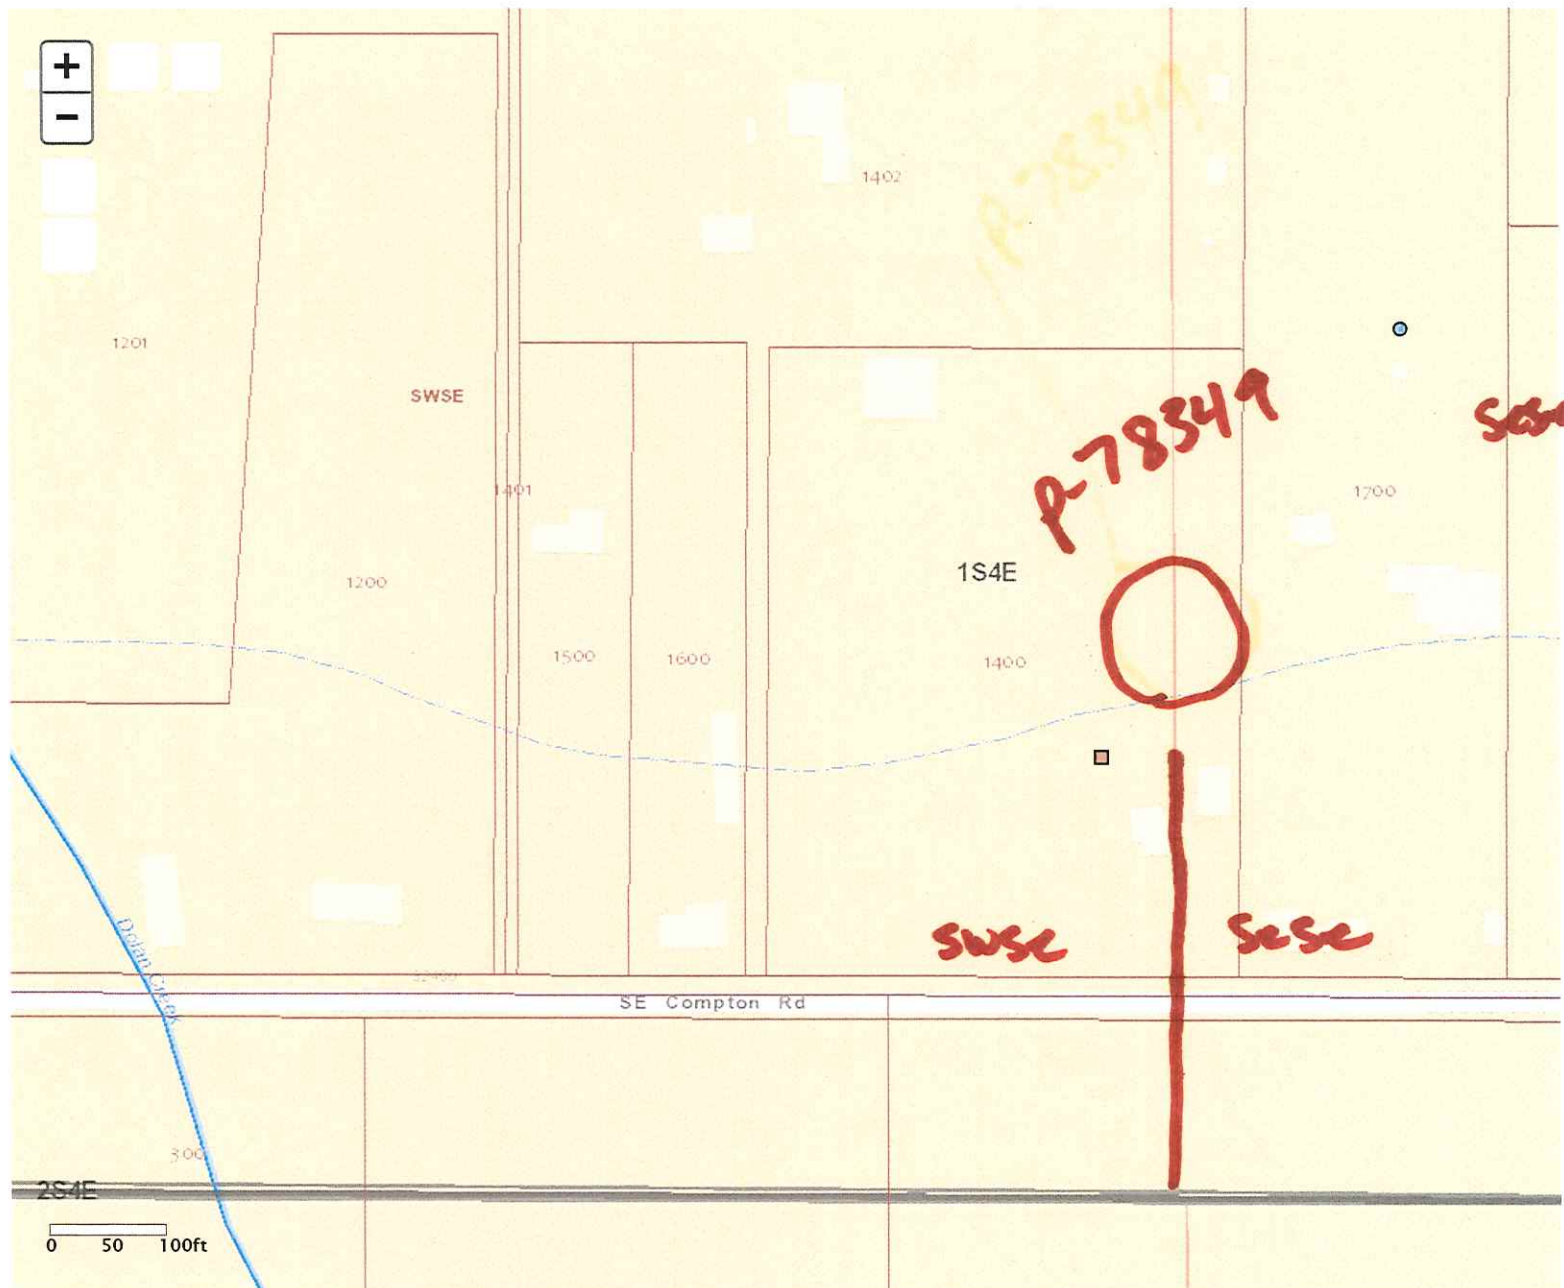

POD

POU

Irrigation Districts AOI

WR By Time

Application No. P-78349
Permit No.

RECEIVED
DEC 16 1994
WATER RESOURCES DEPT.
SALEM, OREGON

December 12, 1994

Water Rights Division/ HB 2153
Water Resources Department
3850 Portland Road NE
Salem, OR 97310

Re: House Bill 2153

To Whom It May Concern:

Our property (Tax Lot: 1400, Section: 33D T. 1S, R. 4E, WM) has a pond that existed at the time the property was purchased in 1992.

According to your November, 1993 flyer entitled, "New Law Creates Special Water Rights Process for Existing Ponds," I must notify your department by January 1, 1995 if I believe our pond qualifies as exempt. In accordance with the four points listed below, I believe our pond is exempt.

1. It was constructed before January 1, 1993.
2. It stores less than 1 acre foot of water and does not have a dam.
3. It does not divert water from an on-channel source.
4. It is located off-channel.

The pond holds 27,600 cubic feet of water. The pond is filled by rain and underground springs. A property map is attached.

Please notify me immediately should you need anything further.

Sincerely,



Dione M. Fugere
33685 SE Compton Road
Boring, OR 97009
hm (503) 663-0563
wk (503) 248-6464

attachment

RECEIVED

DEC 16 1994

WATER RESOURCES DEPT.
SALEM, OREGON

Tax Lot 1400
T15 R 4E

Section 33D

Source: Rain & springs

Amount of H_2O : 27,600 cubic feet



Compton Road

Application No.

P 78349

Permit No.

March 9, 1995

Oregon

DIONE M FUGERE

33685 SE COMPTON RD
BORING, OR 97009

WATER
RESOURCES
DEPARTMENT

REFERENCE: File # P-78349;
Notice of Exempt Reservoir (Pond)

Your exempt reservoir notice has been received by the Department and has been assigned the above-referenced file number. We would like to ask you to refer to this number if you should need to contact us about the notice, your pond, or ponds if you have more than one.

To avoid any misunderstanding, we feel it is important to tell you that although we have received and filed your notice, we have not yet determined whether you are exempt from water right requirements. The watermaster responsible for the area in which the pond(s) is (are) located will help us apply the Water Resources Commission's administrative rules to your situation. These rules set the standards that determine which ponds require water rights and which are exempt. We will let you know the results as soon as we are able to complete our review of your pond(s)'s nature.

Since the department must rely initially on the information you submit to us, it is very important that the information be complete and accurate. If inspections show that your pond(s) does (do) not qualify as exempt, you could be asked to drain the pond(s) or submit a water right application or both. If you submit your application after January 1, 1995, it will be processed like any other application, since that is the deadline for filing water rights under the pond amnesty program.

The department will process your information as quickly as possible. However, because water right processing staff members are working hard to reduce a backlog of applications, it may be some weeks before you hear from us.

If you have questions, you may contact your watermaster. The enclosed brochure lists watermaster names, telephone numbers and addresses by county.

Sincerely,



Mr. Cory C. Engel
Water Rights Research Assistant
Water Rights/Adjudication Division

Enclosure: New Water Right Law for Pond Owners Brochure



Commerce Building
158 12th Street NE
Salem, OR 97310-0210
(503) 378-3739
FAX (503) 378-8130

PRE-TR APPLICATION PROCESSING OUTLINE

Application File #

P 78349

MINIMUM REQUIREMENTS TO FILE

OAR 690-11-020

DATE STAMP

DATE

INITIAL

Name and mailing address of applicant

Source of water

Quantity of water

Map showing location of POD & POU

Use of water

Names and addresses of legal owners

Signature of applicant

Oath

Application date stamped per money receipt date

Land use approved _____ pending _____

If reservoir < 5 AF \$_____, if > 5 AF \$_____

HB 2153/HB 2107 APPLICATION -- SEE REVERSE

Route to Data Center (Unless 2153/2107)

DATA CENTER

Stream Code _____

Entered into WRIS

SUPPORT SERVICES

Stamp contents with application number

Mail ack letter (provided by Data Center) with receipt to applicant, cc to CWRE and file

Place label on file and calender card

APPLICATION SECTION

Stream Indexed Basin # _____

Plat Carded and copy made YES NO

If dam is over 10 feet or storage exceeds 9.2

AC-FT, route file to Dam Safety Section

TR CASEWORKER

TR Checklist complete

YES NO

Within Irrigation District _____

District Notified _____

District excerpt received _____

TR Mailed DATE _____

Public Interest Checklist complete _____

Management Codes _____

REMARKS:

MINIMUM APPLICATION REQUIREMENTS TO FILE:

HB 2153 - existing, small, EXEMPT ponds

12-16-94
2-16-95 JES
(date & initials)

NOTICE OF EXEMPT RESERVOIR form (or letter if prior to April 8, 1994).

Appropriate map (see item 1 on form).

Evidence that reservoir existed before January 1, 1993 (one or more of the following: dated aerial photo, NOTARIZED affidavit, dated map from agency, construction receipts or other documentation).

JES Items 2, 3, 4, 5, and 6 are completed.

JES Signature (and title, if applicable)

HB 2153 - non-exempt existing ponds (large, on-channel)

Complete Minimum Requirements to File on reverse, except before routing to Data Center, change priority date to 1/1/1993. Also, confirm the following:

Receipt of evidence that reservoir existed before January 1, 1993 (one or more of the following: dated aerial photo, NOTARIZED affidavit, dated map from agency, construction receipts or other documentation)

HB 2107 - wetland, stream restoration and storm water management

Complete Minimum Requirements to File on reverse EXCEPT DO NOT ROUTE TO DATA CENTER, BUT DO ROUTE TO CAROL. Also confirm the following:

Name/address of adjacent property owner within 1/4 mile
Map with scale not less than 2 in.=1 mi.
CWRE map if > 10 feet dam or > 9.2 AF
Description of proposed use
Condition addressed
Resulting benefits
Public notices (circle) #1 #2