


2N2W Section 11 DD

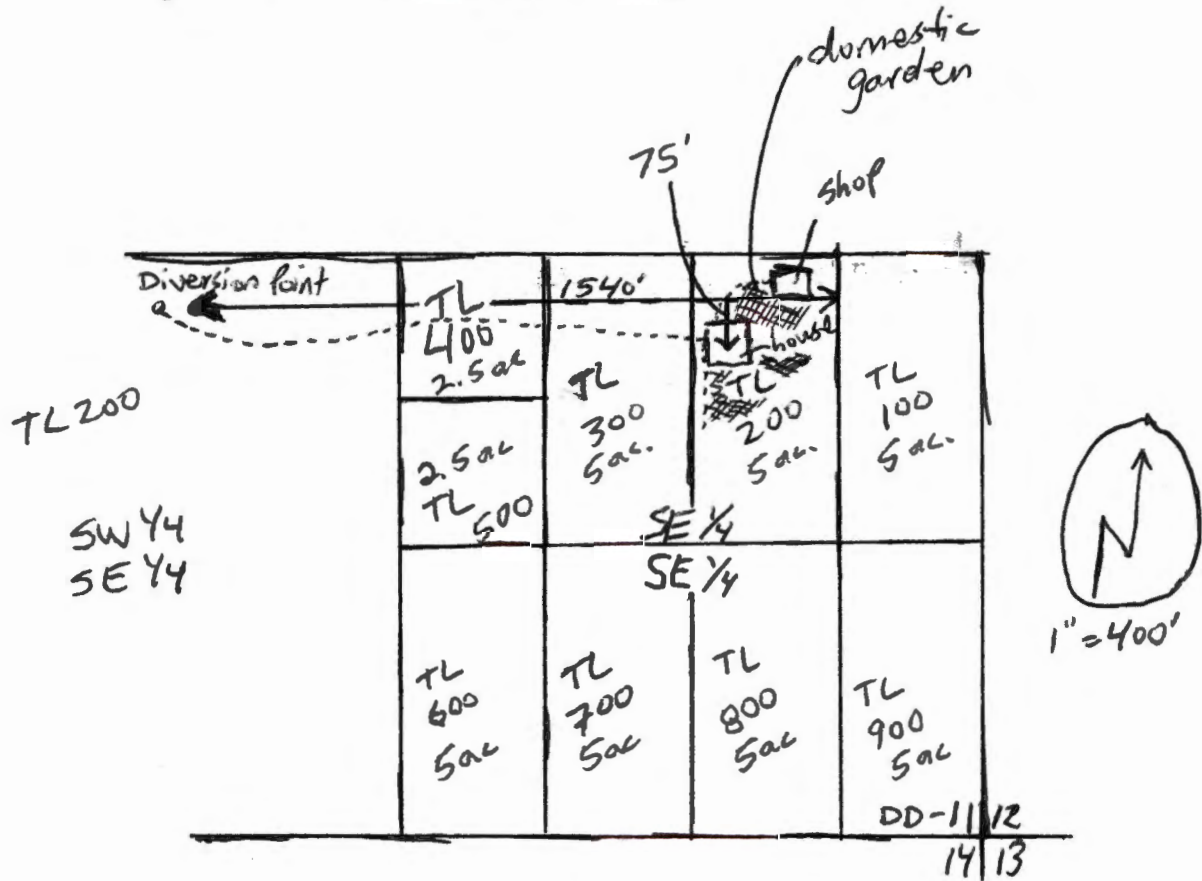

RECEIVED


AUG 24 2017

OWRD

S-88444

1. 2 N., R. 2 W., W.M.

Section 11

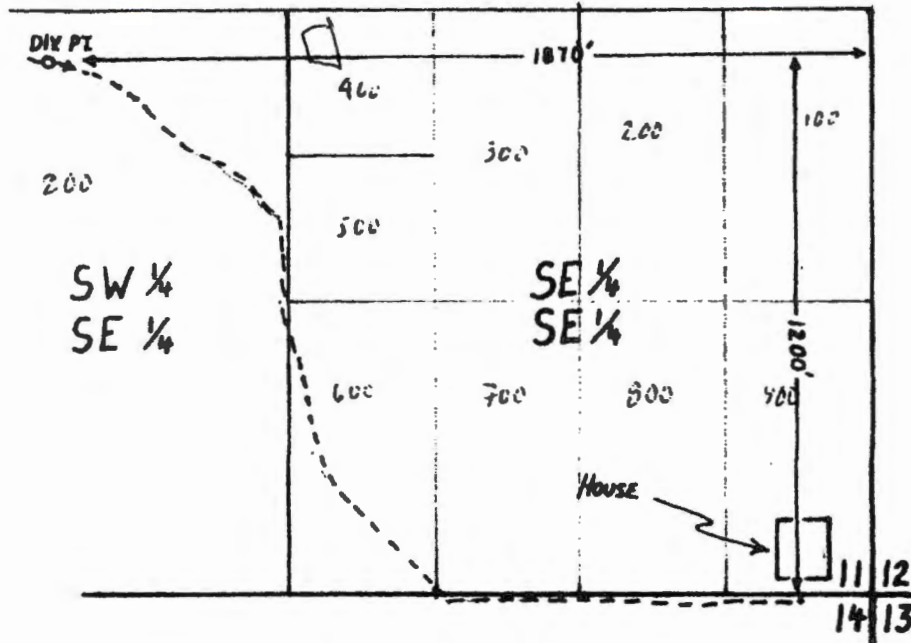

RECEIVED

FEB 09 2015

WATER RESOURCES DEPT
SALEM, OREGON

RECEIVED

OCT 02 2014

WATER RESOURCES DEPT
SALEM, OREGON

added as
reference by
applicant.

RECEIVED

AUG 24 2017

OWRD

LL-1550 S-88049

S-88444