


Water Right Application for ACMPC Oregon 2, LLC (dba Halls Ferry Farms)

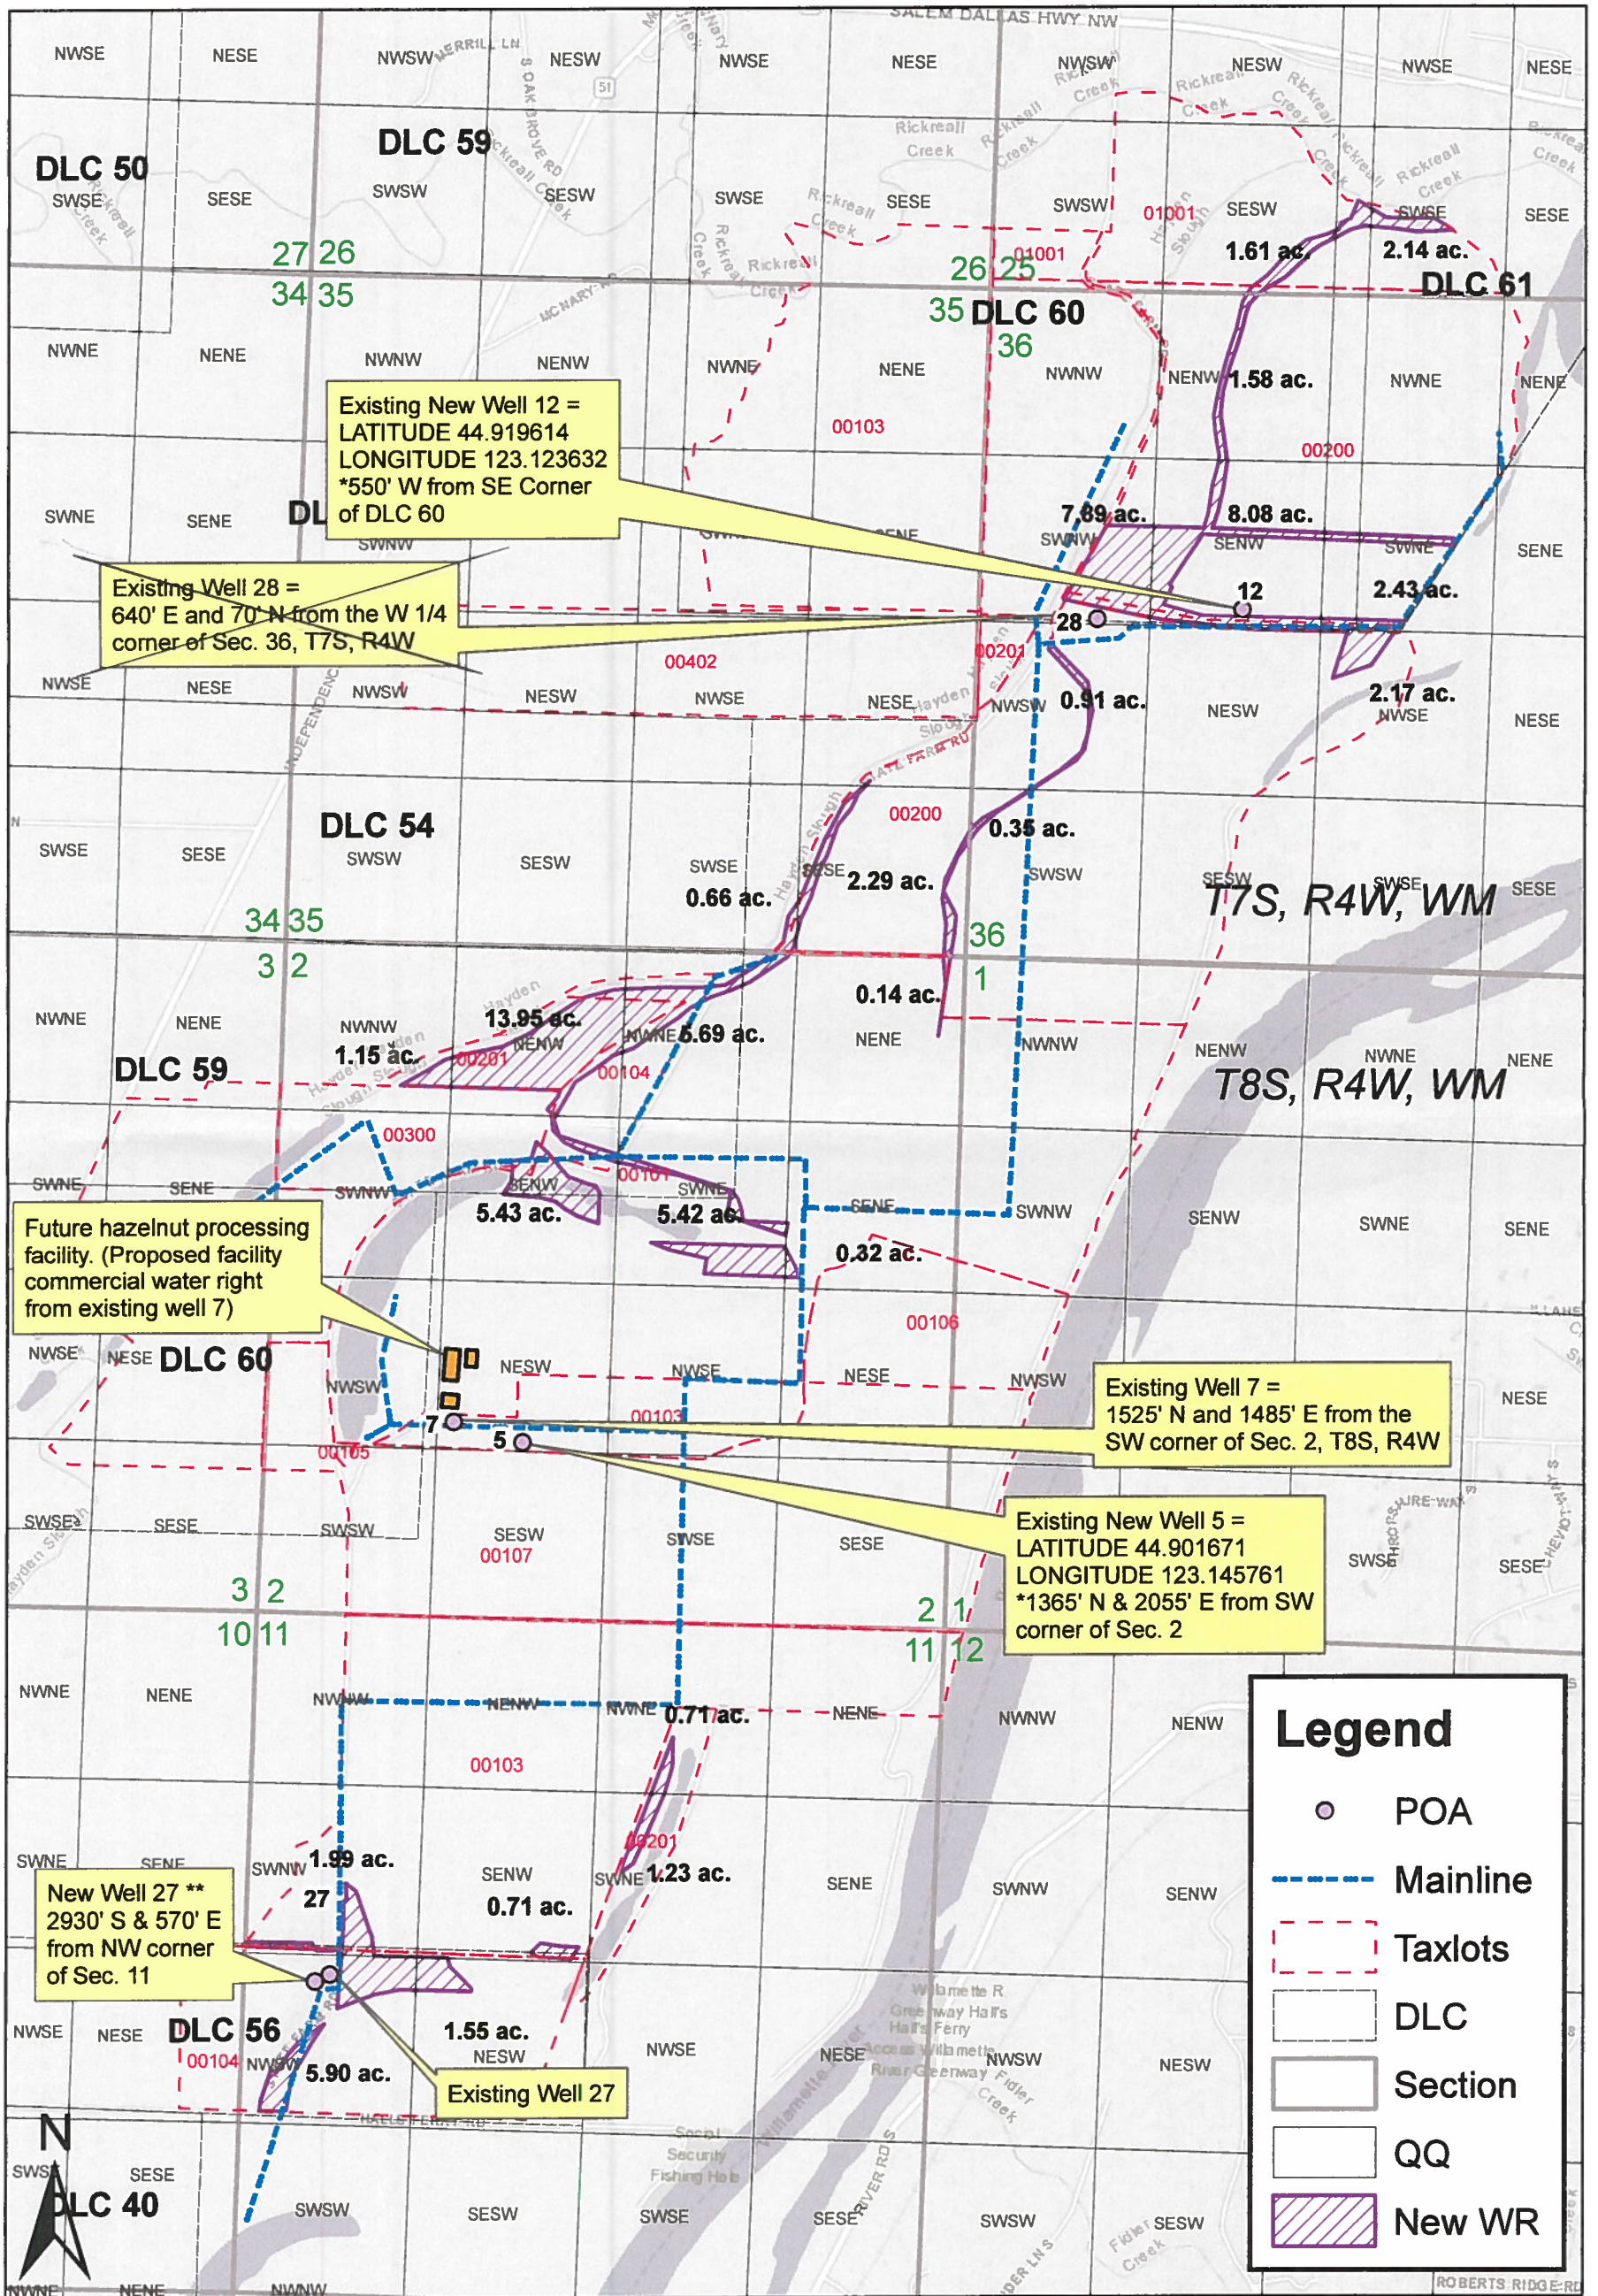

0 1,320 2,640 5,280 Feet

*Revised 12/26/2018 WEM
 **Revised 5/6/2019 WEM
 **Revised 6/4/2019 WEM

Map prepared by McGill