



THIS MAP WAS PREPARED FOR THE PURPOSE OF IDENTIFYING THE LOCATION OF THE WATER RIGHT AND IS NOT INTENDED TO PROVIDE LEGAL DIMENSIONS OR LOCATIONS OF PROPERTY OWNERSHIP LINES.

T2N, R33E, W.M.
TAX LOT 501 UMATILLA COUNTY

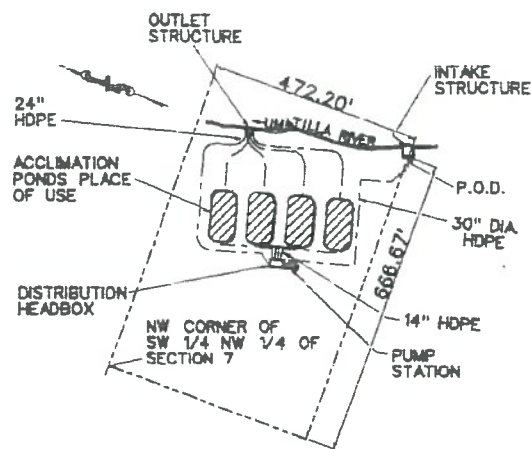

SITE PLAN
SCALE 1" = 400'

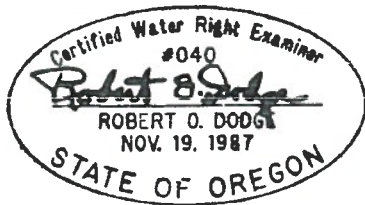

**FINAL PROOF SURVEY
UNDER**

APPLICATION NO. S-84252 PERMIT NO. 53775

IN NAME OF

OREGON DEPARTMENT OF FISH AND WILDLIFE

SURVEYED: 4/24/02 BY: DODGE

REC'D 10/24/17

5-88455


SEC 7 T2NR33E WM
UMATILLA COUNTY

SCALE 1"=400'

2N3307

AERIAL PHOTO NO 4P-101

See Map 2N 33 06

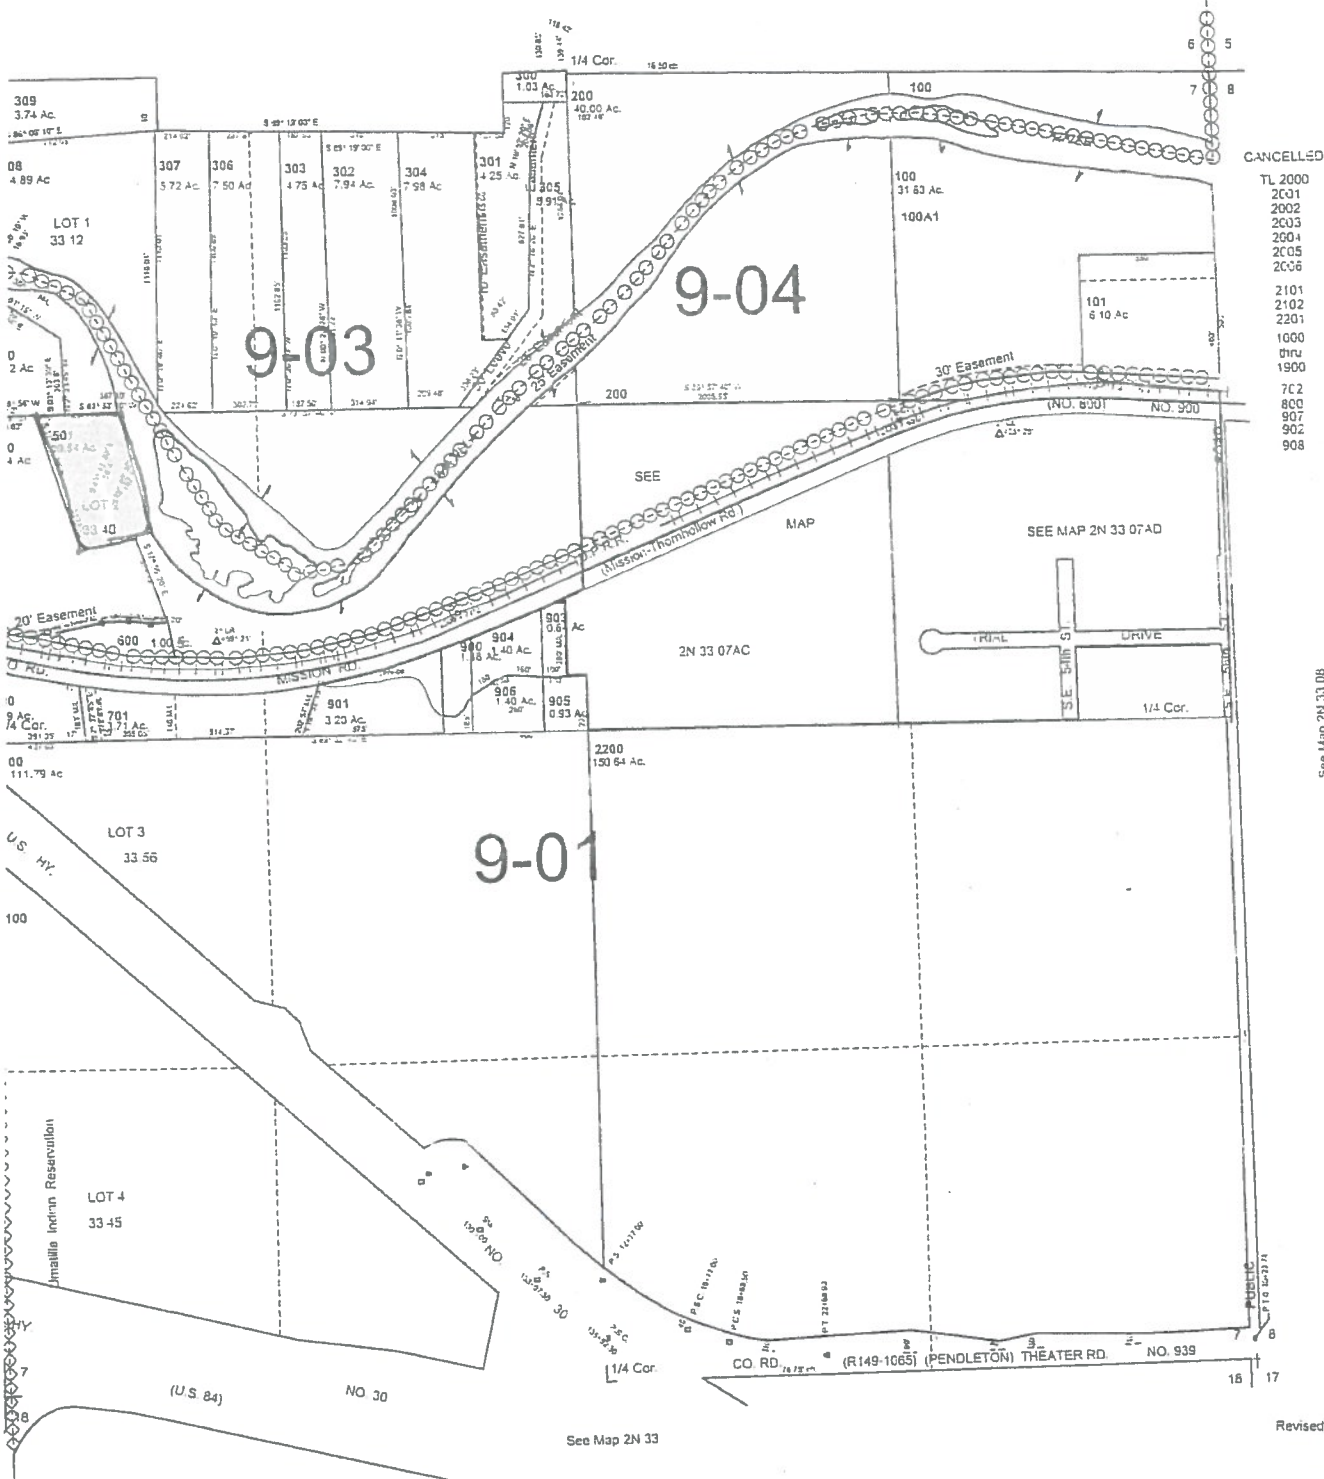

REC'D 10/24/17

S-08455

2N3307