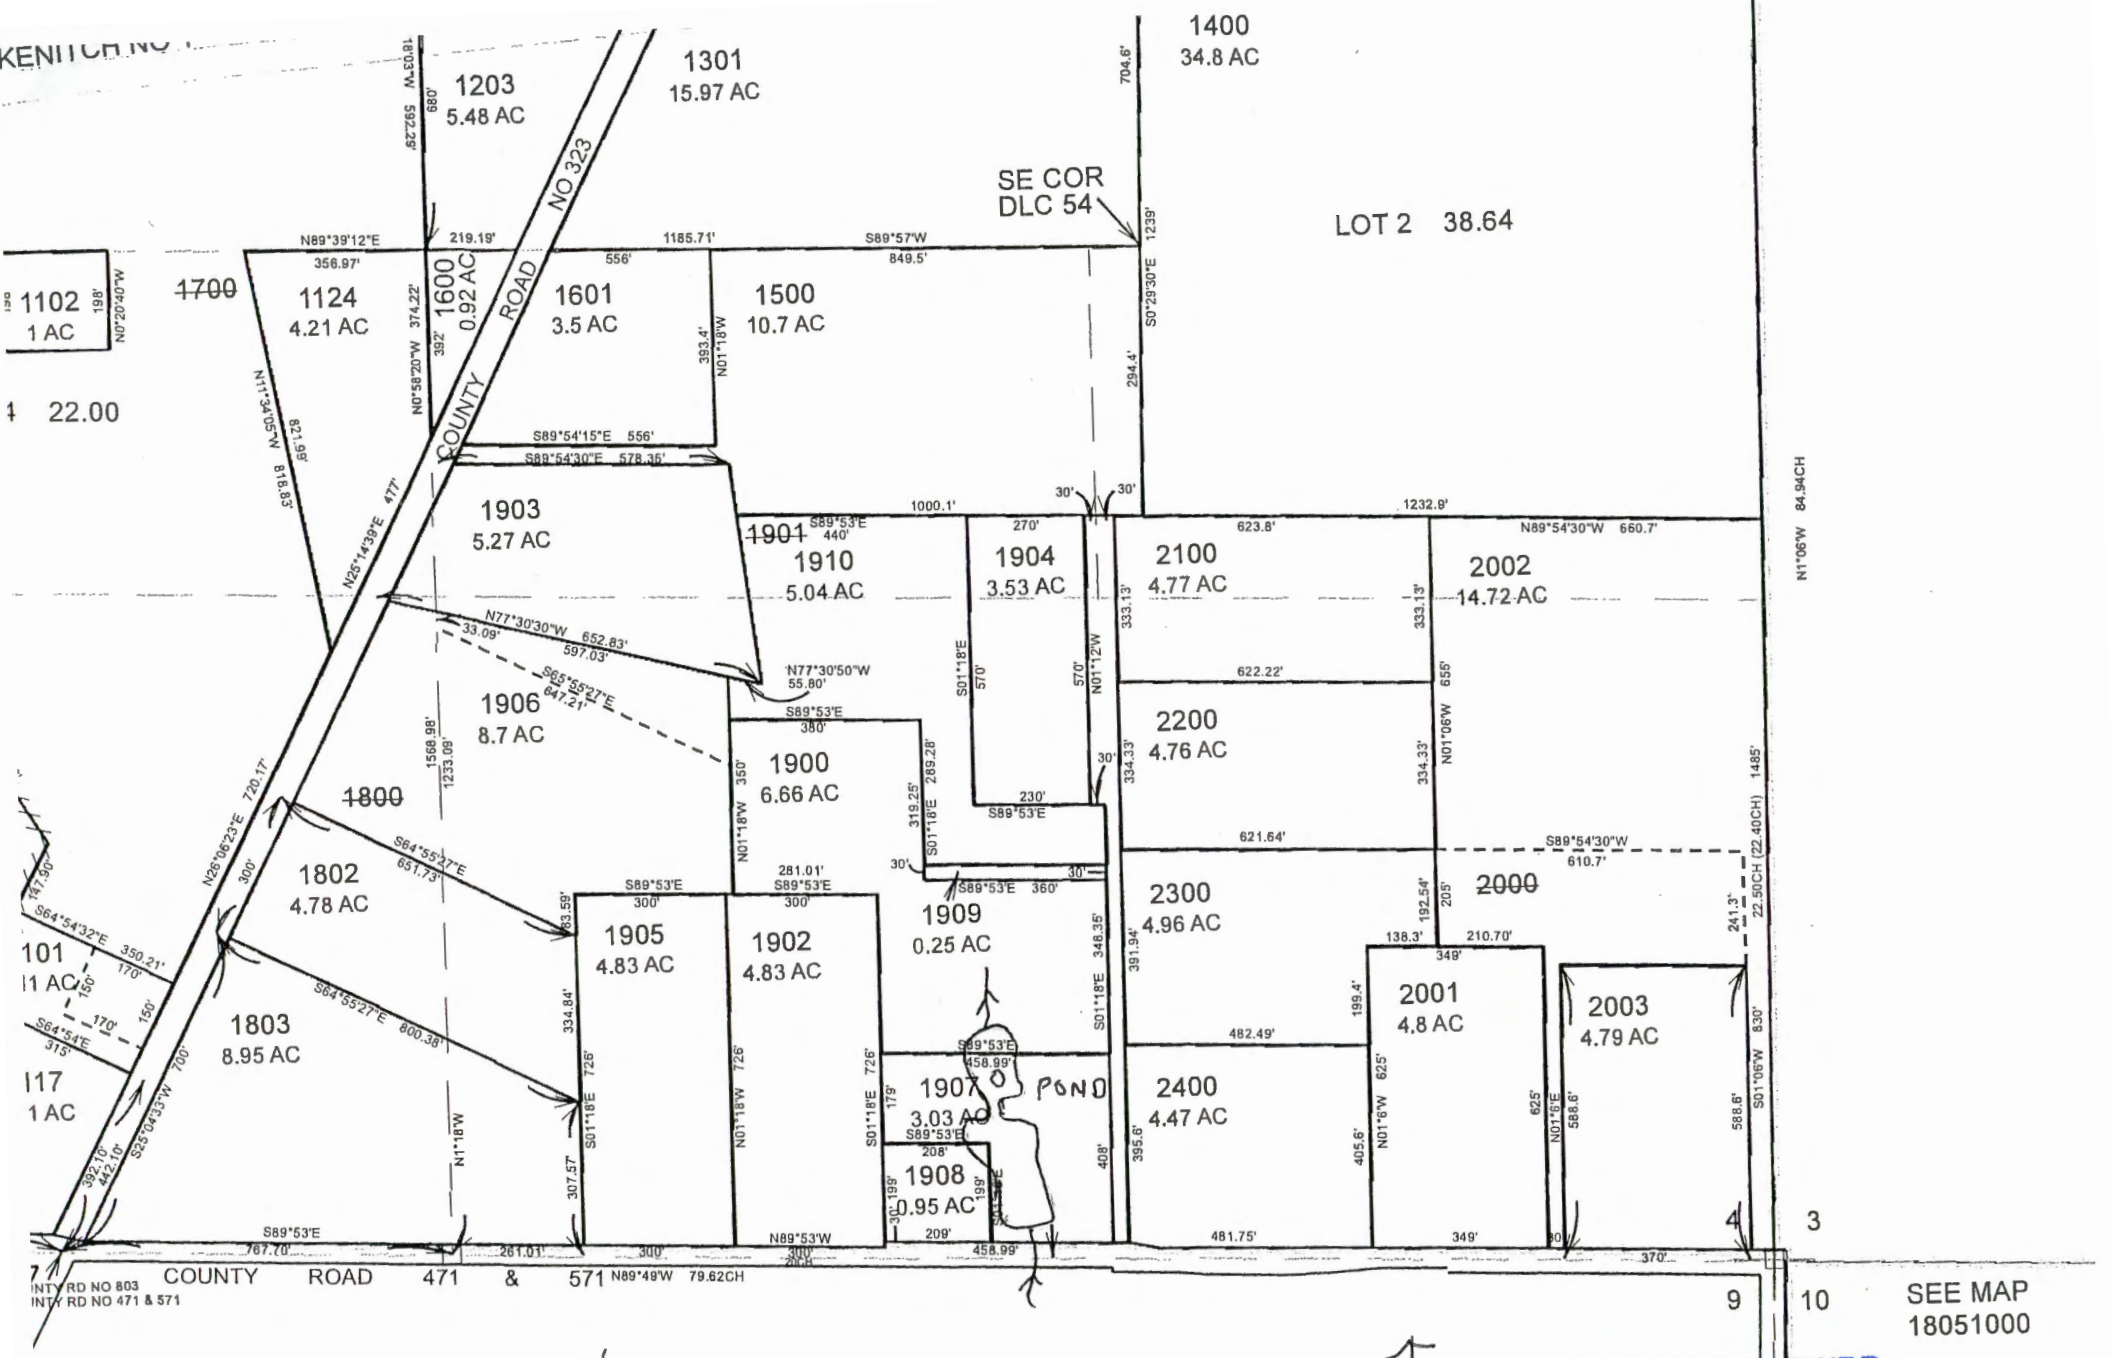


1" = 400'

T 18S R 5 Sec 4

Dam is 490' North and
1610' West from SE cor Sec 4

RECEIVED BY OWRD

SEP 15 2017

SALEM, OR

0-88460