

Place of Use:


Twp	Rng	Mer	Sec	Q-Q	Acres
14 S	6 W	WM	23	SE SW	4.00
14 S	6 W	WM	26	NE NW	0.87



POINT OF DIVERSION
WELL ID LABEL
L124691
LAT 44.33130000, LONG
-123.38490000

1740' EAST, 125' SOUTH
FROM REF CORNER

SECTION 23 T.14S. R.6W. W.M.
BENTON COUNTY
1" = 400'

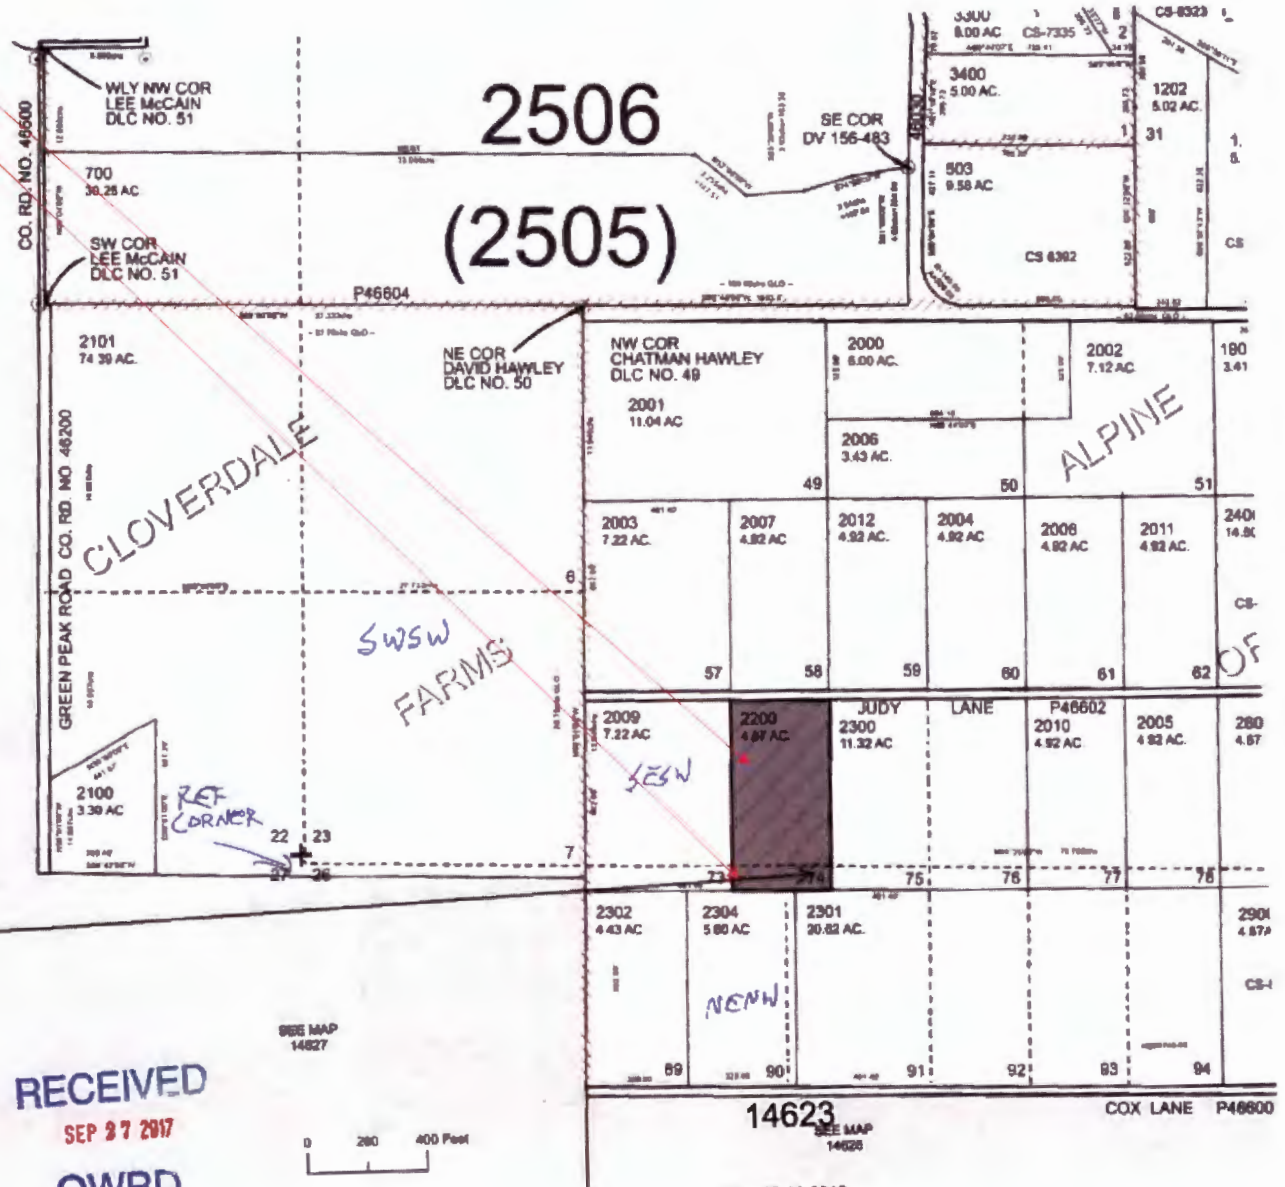

RECEIVED
SEP 27 2017
OWRD

RECEIVED
JUN 5 2018
OWRD

SUPERSEDING