


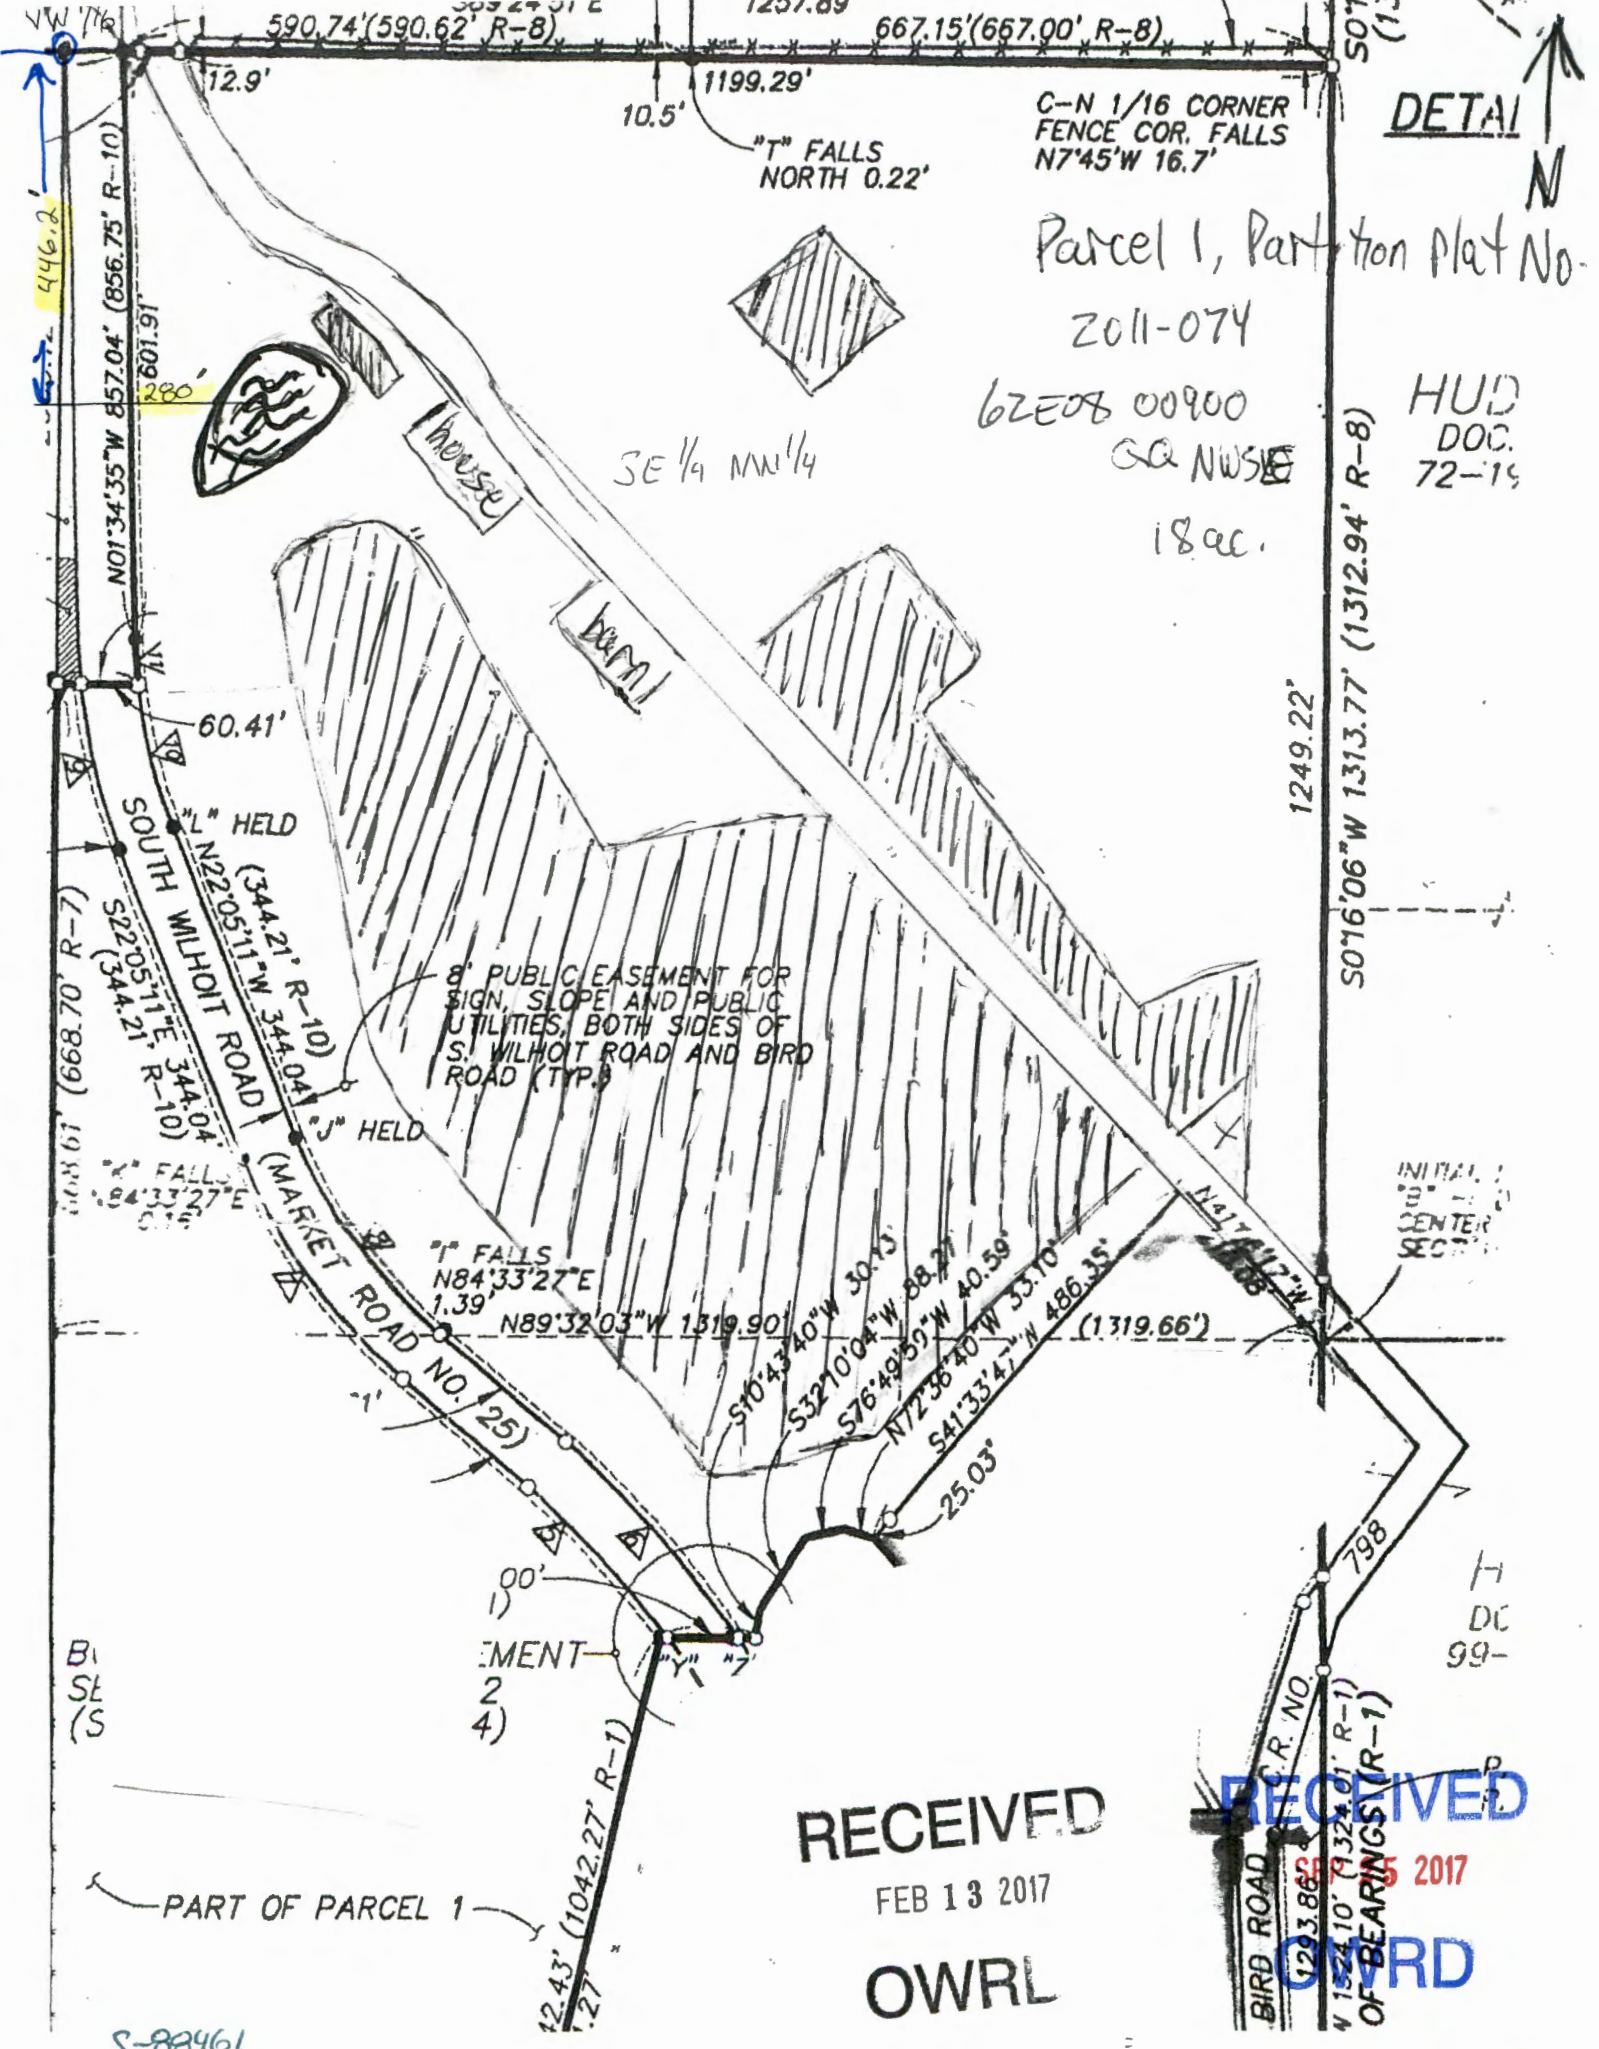

DETAIL

N

C-N 1/16 CORNER
FENCE COR. FALLS
N7°45'W 16.7'

Parcel 1, Part of Plat No.

2011-074

62E08 00900

GA NWSE

18 ac.

HUD
DOC.
72-19

1249.22'

S01°16'06\"W 1313.77' (1312.94' R-8)

INITIAL
CENTER
SECTION

RECEIVED

FEB 13 2017

OWRL

RECEIVED

2017


PART OF PARCEL 1

S-88461