


1/4 CORNER
FD. BRASS CAP AND BT'S
PER CS OFFICE 1979

SECTION CORNER
FD. BRASS CAP AND BT'S
PER L.S. 959 1973

28411
7-22-89 C

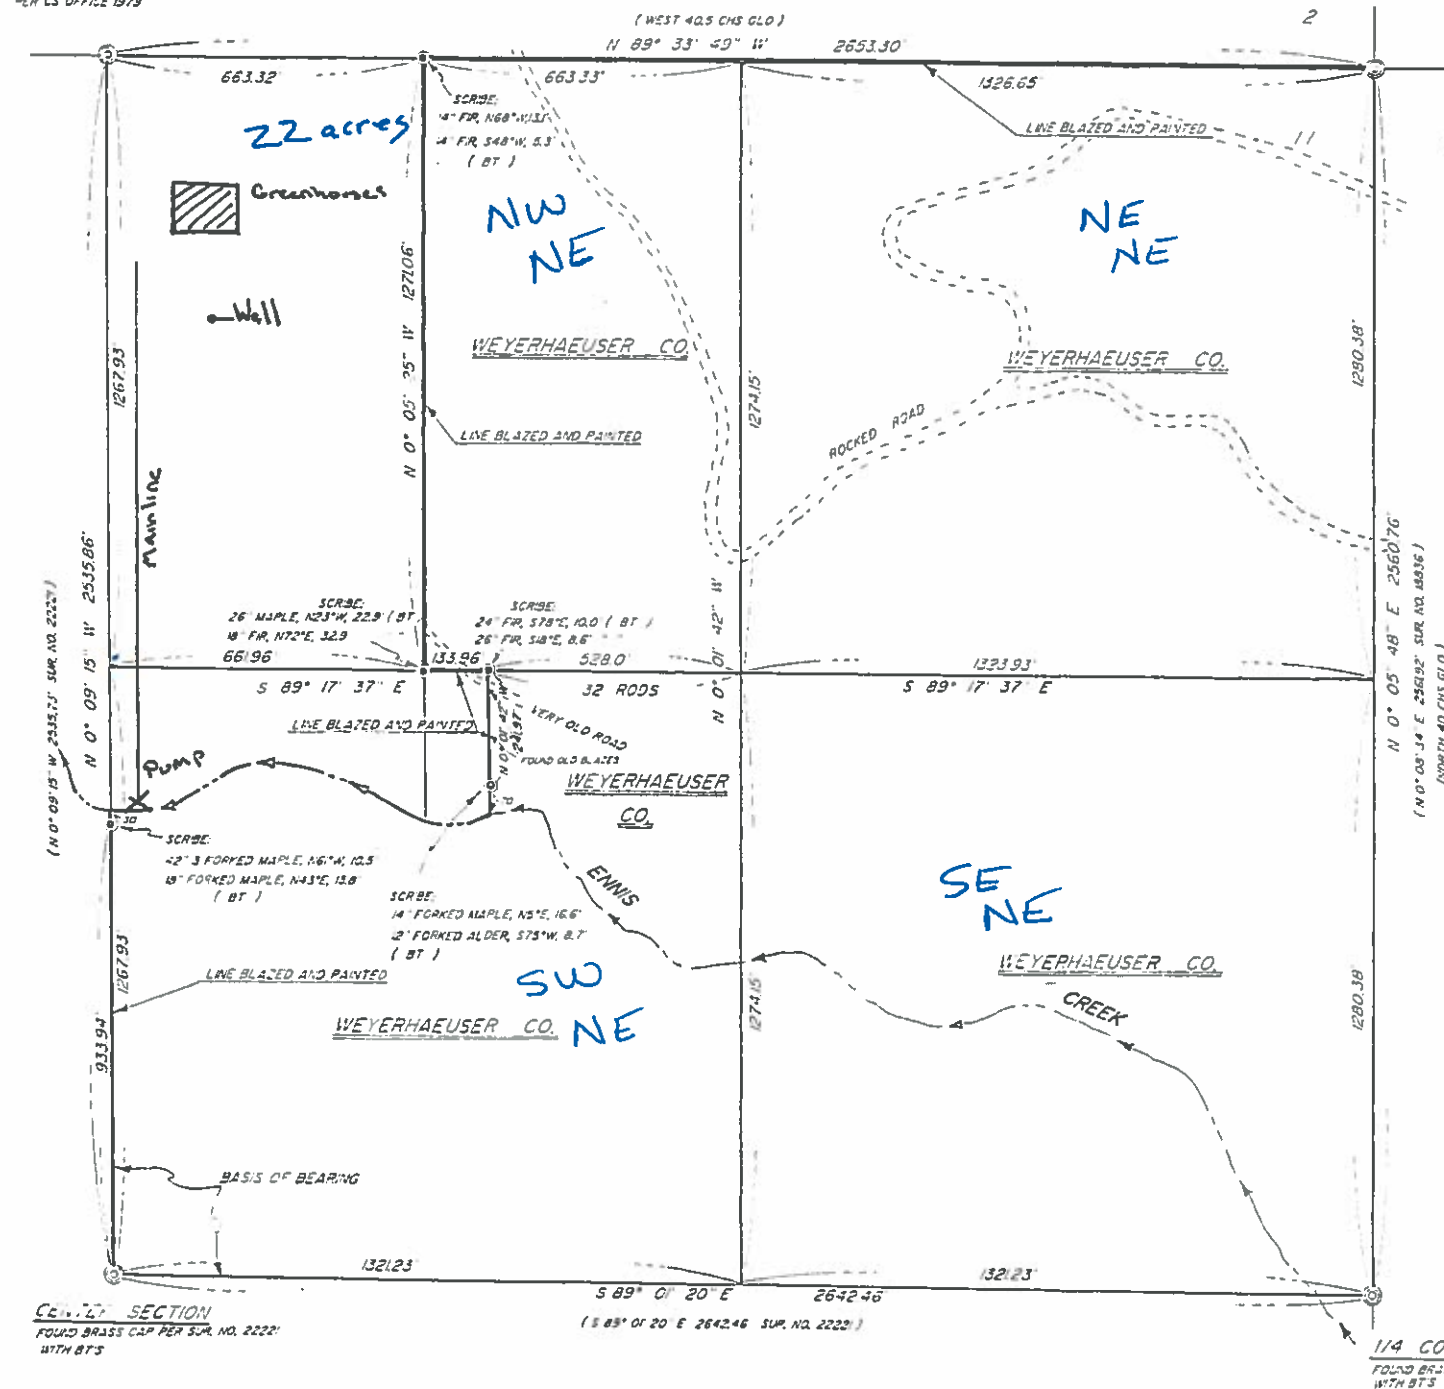

SURVEY OF THE NE 1/4 OF SEC. 11,
T. 17 S., R. 3 E., W.M., LANE CO.,
OREGON

DATE: 6/24/88 SCALE: 1" = 400'
FOR: WEYERHAEUSER CO.

SURVEY BY:
GERALD D. RILEY
38415 MCKENZIE HWY.
SPRINGFIELD, OREGON
97478

LEGEND
⊙ DENOTES 5/8" X 20" REBAR SET WITH CAP MARKED "RILEY 705"

NARRATIVE
THIS SURVEY DONE TO MARK AND MONUMENT THE TRUE LINES FOR LOGGING
PURPOSES. BEARINGS ARE REFERENCED TO SURVEY NO. 2222. THIS SURVEY
ERROR OF CLOSURE IS 1 IN 12,842. BEARINGS AND DISTANCES MEASURED
WITH A TOPCON TOTAL STATION.

SECTION
FOUND BRASS CAP PER SUR. NO. 2222
WITH BT'S

1/4 CORNER
FOUND BRASS CAP PER SUR. NO. 1836
WITH BT'S

REGISTERED
PROFESSIONAL
LAND SURVEYOR
G. D. RILEY
1988

330440

POD
1566'S
30' E
from
N 1/4
Sec 11

S-88463