


T37S R6W Northeast Quarter Section 18

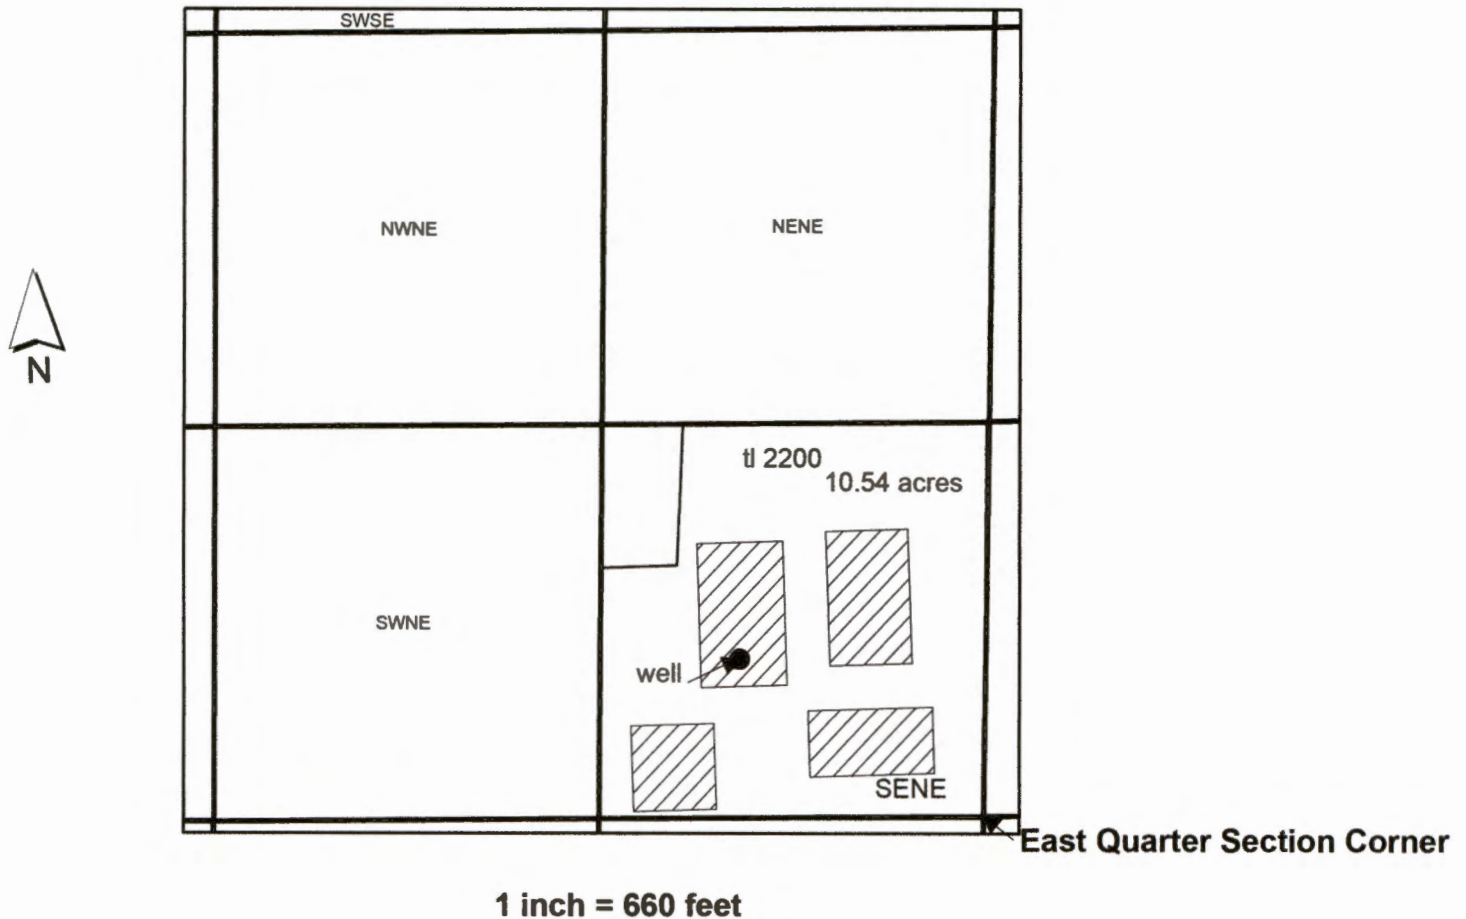

The well will be located 538 ft north and 844 ft west from the east quarter section corner.

RECEIVED BY OWRD

OCT 05 2017

SALEM, OR