

NOV 23 1988


RECEIVED

DEC 23 1988

RECEIVED

Application No. 69477
Permit No.

SEE MAP 33 5 20

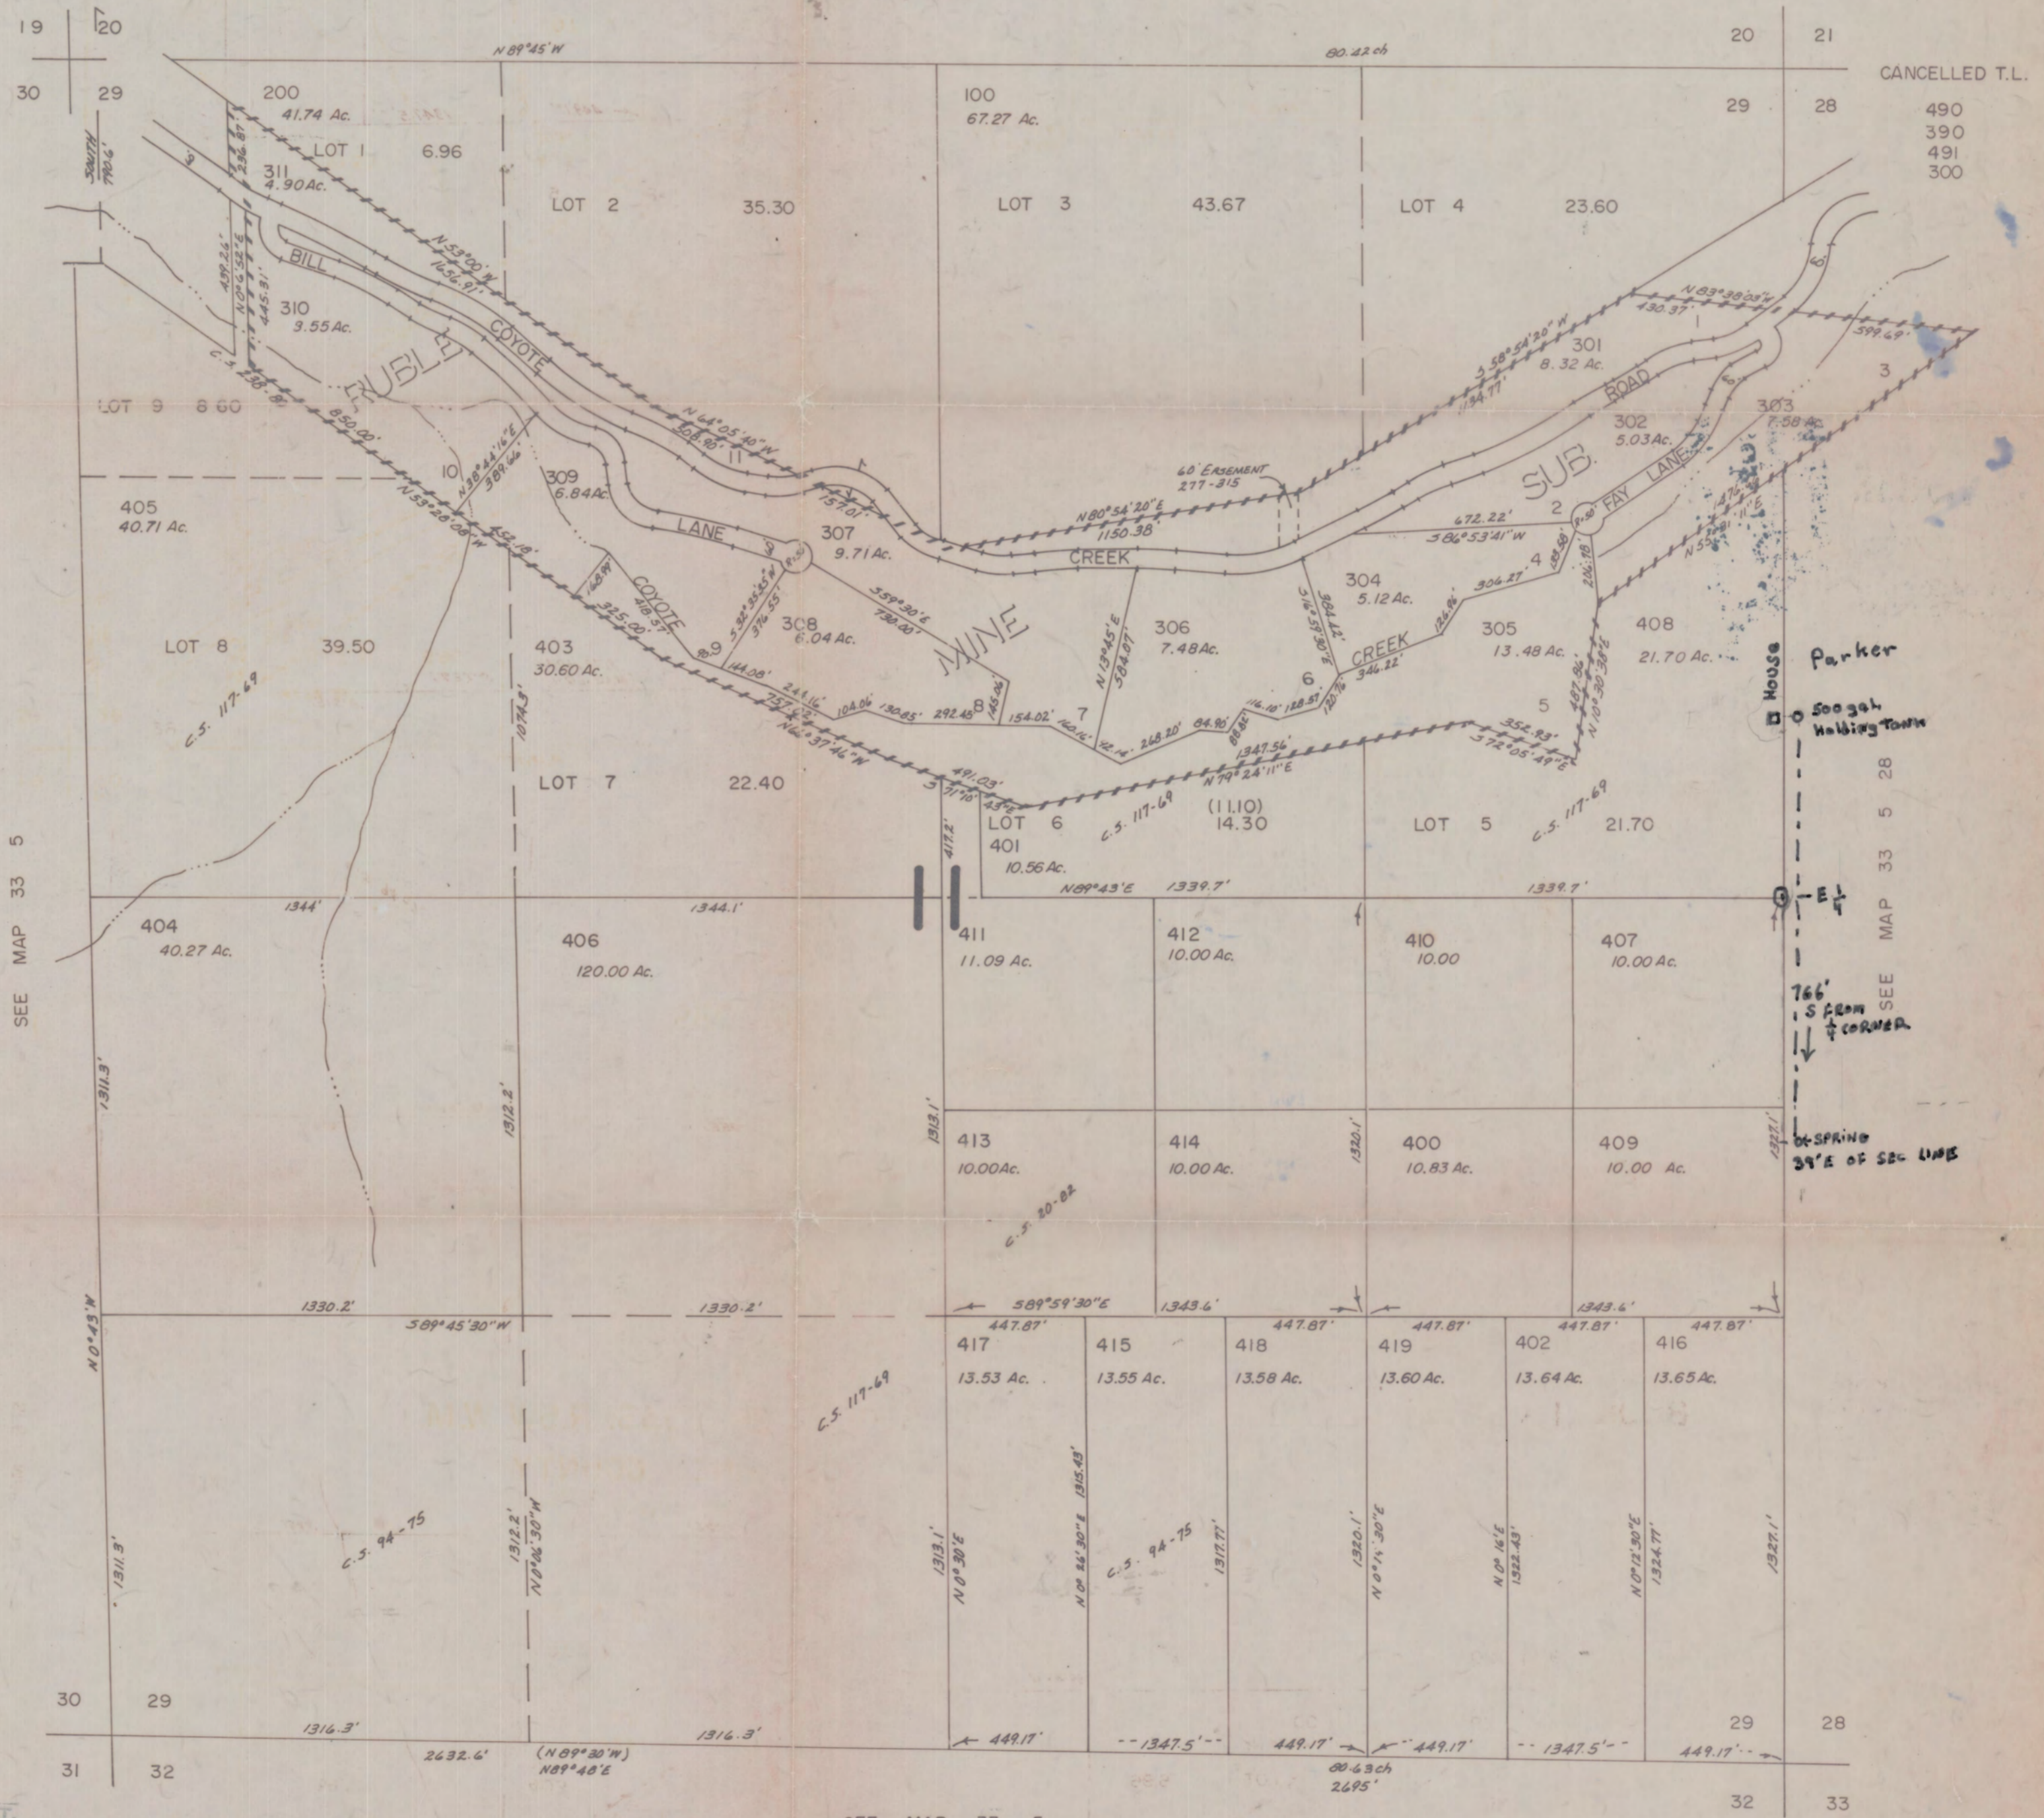

RECEIVED

FEB -9 1989

Busch 4164