

This map was prepared for assessment purpose only.

SECTION 4 T.3S. R.7E. W.M.

CLACKAMAS COUNTY


1"=400'

3 7E 4  
& INDEX

CANCELLED NOS.

TL	501	329	204	307
	203	324	201	312
	502	318	301	313
	191	315	302	314
	104	100	303	315
	105	101	304	316
	2701	102	305	317
	190	103	306	318
	202			319
				320

321  
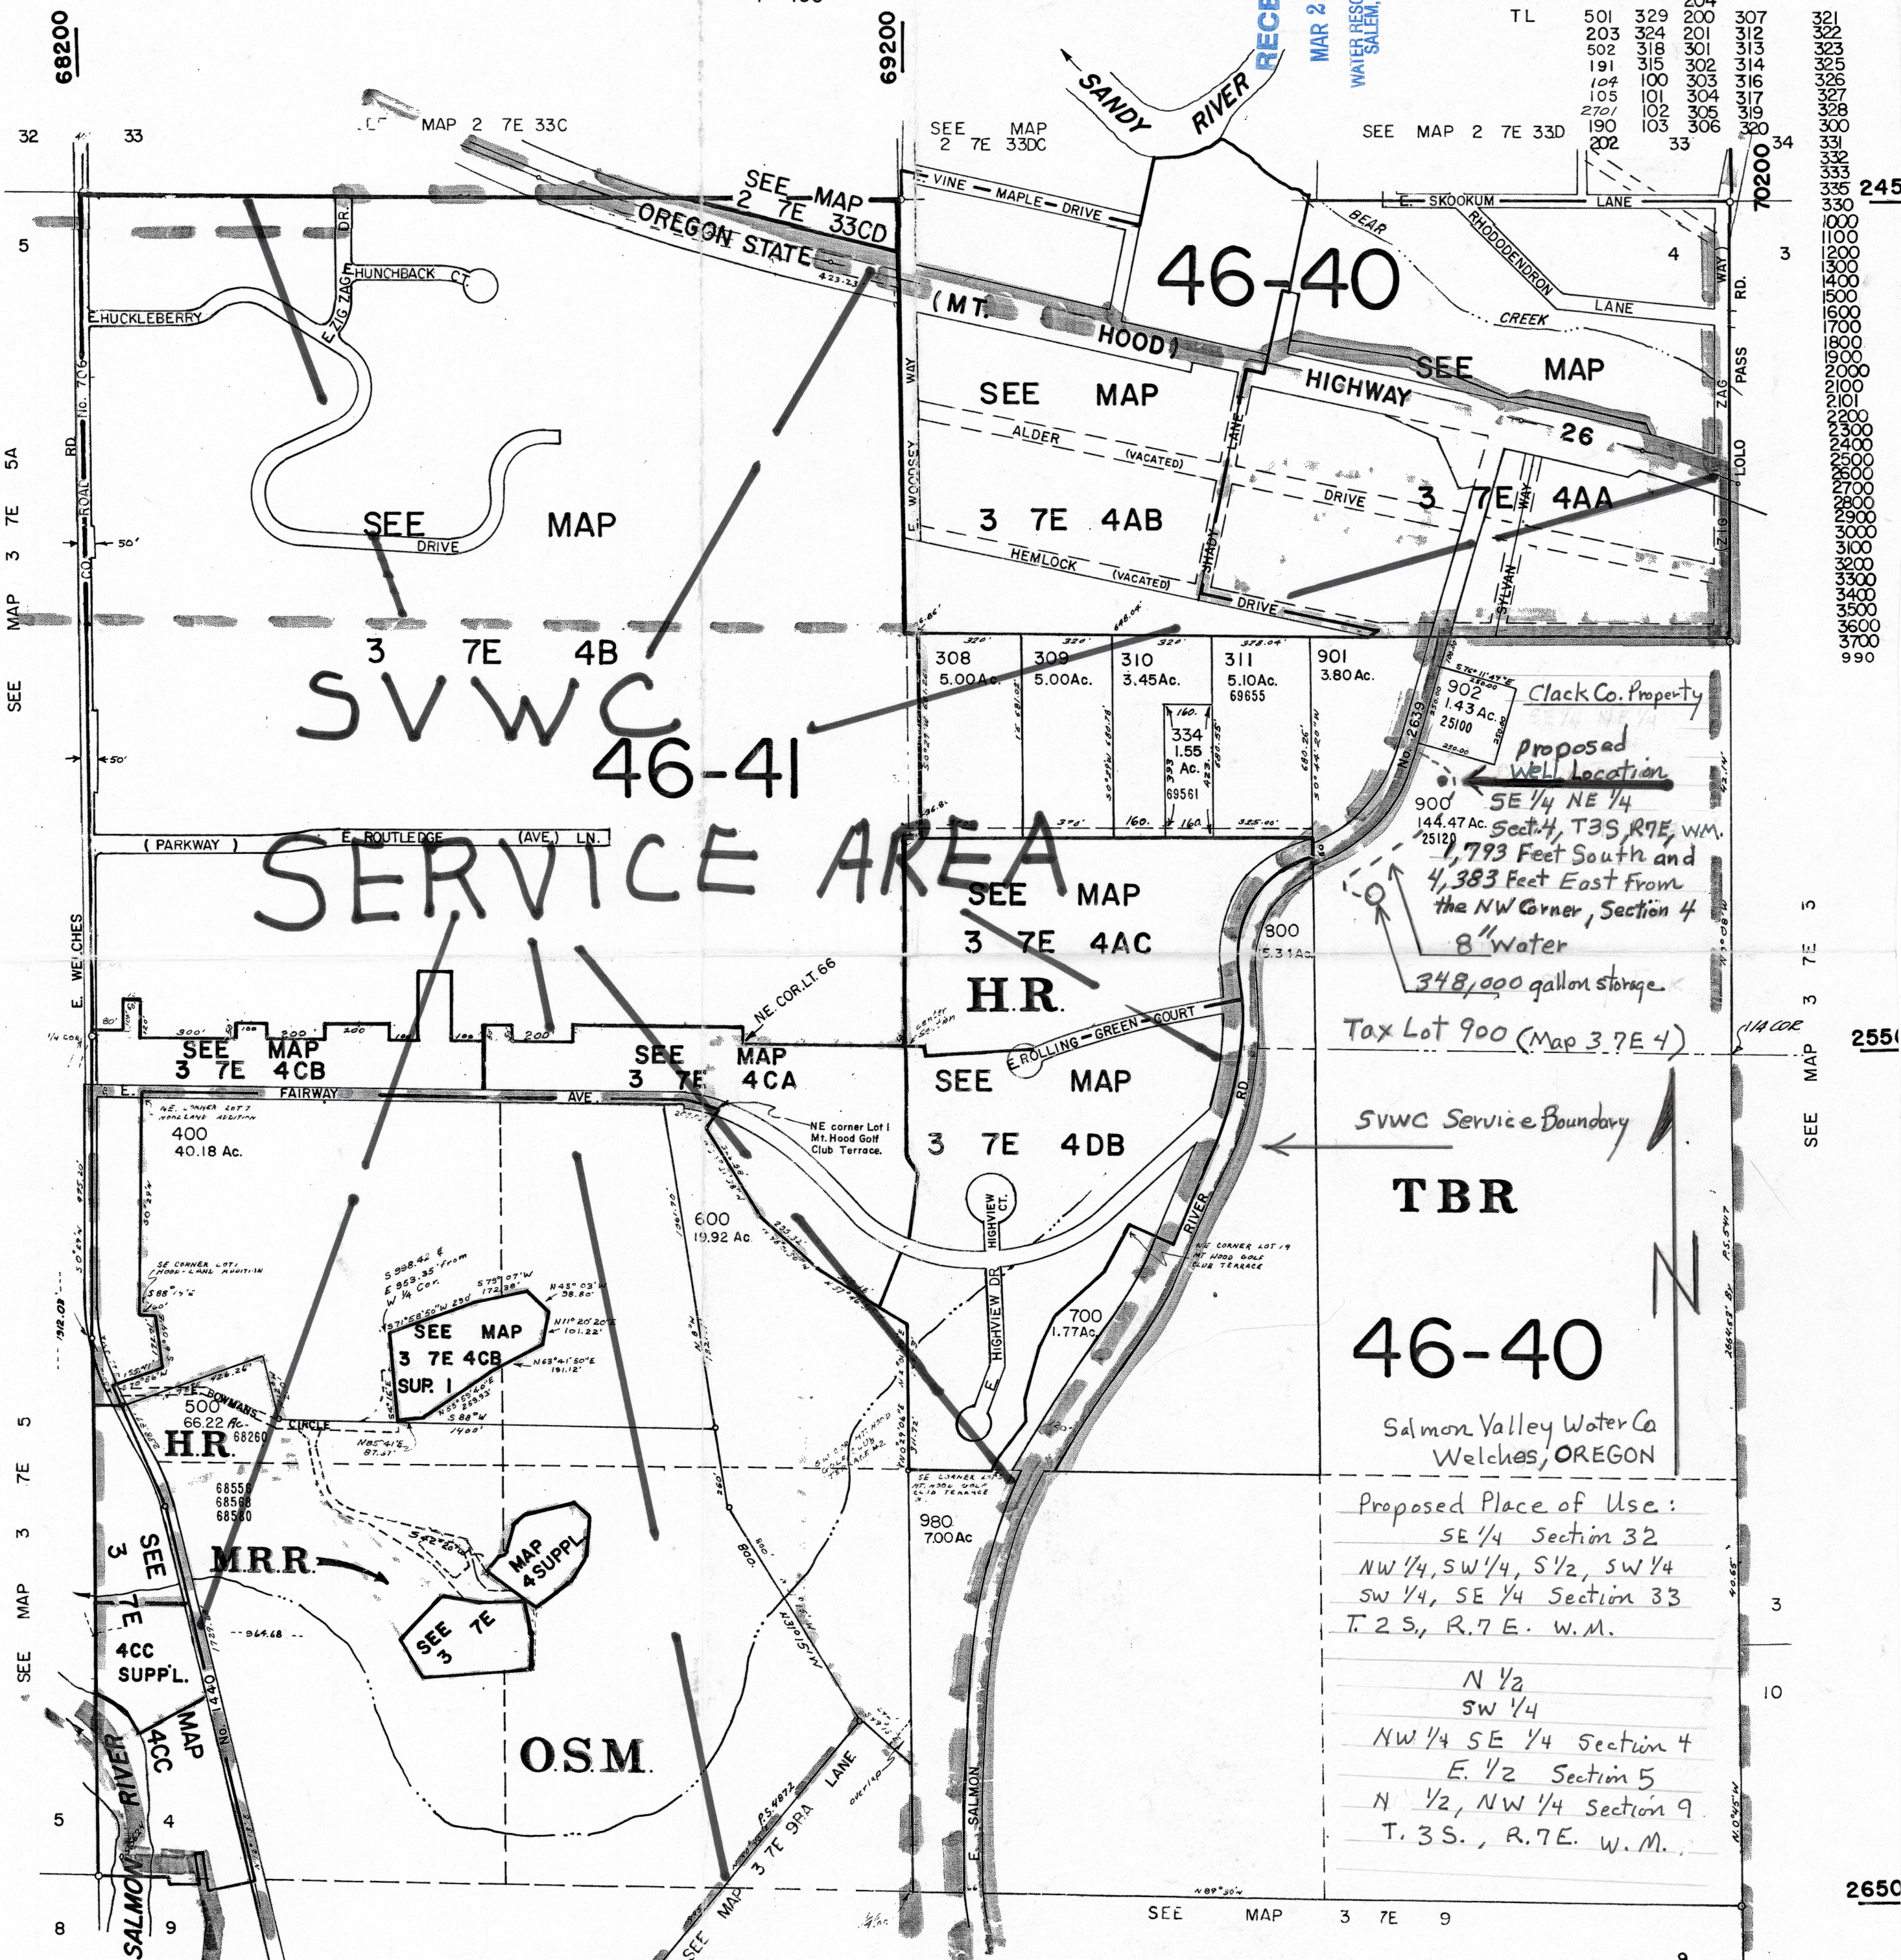

Clack Co. Property  
 Proposed Well Location  
 SE 1/4 NE 1/4  
 Sect. 4, T.3S. R.7E. W.M.  
 1,793 Feet South and  
 4,383 Feet East From  
 the NW Corner, Section 4  
 8" water  
 348,000 gallon storage  
 Tax Lot 900 (Map 3 7E 4)

SVWC Service Boundary  
**TBR**  
**46-40**  
 Salmon Valley Water Co  
 Welches, OREGON  
 Proposed Place of Use:  
 SE 1/4 Section 32  
 NW 1/4, SW 1/4, S 1/2, SW 1/4  
 SW 1/4, SE 1/4 Section 33  
 T. 2 S., R. 7 E. W.M.  
 N 1/2  
 SW 1/4  
 NW 1/4 SE 1/4 Section 4  
 E. 1/2 Section 5  
 N 1/2, NW 1/4 Section 9  
 T. 3 S., R. 7 E. W.M.

Application No. 915460  
 Permit No.

3 7E 4  
& INDEX  
 BOOK 34 AR 0 6 200