


THIS MAP WAS PREPARED FOR ASSESSMENT PURPOSE ONLY

0 25 50 100 Feet

N.E.1/4 S.W.1/4 SEC.28 T.5N. R.1W. W.M. COLUMBIA COUNTY

1" = 100'

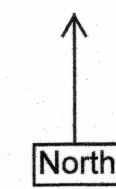


05 01 28 CA COLUMBIA CITY

Cancelled: 4001

----- = Place of Use (Tax Lot 5000 not included)

- - - - - = 4" Pipeline

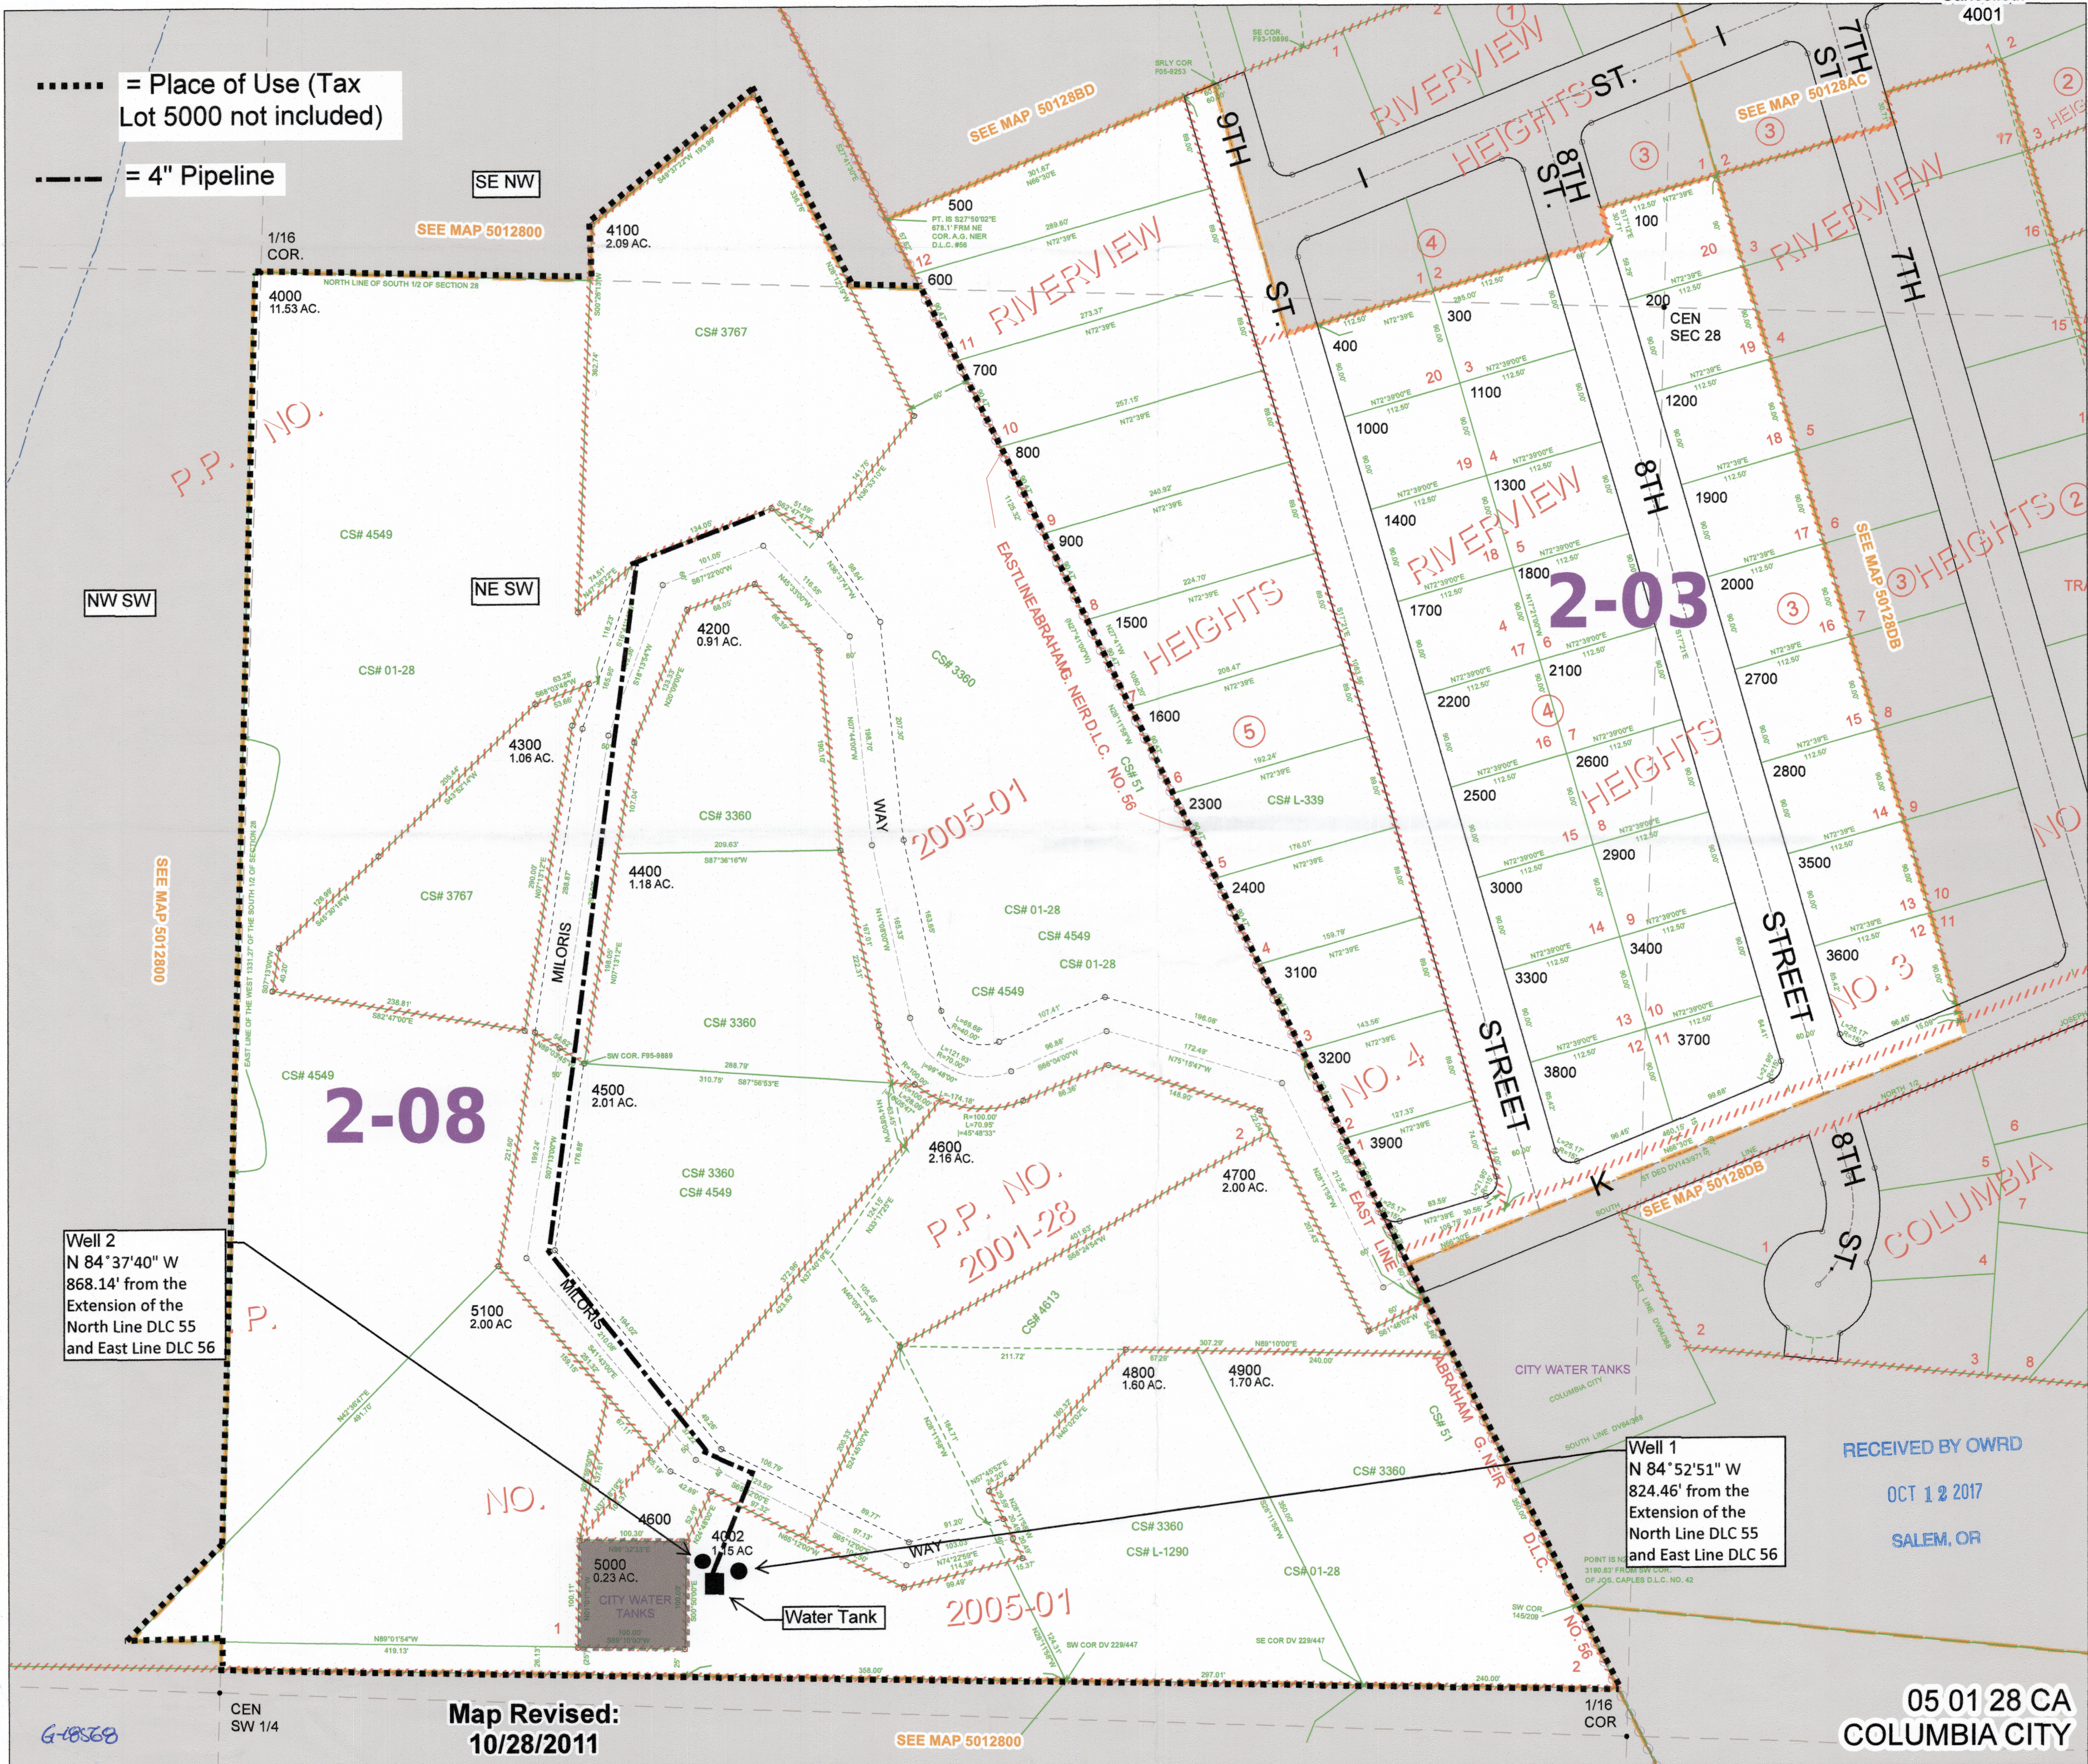

Well 2
N 84° 37' 40" W
868.14' from the
Extension of the
North Line DLC 55
and East Line DLC 56

Well 1
N 84° 52' 51" W
824.46' from the
Extension of the
North Line DLC 55
and East Line DLC 56

Map Revised:
10/28/2011

RECEIVED BY OWRD
OCT 12 2017
SALEM, OR

05 01 28 CA
COLUMBIA CITY

G-18568