


Ken Eichler

1" = 1320'

Tax Lot:



Township 12 South, Range 4 West, Section 36, Tax Lot 200 & 201

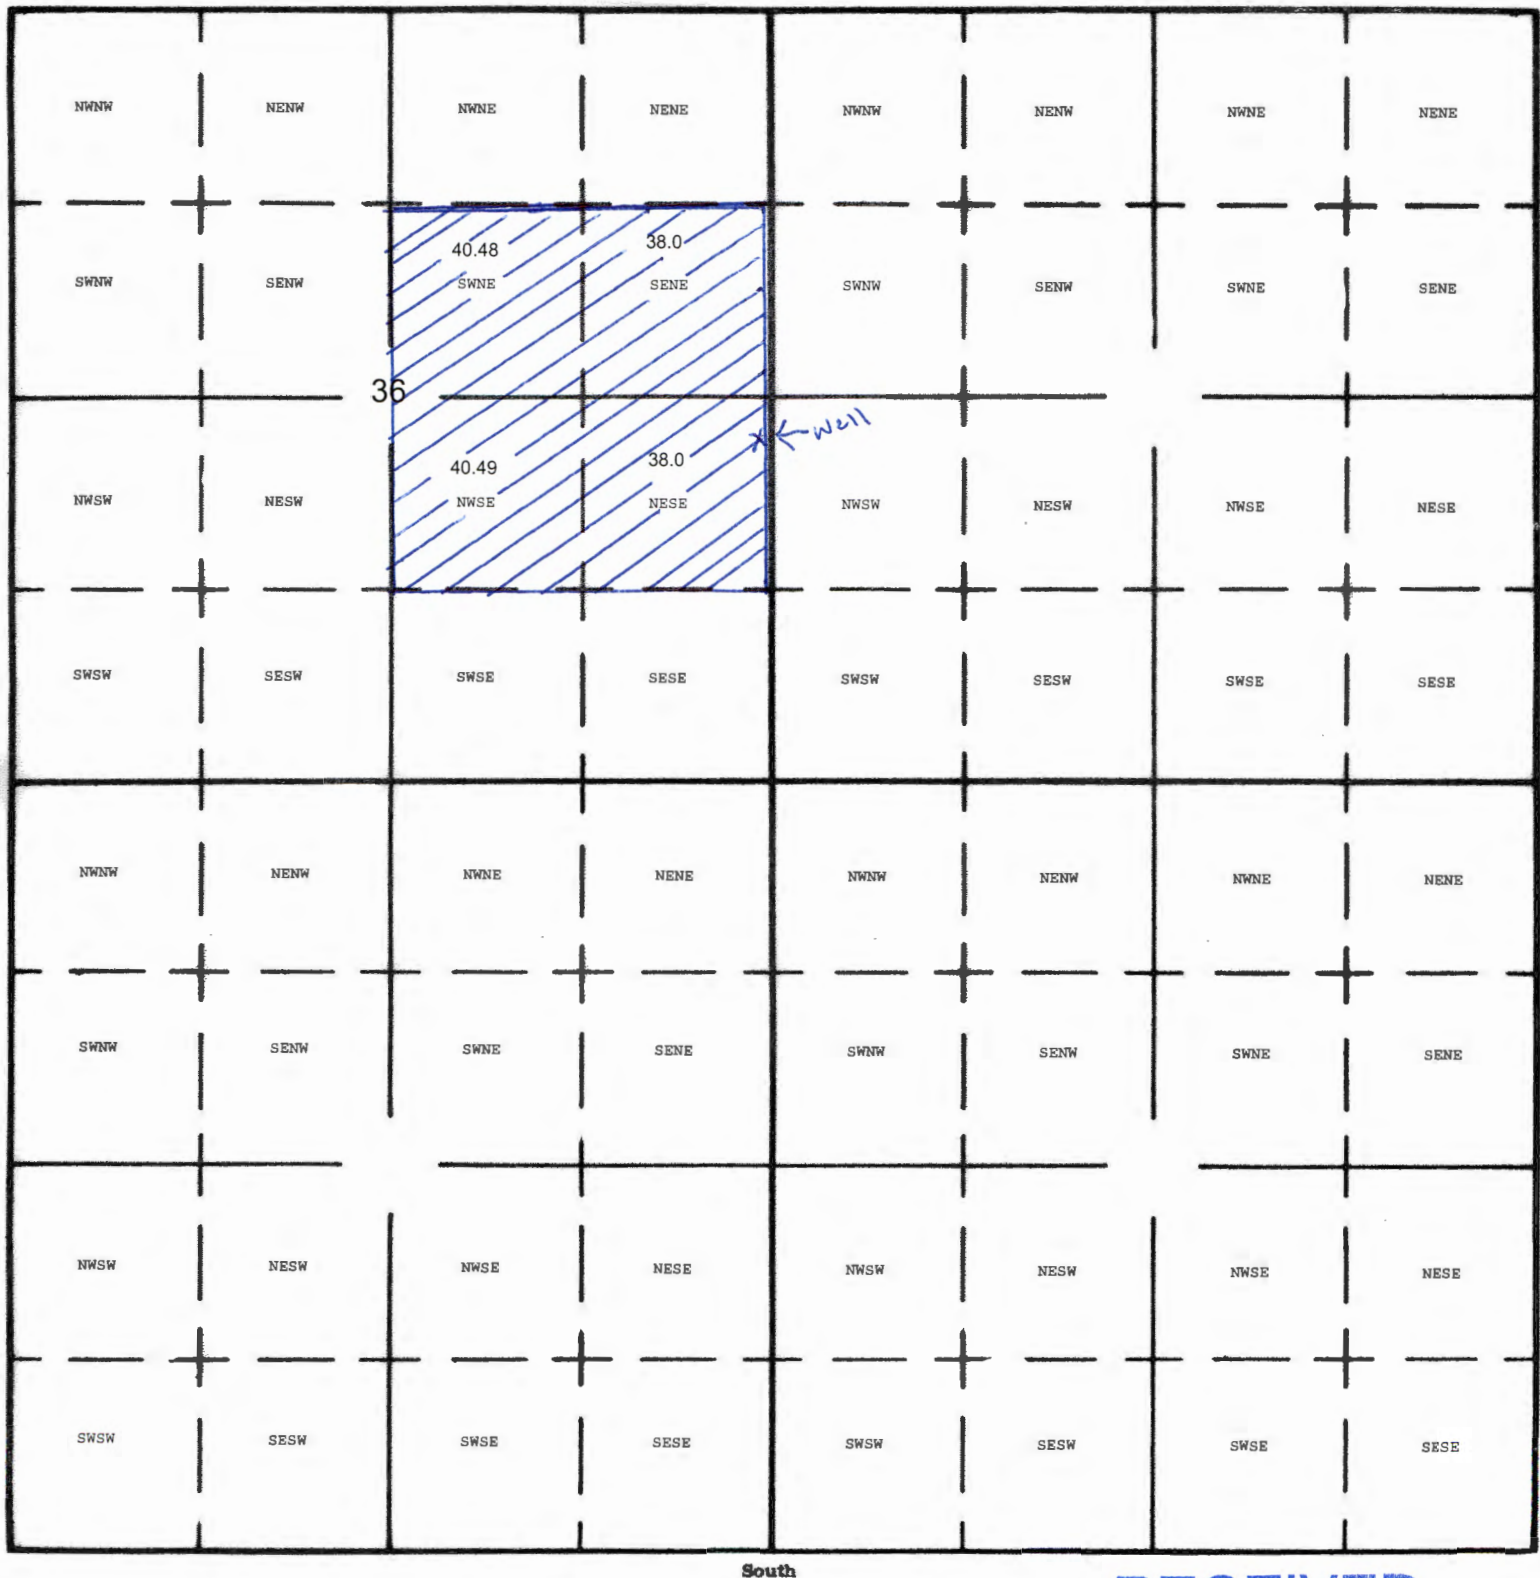


Well: 2910' South and 115' West from NE Corner Section 36

RECEIVED

OCT 19 2017

OWRD

G-18570

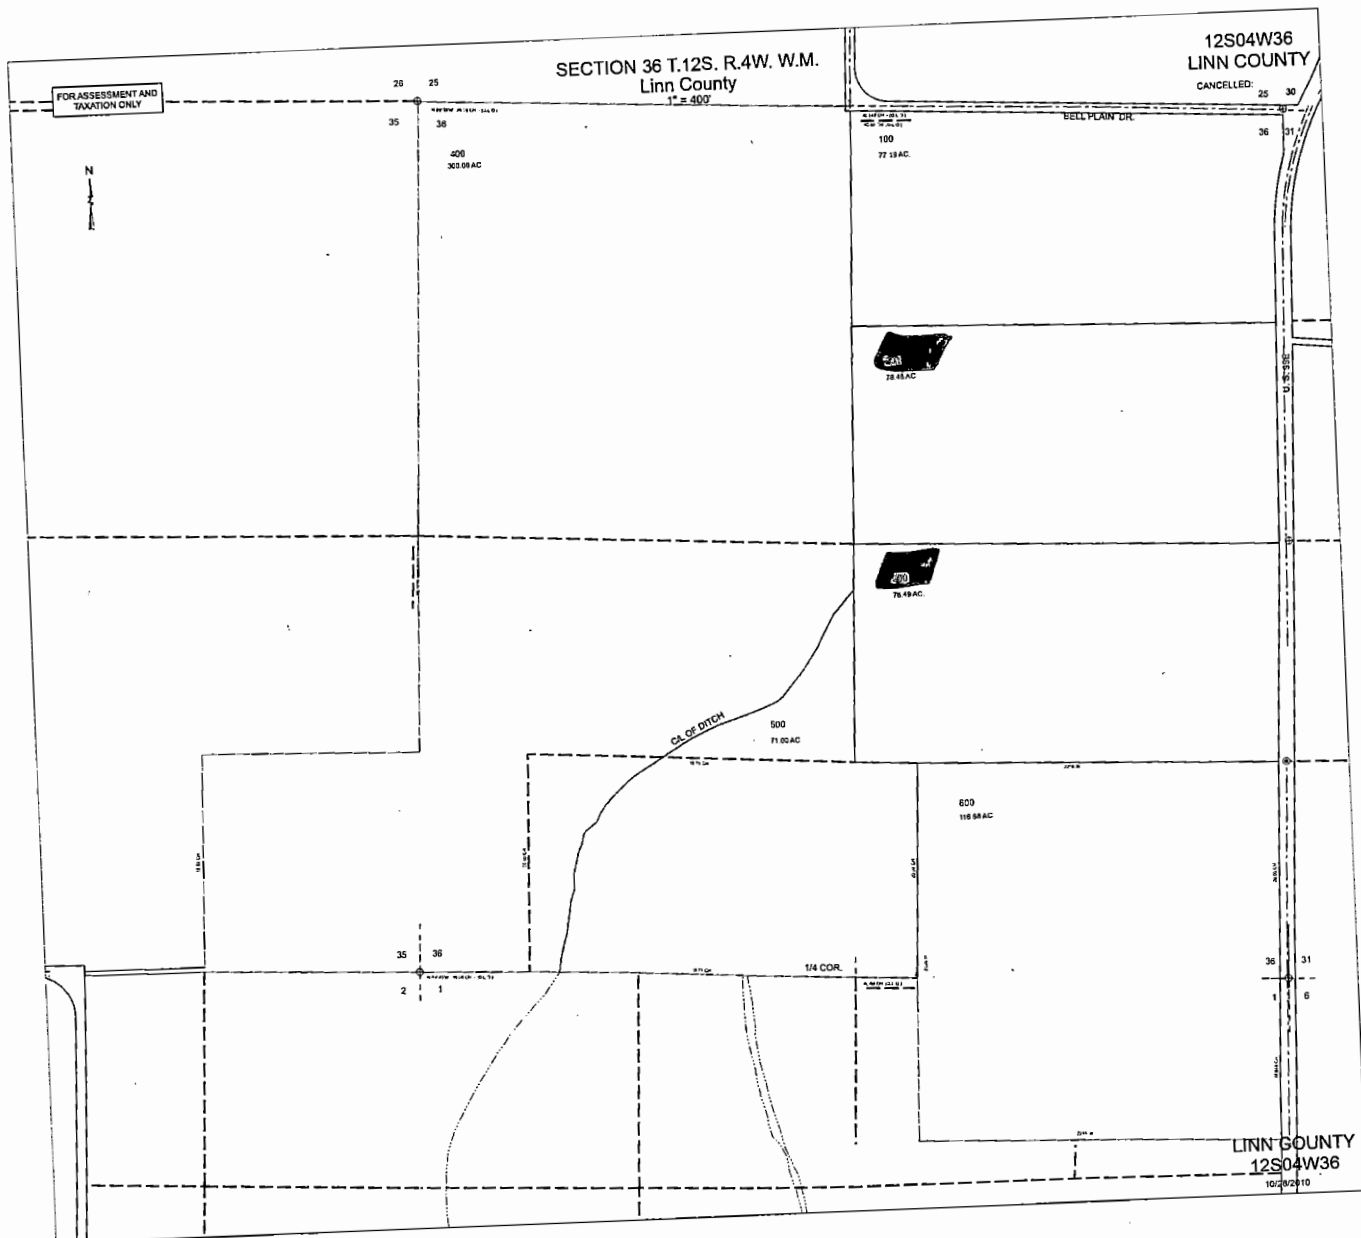

RECEIVED

OCT 19 2017

OWRD

G-18570