


Figure 1 & 2 Proposed Reservoirs

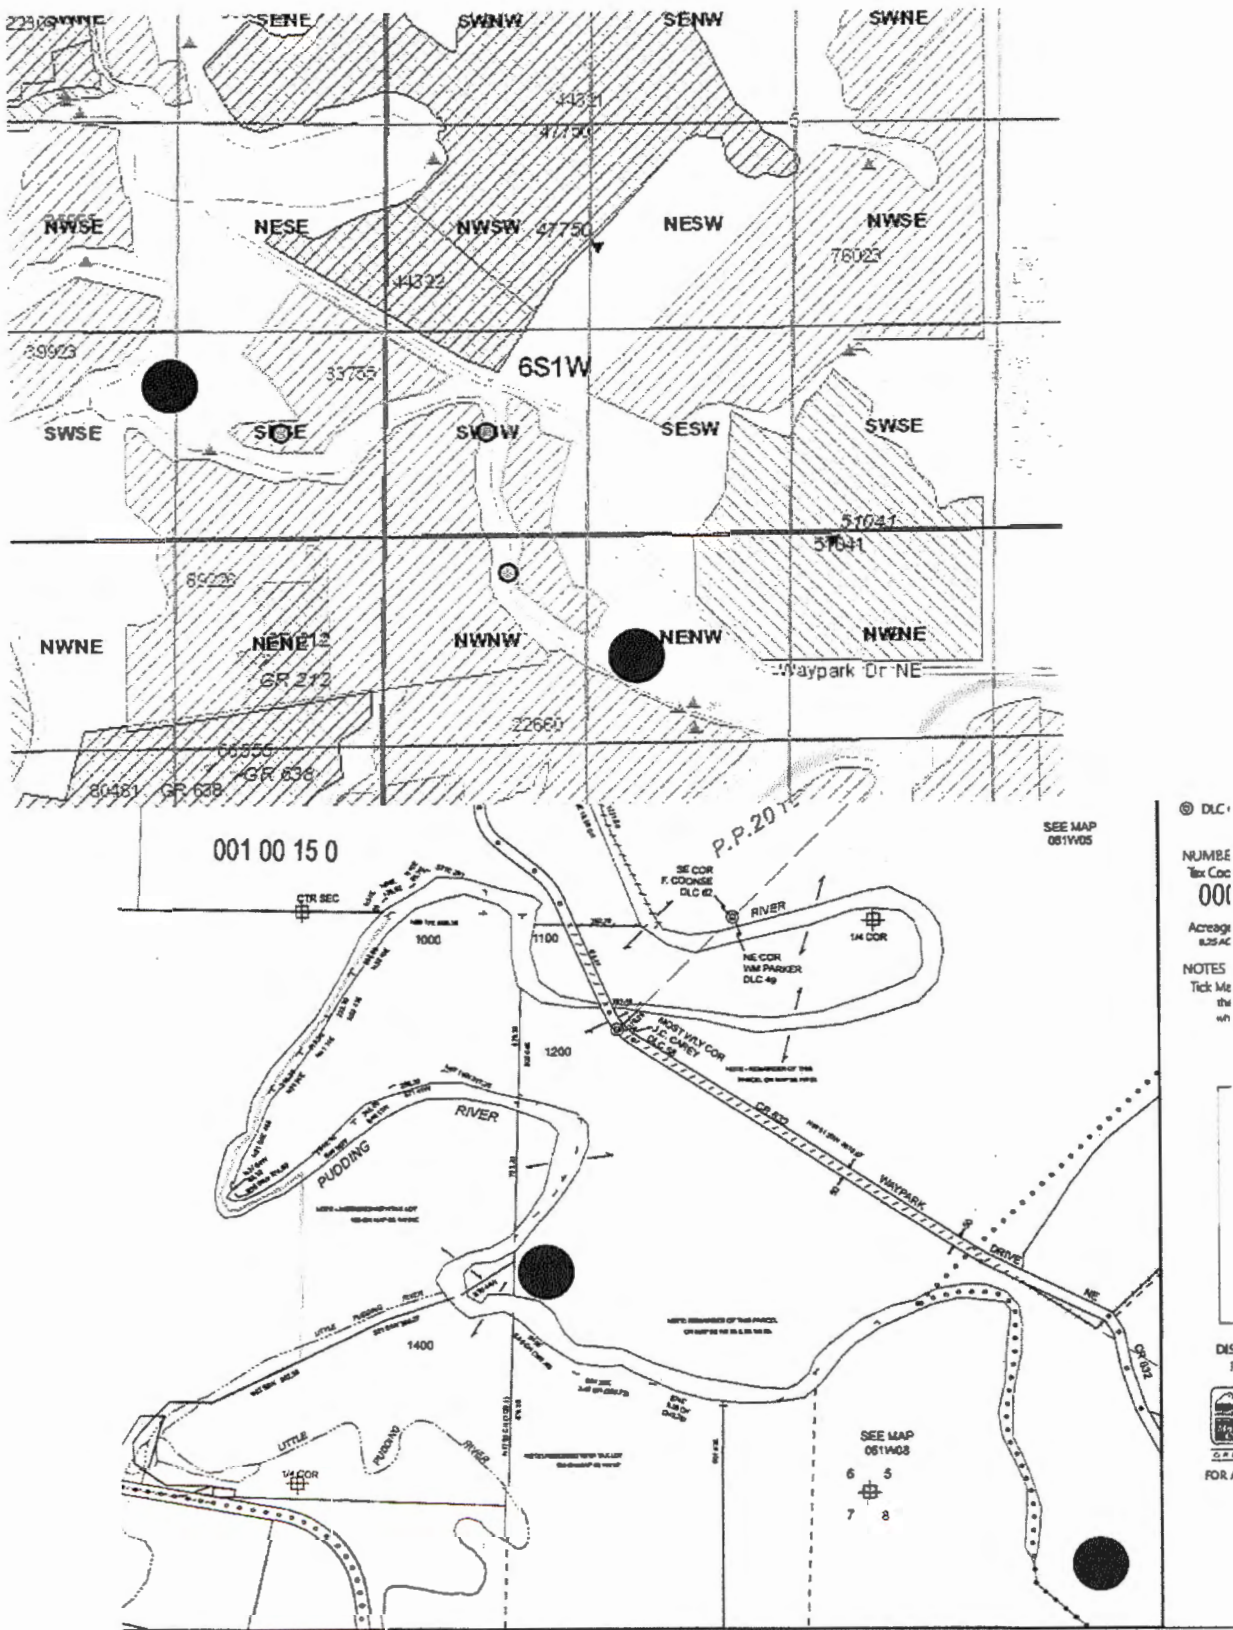

RECEIVED BY OWRD

Oregon Water Resources Department
Water Rights Mapping Tool

Main Help OWRD Only
Return Contact Us

Search

Identify Non-Water Right Features

Tax Lots

Tools

Layers

- Water Rights by Use
- Water Rights by Type
- Water Rights by Type-Use
- Water Rights by Prim./Suppl
- Irrigation Districts AOI
- Other Irrigation Districts
- Administrative Boundaries
- Rules
- Surface Water
- Hydrography
- Transportation
- Stream Gages
- Dams
- Exempt Use Wells (partial)
- PODs by Source Type
- Taxlots
- PLSS

Bookmarks

POD POU Irrigation Districts AOI WR By Time

Map Annotations:

- NESE, NWSW, NESW, SWSE, SESE, 6S1W, SWSW, SESE, NENE, NENW, NENE, NWNW
- 00600, 01600, 01400, 01800, 00700, 00100, 01701, 190
- HAZELNUT RES 2 (circled)
- HAZELNUT RES 1 (circled)
- REFERENCE CORNER (with arrow)
- RECEIVED BY OWRD
- OCT 16 2017
- SALEM, OR

Scale: 0 300 600ft

North Arrow: N, S, E, W

HAZELNUT RES 1
646 ft South From Reference Point AND 355 ft EAST FROM Reference Point.

HAZELNUT RES 2
2639 ft WEST FROM Reference Point AND 751 ft NORTH FROM Reference Point

R-SPUR 3