46833 GOODPASTURE ROAD VIDA OR 97488

TOWNSHIP 17S

RANGE 2E

SECTION 2

Q Q NE NE

MAP TAXLOT 200

PLAN DESIGNATION RR10

TAX ACCOUNT 0551687

IRRIGATION AREA CALCULATION

A = 11 x 285 = 3,135
B = 32 x 80 = 2,560
C = 34 x 48 = 1,632
D = 115 x 84 = 9,660
E = 49 x 51 = 2,397
F = 16 x 66 = 1,056
G = 50 x 167 = 8,350
H = 49 x 56 = 2,744
I = 30 x 38 = 1,140

32,674 / 43,560 = 0.75 acres

LEGEND

IRRIGATION

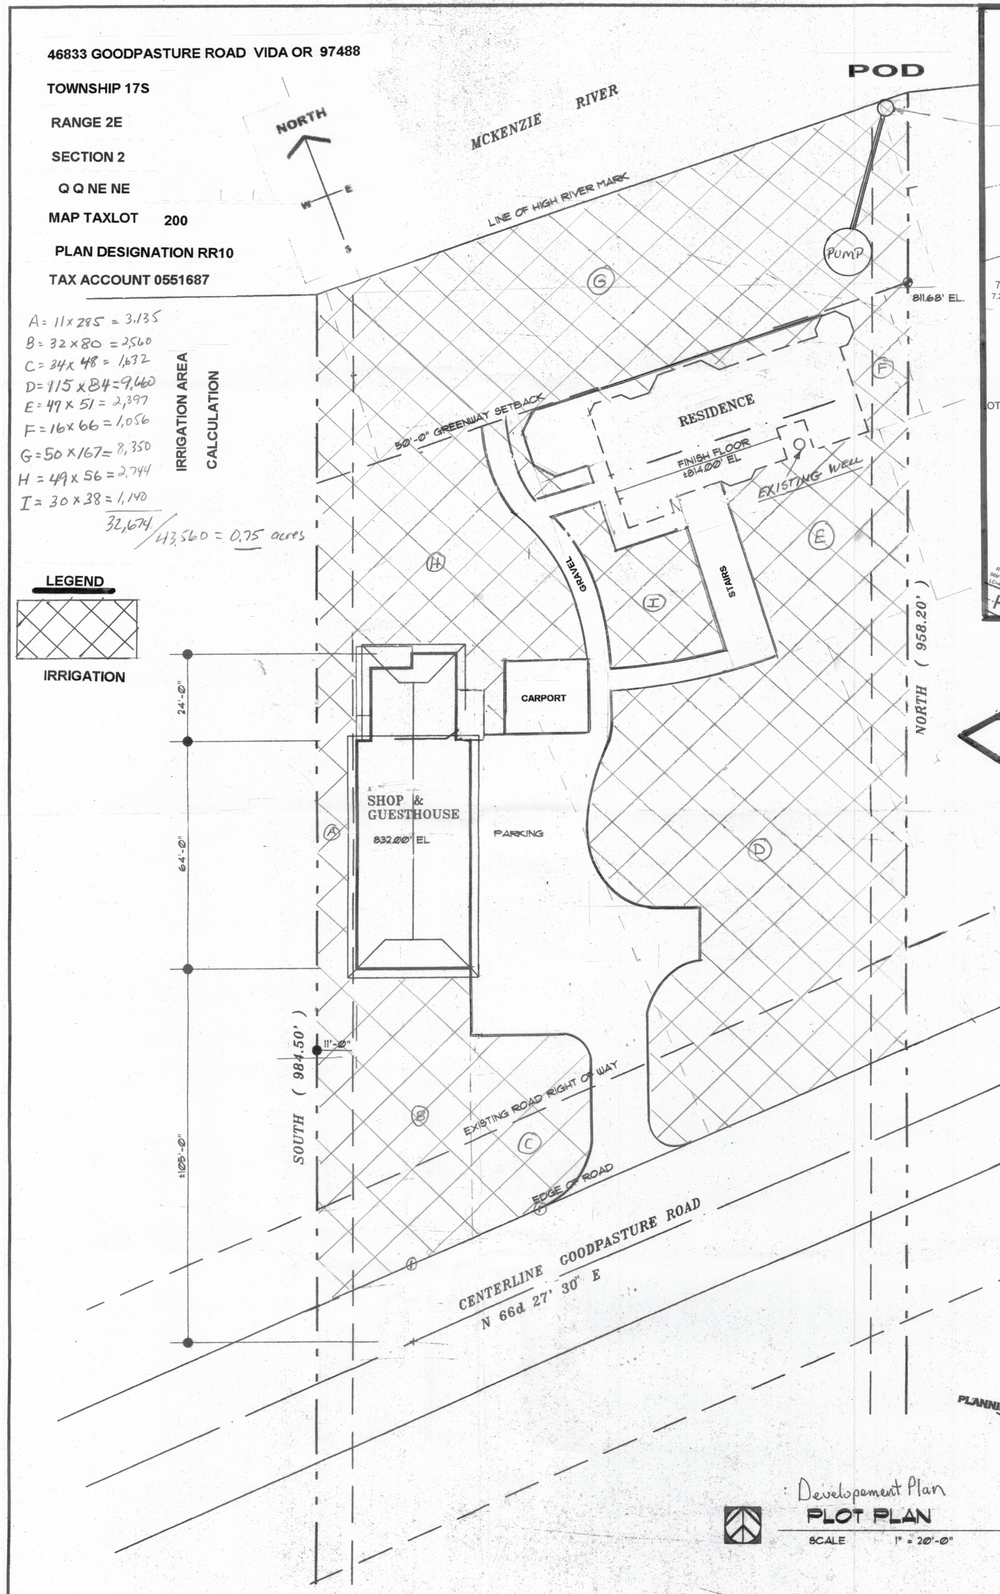

: Development Plan

PLOT PLAN

SCALE 1" = 20'-0"

N.E.1/4 SEC.2 T.17S. R.2E. W.M.
Lane County

SCALE → 1" = 200'

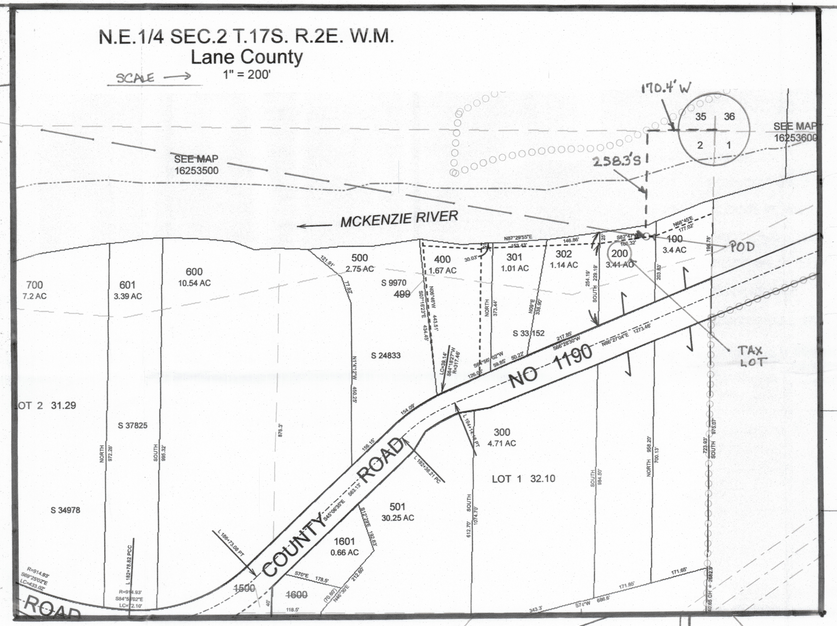

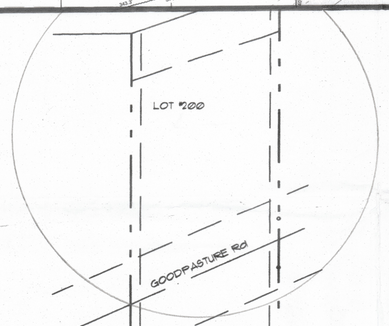

PLOT PLAN

SCALE NO SCALE

RECEIVED BY OWRD
OCT 16 2017
SALEM, OR

RECEIVED BY OWRD
OCT 16 2017
SALEM, OR

SOFT TECH
DESIGN & CONSTRUCTION
1873 GARDEN AVENUE
EUGENE, OR 97403
PHONE 503.484.5472

SITE PLAN

SCALE: 1" = 20'-0"

RESIDENCE and SHOP FOR
MARK AND SALLY BLAZE
46833 GOODPASTURE ROAD
VIDA, OREGON

JOB:
DATE: 08-02-93 JWT

A1

COPYRIGHT 1993

S-88468