


1703,
890
303
813

ANCE
LIC

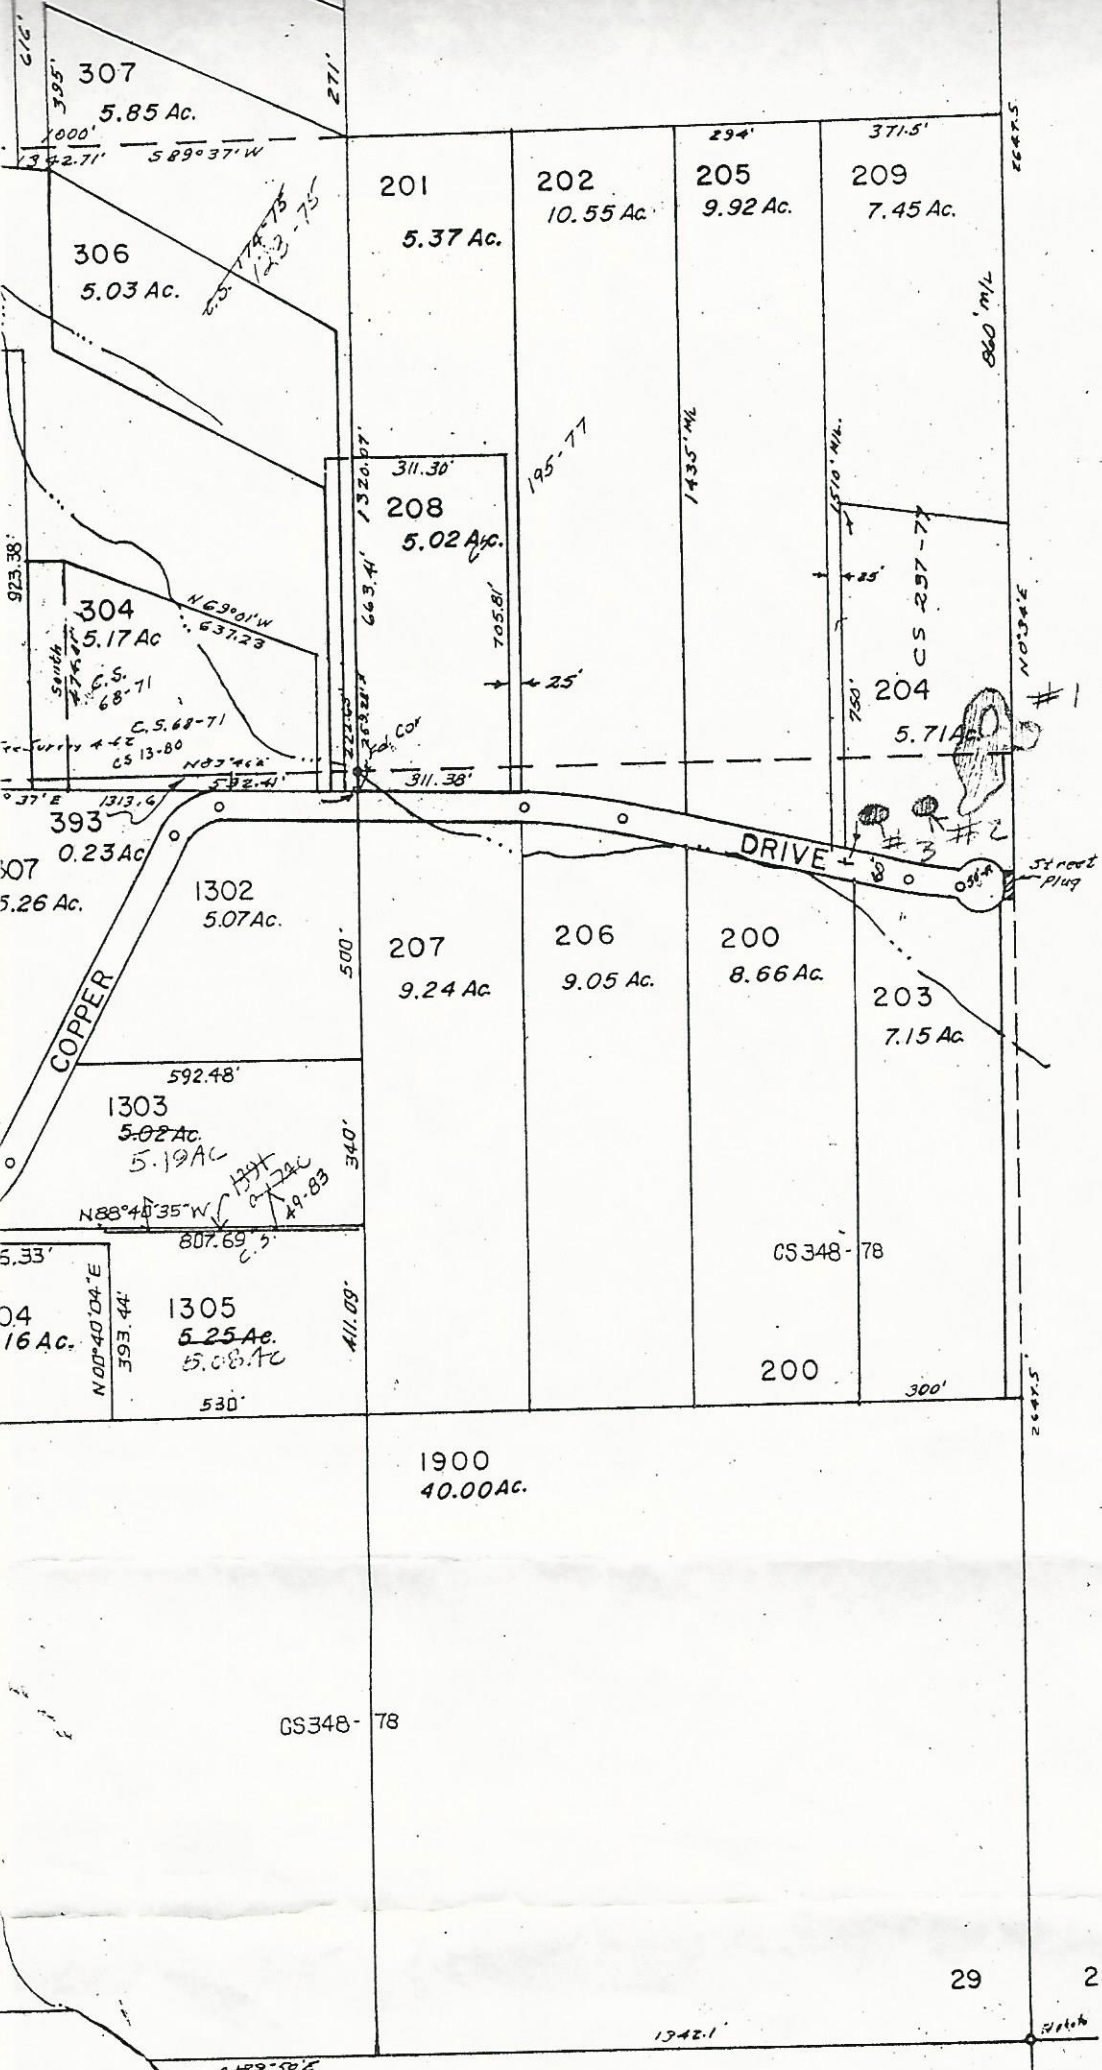

SEE MAP 37 5 28

THREE PONDS
TOTAL LESS
THAN 6 ACRES
WATER

29 28