


Cobu Map 880

880

KNAPP SPRINGS: 1050' W & 1285' S, NE COR SEC 34, T 8 N, R 6 W, WM

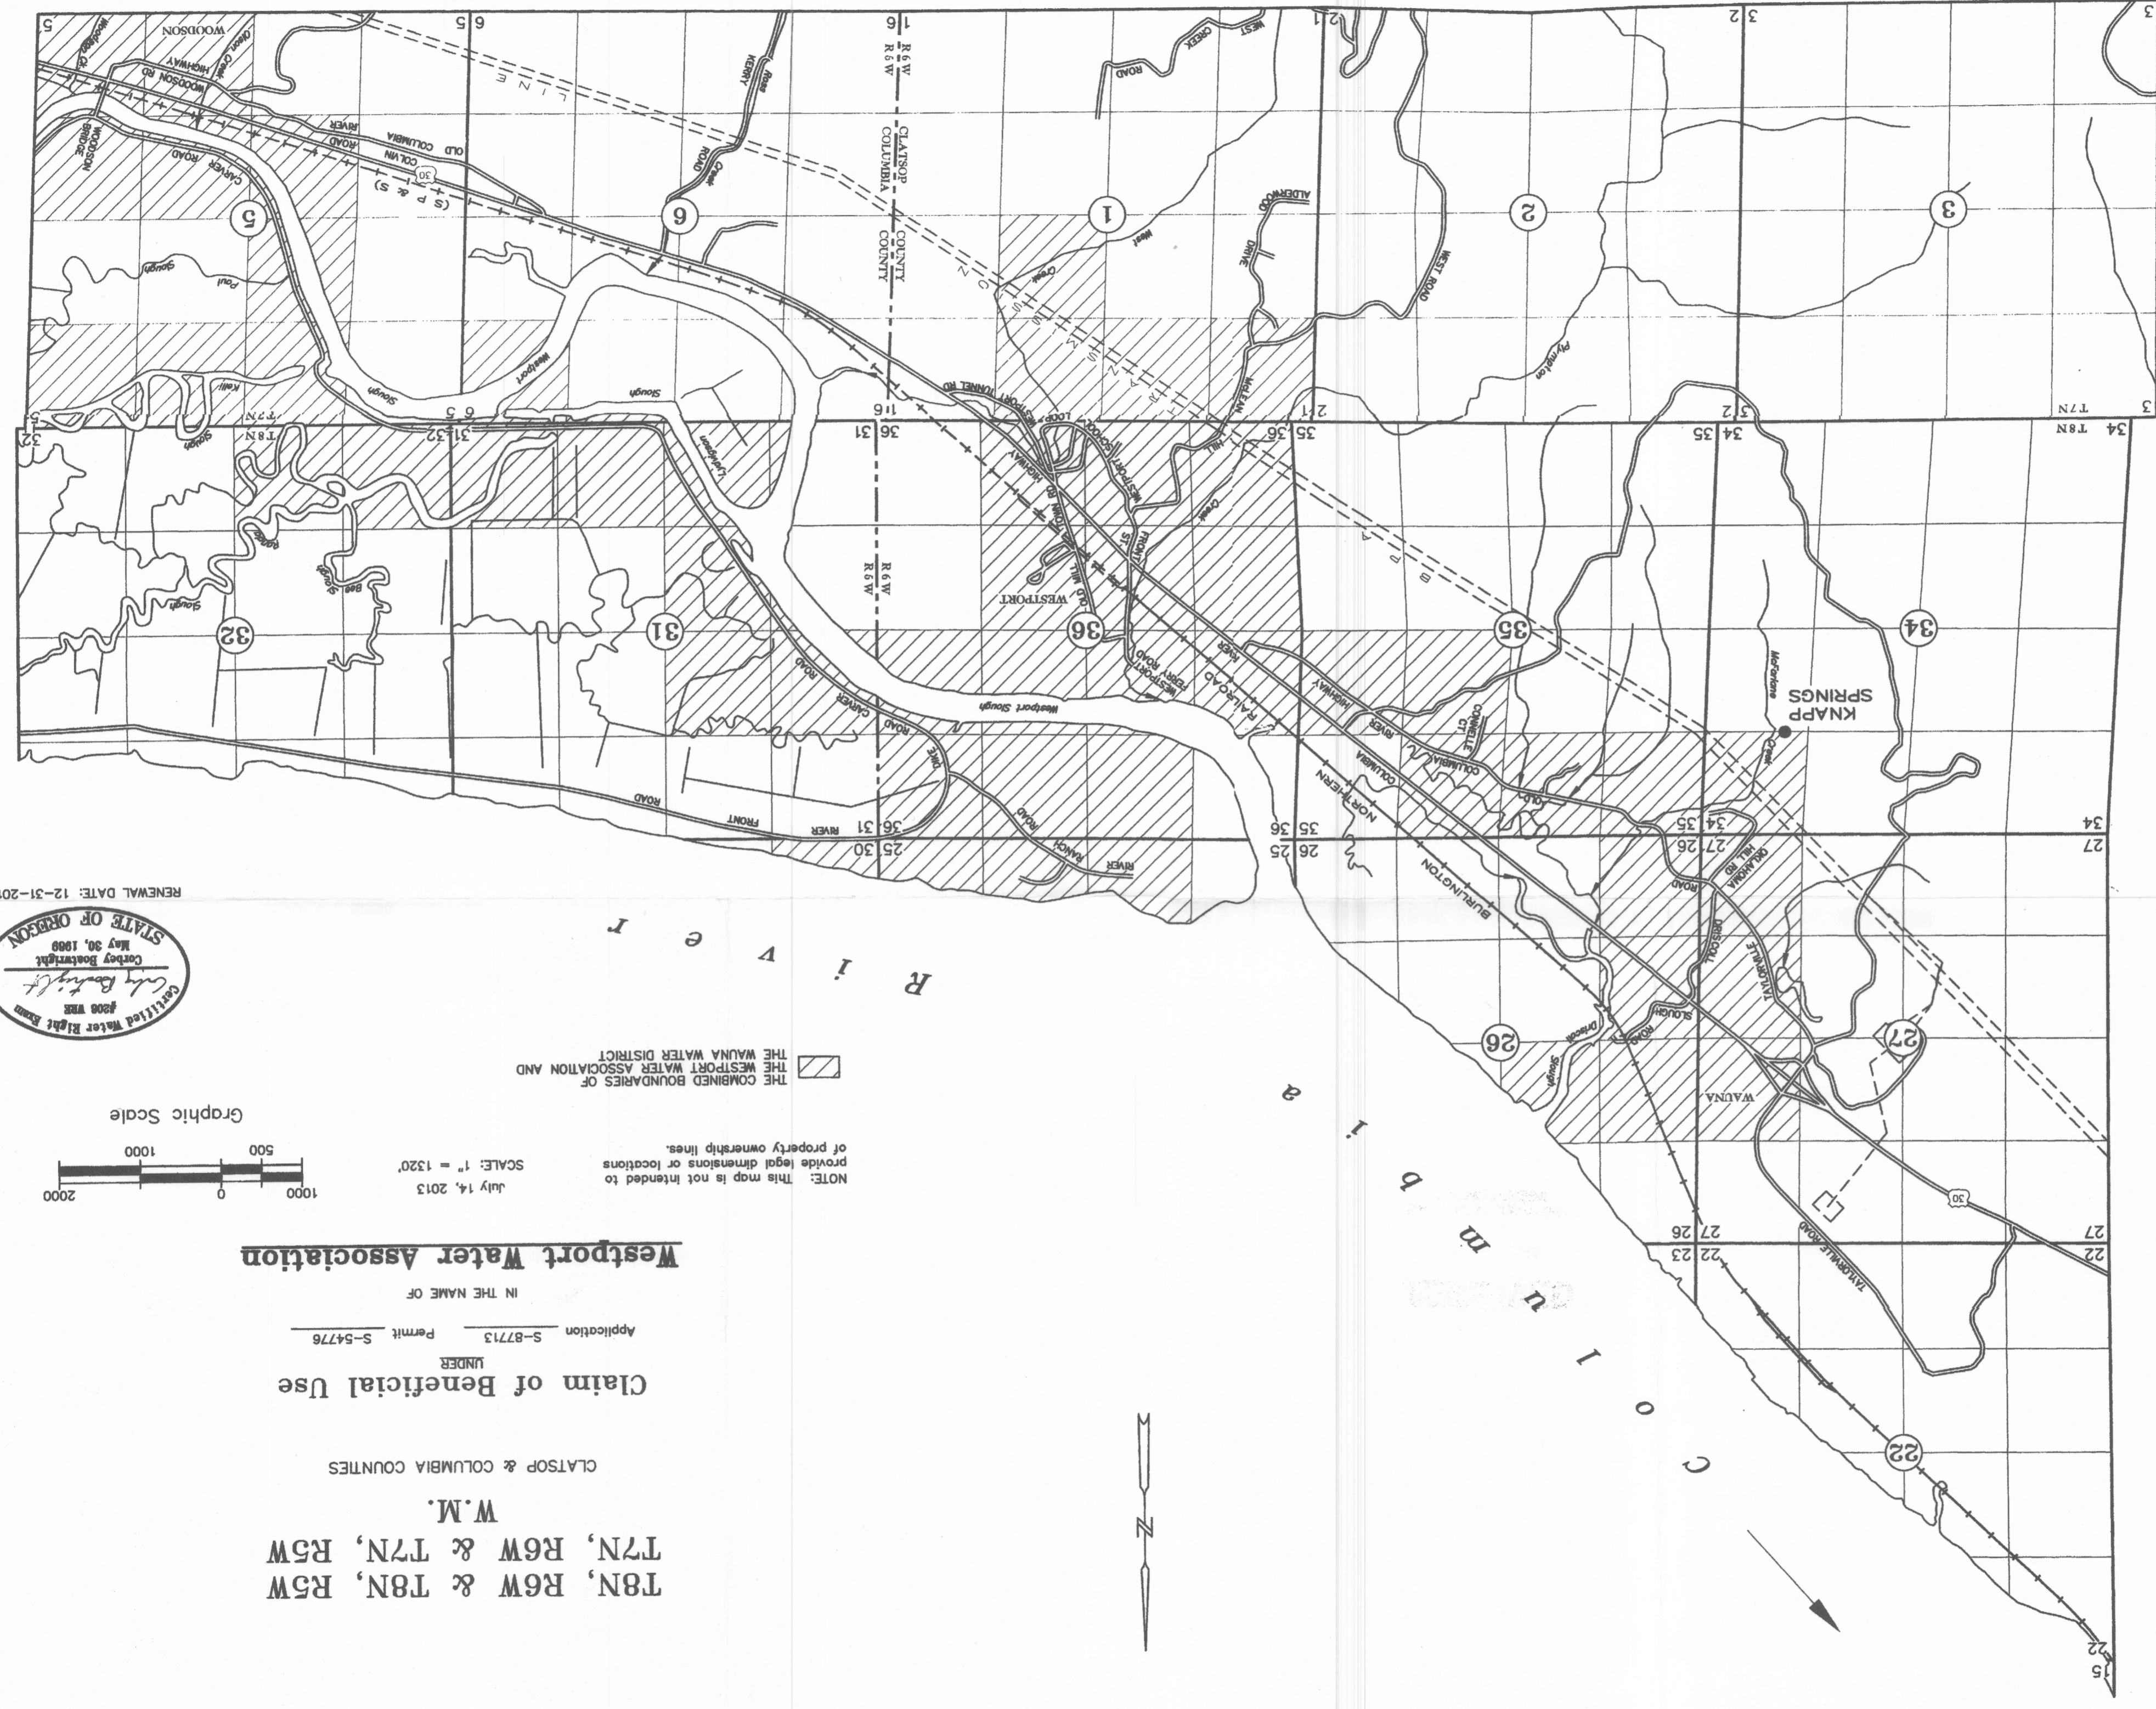

**T8N, R6W & T8N, R5W**  
**T7N, R6W & T7N, R5W**  
**W.M.**  
 CLATSOP & COLUMBIA COUNTIES


**Claim of Beneficial Use**  
 UNDER  
 Application S-87713 Permit S-54776

IN THE NAME OF

**Westport Water Association**

NOTE: This map is not intended to provide legal dimensions or locations of property ownership lines.

July 14, 2013  
 SCALE: 1" = 1320'

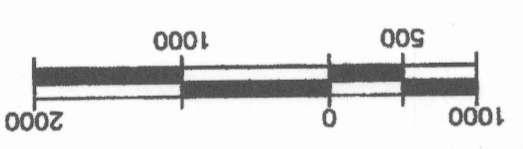

THE COMBINED BOUNDARIES OF THE WESTPORT WATER ASSOCIATION AND THE WAUNA WATER DISTRICT



RENEWAL DATE: 12-31-2015