

HB 2376 EXEMPT NOTICE
COMPLETENESS CHECKLIST

- Landowner name and address*
- A. County of use
- B. River basin
- C. Legal description of reservoir location*
(Includes quarter-quarter section and tax lot)
- D. Reservoir name
- E. Date of construction
- F. Source of water and tributary*
- G. Dam height
- H. Quantity of water stored*
- I. Use of water
- J. Rate and area of use (if any)
- Signature of Landowner/agent
- Map showing Township, Range, Section, Quarter-quarter section and Tax Lot* and general location of pond.

Date Received 01/29/97

Received By Lanny Powers

* MINIMUM REQUIREMENT TO FILE

C:\wp51\pondchk

P-82603



Oregon Water Resources Department Notice of Exempt Reservoir

For reservoirs built before January 1, 1995, that

- Store less than 9.2 acre-feet of water, or
- Have a dam less than 10 feet high.

The deadline for submitting a Notice of Exempt Reservoir is January 31, 1997.

Landowner: Schultz, Vernon J
Last name First name MI

Authorized Agent: _____
Last name First name MI

Address: 4285 Hopkins Road
Ontario OR 97914
City State Zip

Phone: 541-889-3966 541-869-2474
Home Work

FAX: 541-889-9644 E-Mail Address: _____

A. County of use: Malheur . B. River basin (see reverse): 10

C. Legal description of reservoir location:

Township	Range	Section	Quarter/Quarter	Tax Lot #
<u>17S</u>	<u>46E</u>	<u>35</u>	<u>NE NE</u>	<u>4800</u>

D. Name, if any, of reservoir: Schultz . E. Reservoir in existence since: Pre 1950
MM DD YY

F. Source of water: Winter Run off Irrigation Run off which flows into Un-named stream
Name of river or creek Name of river or creek
trib to Malheur River

G. Maximum height of dam: 9 feet.

H. Quantity of water stored in reservoir at maximum capacity (see reverse): 0.50 acre-feet.

I. Water stored in reservoir is used for (see reverse): Stockwater

J. Rate and area of use—Refer to chart on the back of this form. For each type of water use listed in Item I., show the quantity of water used and, if applicable, the number of acres on which water is used.

BEFORE YOU SIGN AND SUBMIT THIS APPLICATION . . . HAVE YOU:


Answered each question on this form as completely as possible?

Attached a legible map showing township, section, range, quarter-quarter & tax lot number?

By my signature below, I swear that all statements made and information provided in this application are true to the best of my knowledge.

Vernon Jay Schultz (Signature of Landowner/Agent) Vernon Jay Schultz owner (Printed name and title) 1-29-97 (Date)

For Department Use: P-82603 File # _____ Date received _____ 10-95

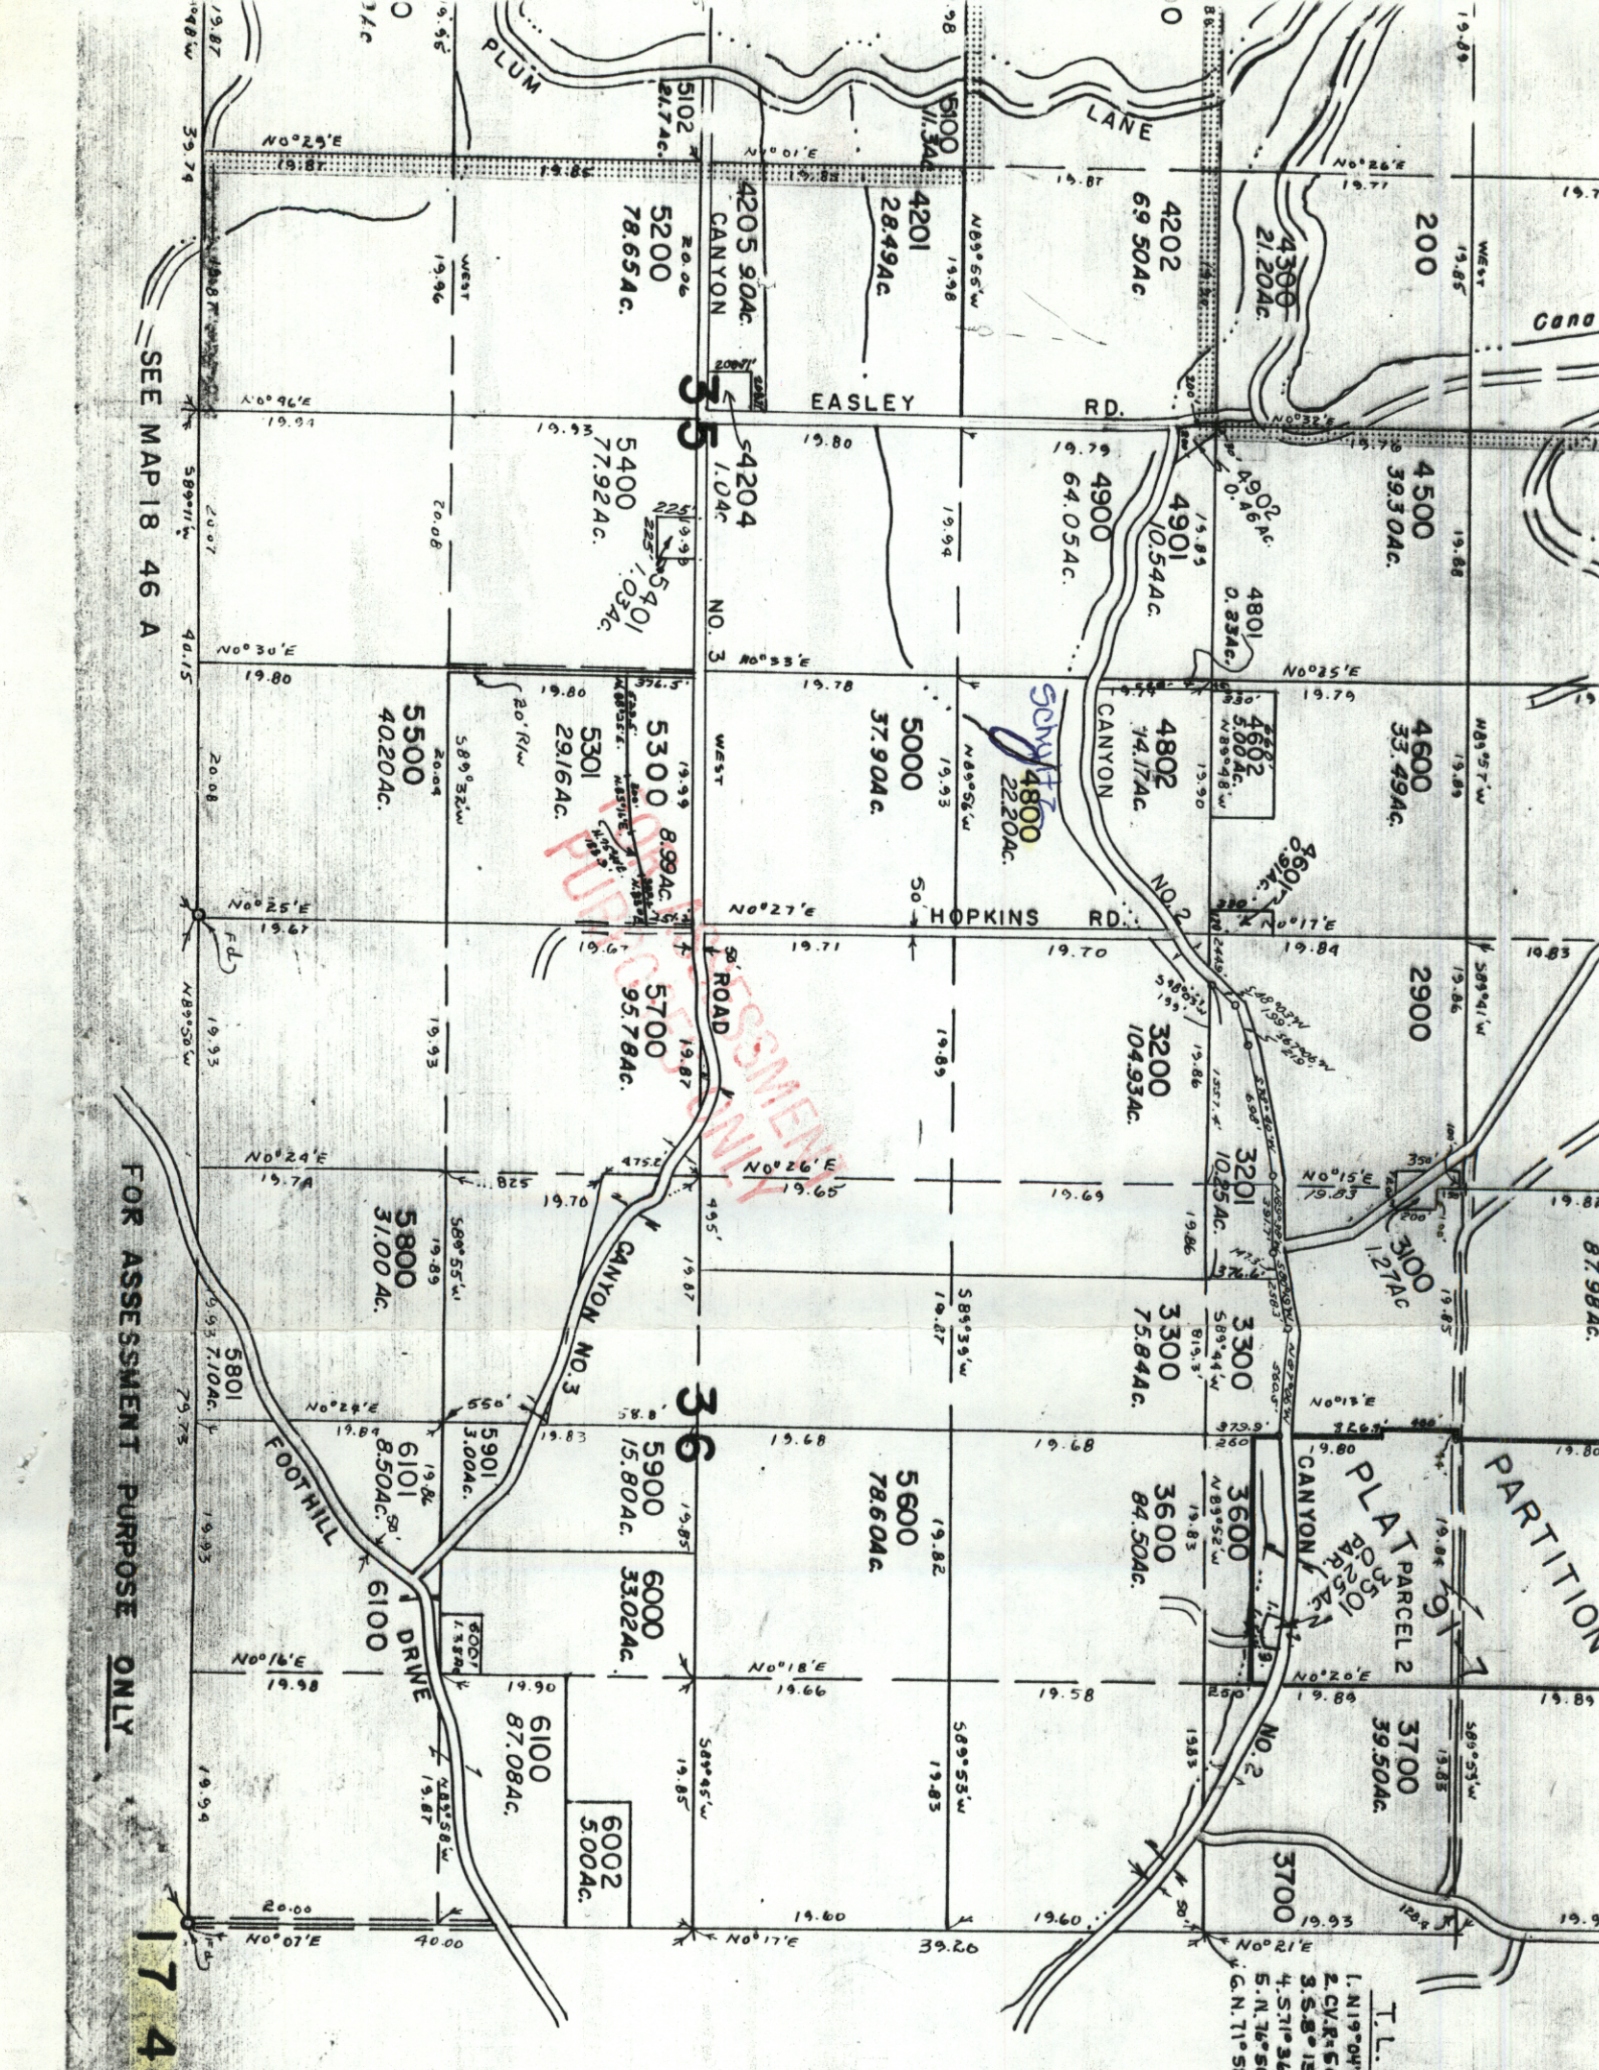

SEE MAP 18 46 A

FOR ASSESSMENT PURPOSE ONLY

17 46


- T.L. 3
1. N 19° 04' 44" W
 2. S 17° 56' 55" E
 3. S 8° 15' 1" E
 4. S 71° 36' 2" E
 5. N 76° 50' 11" W
 6. N 71° 58' 1" E