


T. 4 S. R. 3 W. W. M.

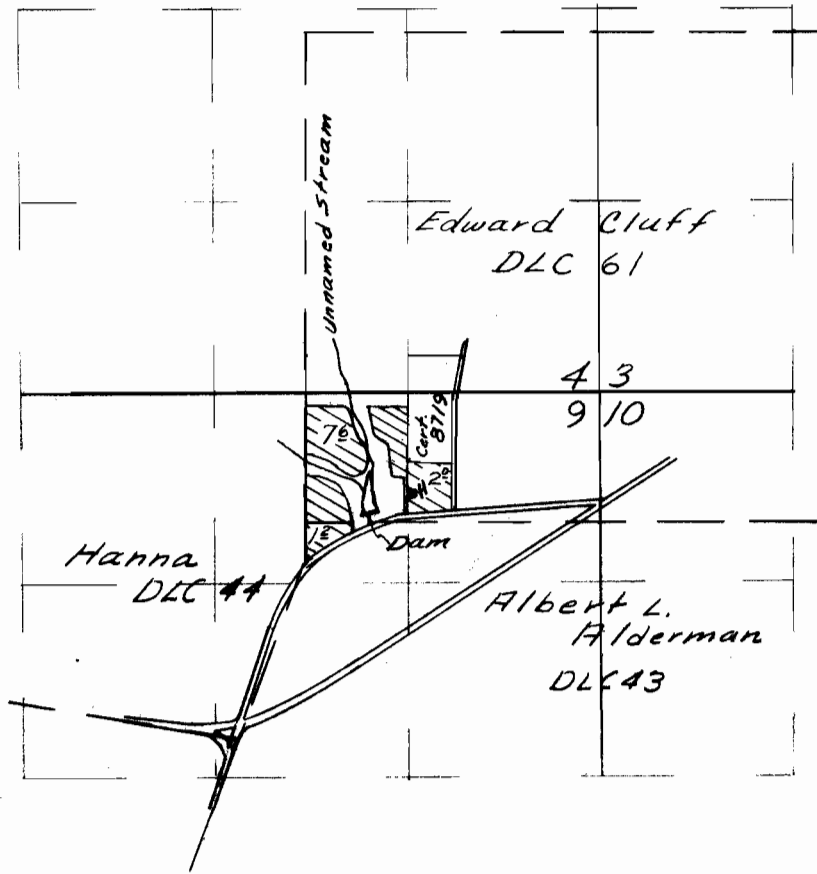

Final Proof Survey
Under

Application No. 22165 Permit No. 17453
In Name Of

H. B. Lichtenthaler

Surveyed June 7 1955 by T. Jones

DFQ-2D-2A

CB