


T39S R8W Southeast Quarter Section 22

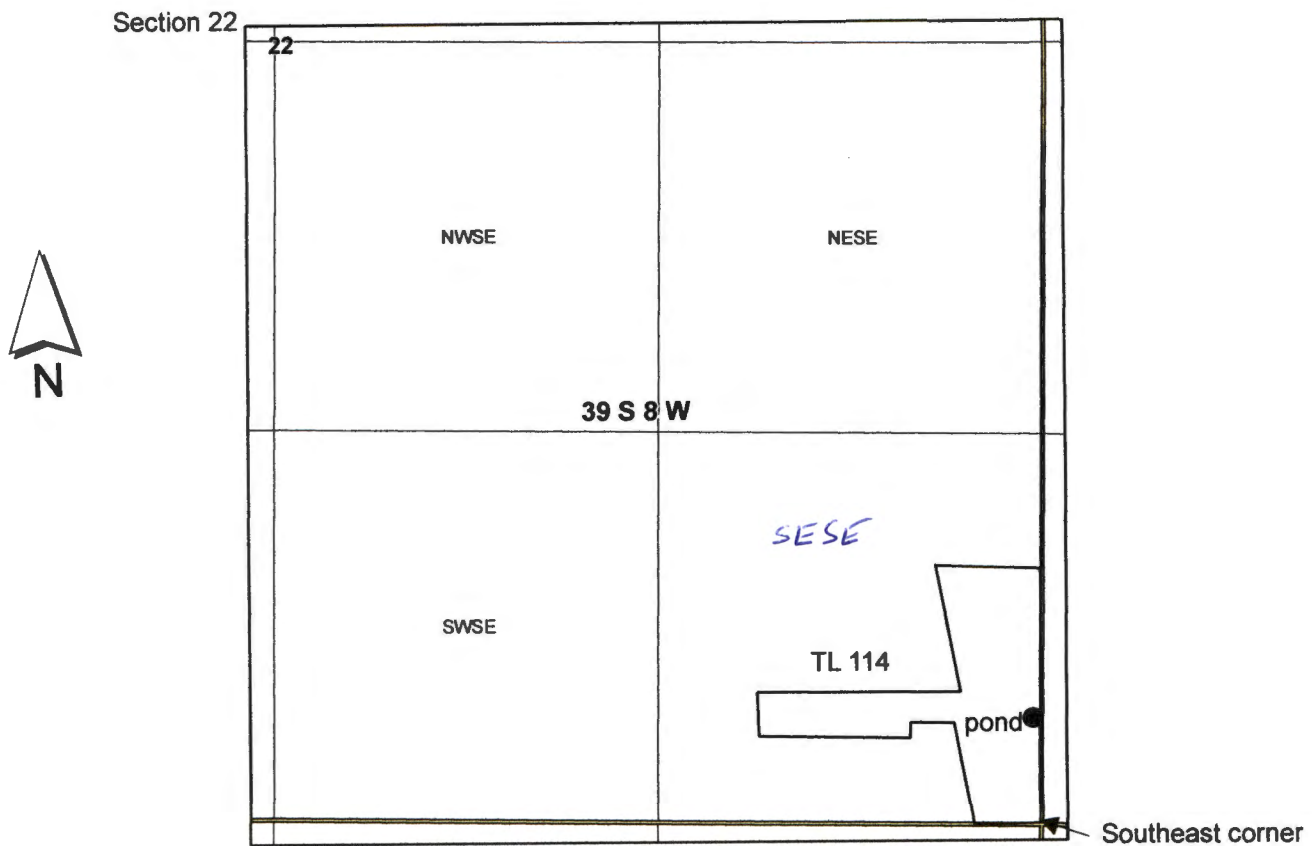

1 inch = 660 feet

The pond is located approximately 366 ft north
and 30 ft west of the southeast corner of Section 22.

RECEIVED BY OWRD

NOV 01 2017

SALEM, OR

R-88474