



Application: 13011  
Permit:

T22S, R10W, WM  
SCALE 1" = 1320'


WATER RIGHT APPLICATION MAP

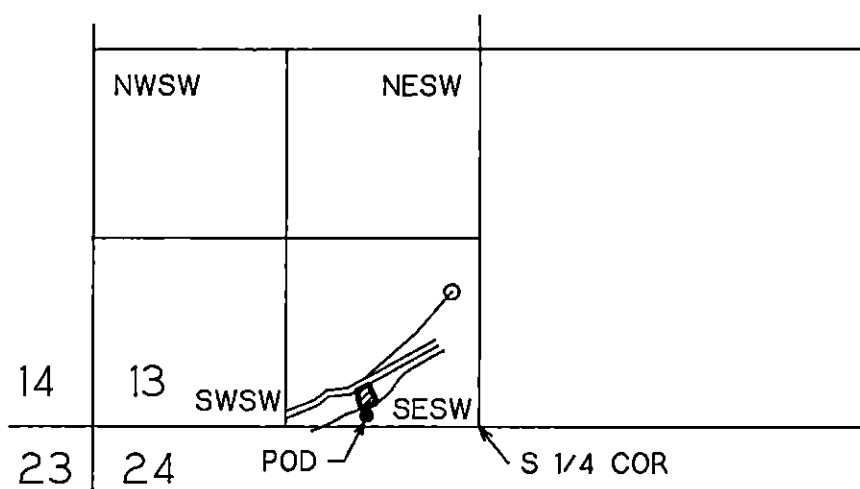

SPRING  
APPLICATION NO 16565  
PERMIT NO 12349

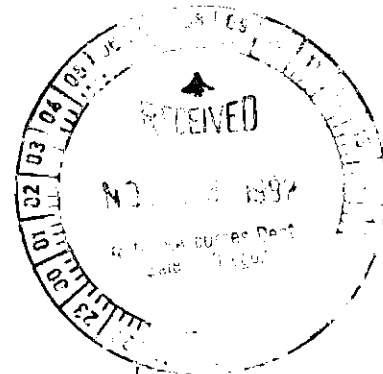


DETAIL  
SCALE 1" = 200'

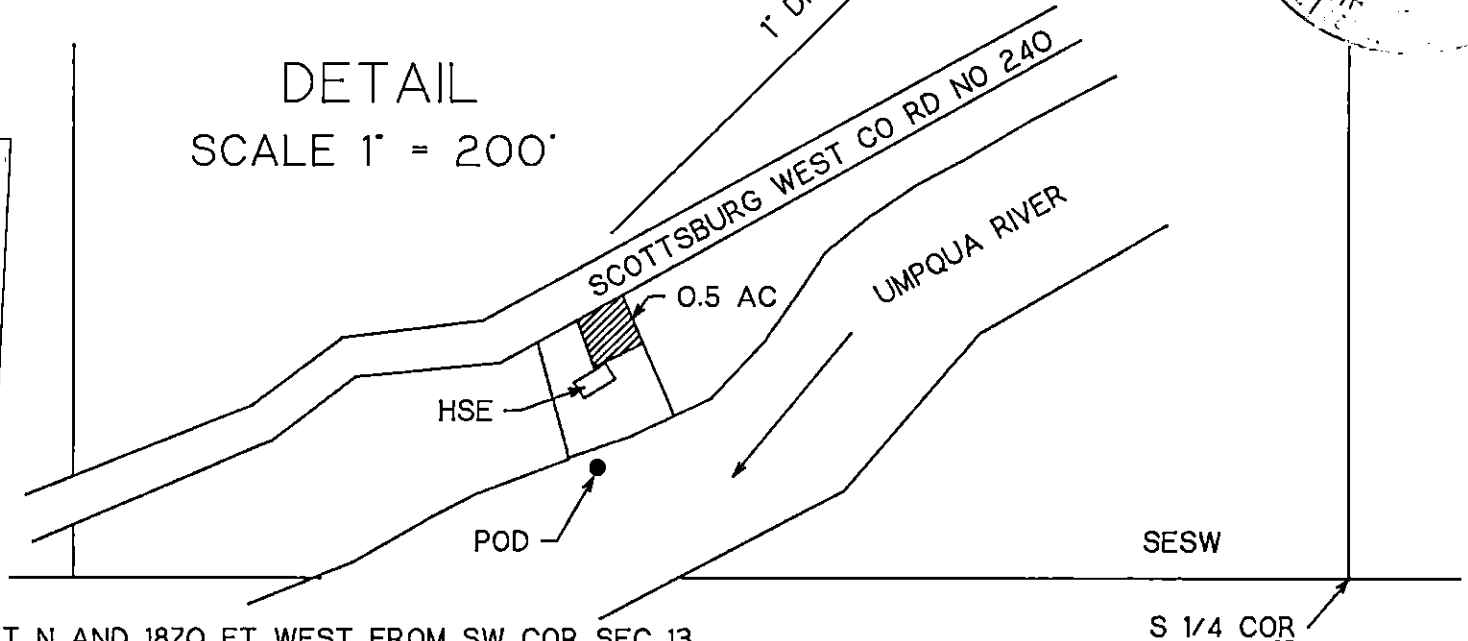

Should be East  
Bad map  
RML 10-21-93

POD IS 90 FT N AND 1870 FT WEST FROM SW COR SEC 13

THIS IS A LOCATION MAP FOR A WATER RIGHT APPLICATION BY NICK OR ESTHER NICASTRO. THIS MAP IS FOR THE PURPOSE OF IDENTIFYING THE LOCATION OF THE WATER RIGHT ONLY AND IS NOT INTENDED TO PROVIDE LEGAL DIMENSIONS OR LOCATIONS OF PROPERTY OWNERSHIP LINES.

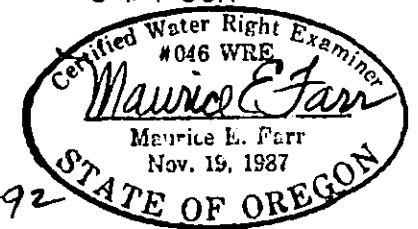


11-92

WATER RIGHT APPLICATION MAP

Application Permit: 13011



T522, R10W, WM

SCALE 1" = 1350'

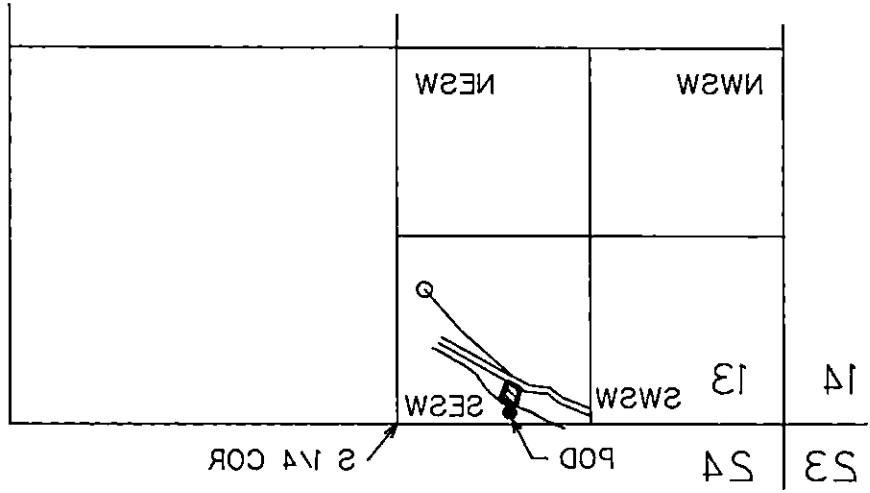



DETAIL

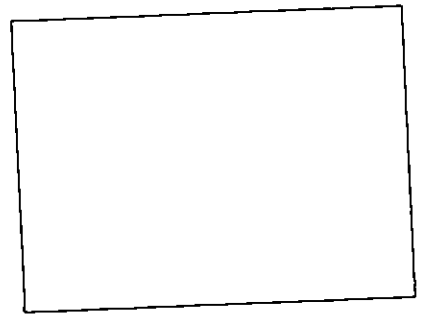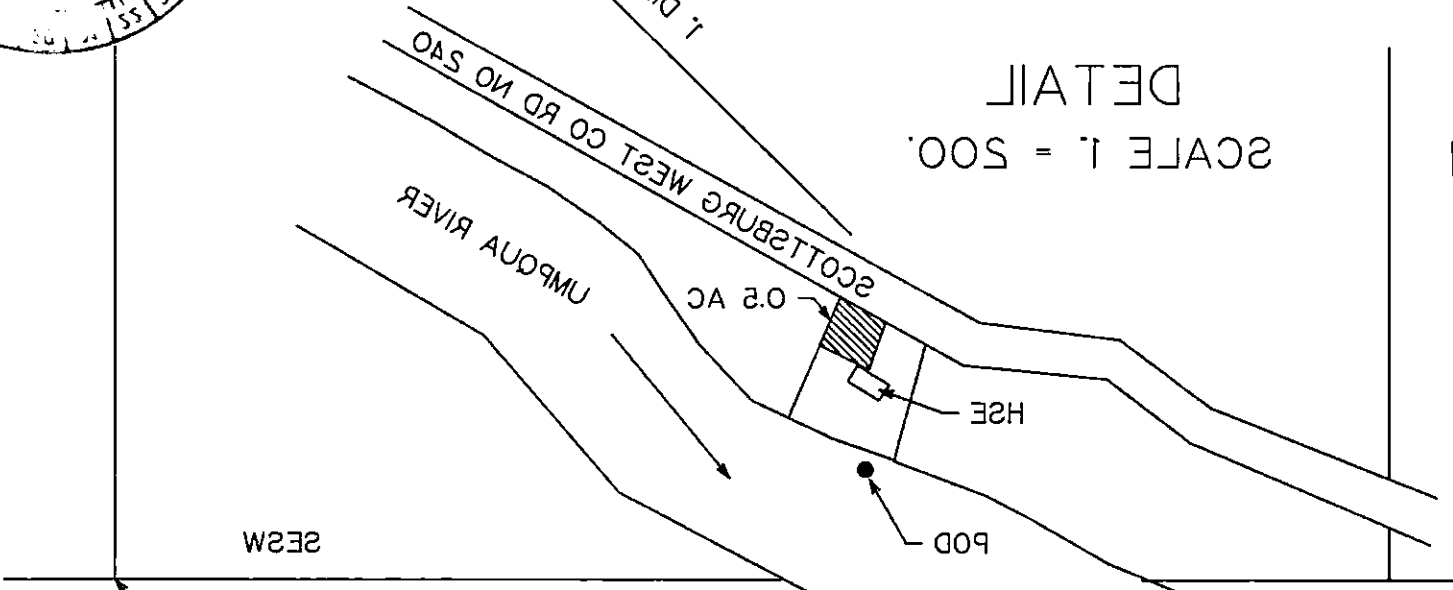

SPRING APPLICATION NO 16562  
PERMIT NO 15349

1" DIAMETER SUPPLY LINE

POD IS 90 FT N AND 1870 FT WEST FROM SW COR SEC 13  
OR LOCATIONS OF PROPERTY OWNERSHIP LINES.  
THE WATER RIGHT ONLY AND IS NOT INTENDED TO PROVIDE LEGAL DIMENSIONS  
FOR THE PURPOSE OF IDENTIFYING THE LOCATION OF  
NICAstro. THIS MAP IS FOR THE PURPOSE OF IDENTIFYING THE LOCATION OF  
THIS IS A LOCATION MAP FOR A WATER RIGHT APPLICATION BY NICK OR ESTHER

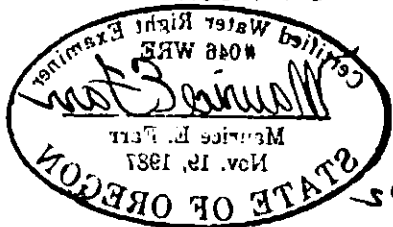

11-95